


RESERVATION
5 ACRES

FRANCIS HUBER

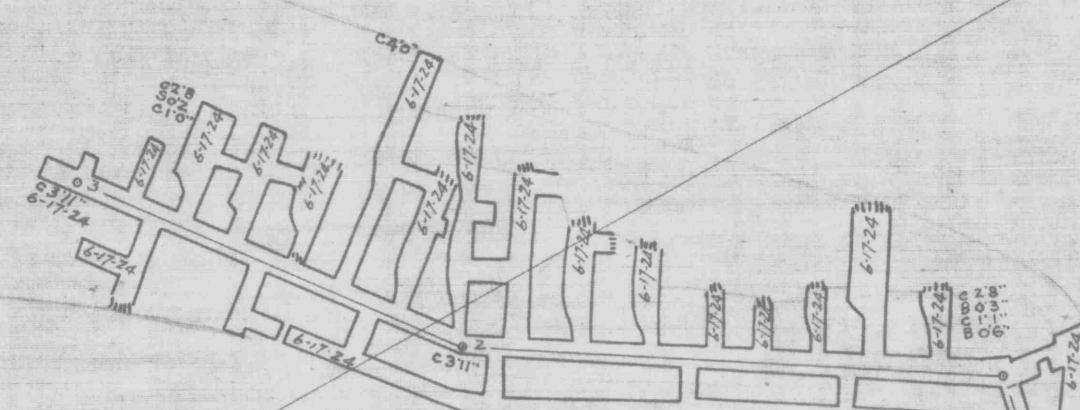

OUTCROP

BED

ALBERT J. McMULLEN

HERMAN KIRKPATRICK

JOSEPH McMULLEN

PENNSYLVANIA COAL & COKE CORPORATION	
J. HARRISON WESTOVER MINE	
"E" SEAM	
ELDER TOWNSHIP, CAMBRIA COUNTY, PA.	
ENGINEERING DEPARTMENT PATTON, PA.	
DRAWN BY <u>D.W.C.</u>	SCALE <u>1"=100'</u>
TRACED BY <u>D.W.C.</u>	DATE <u>July-8-1924</u>
CHECKED BY _____	REVISED _____
APPROVED _____	" _____
SHEETS _____	DRAWING NO. P-6-3-6
SHEET NO. _____	