


2578

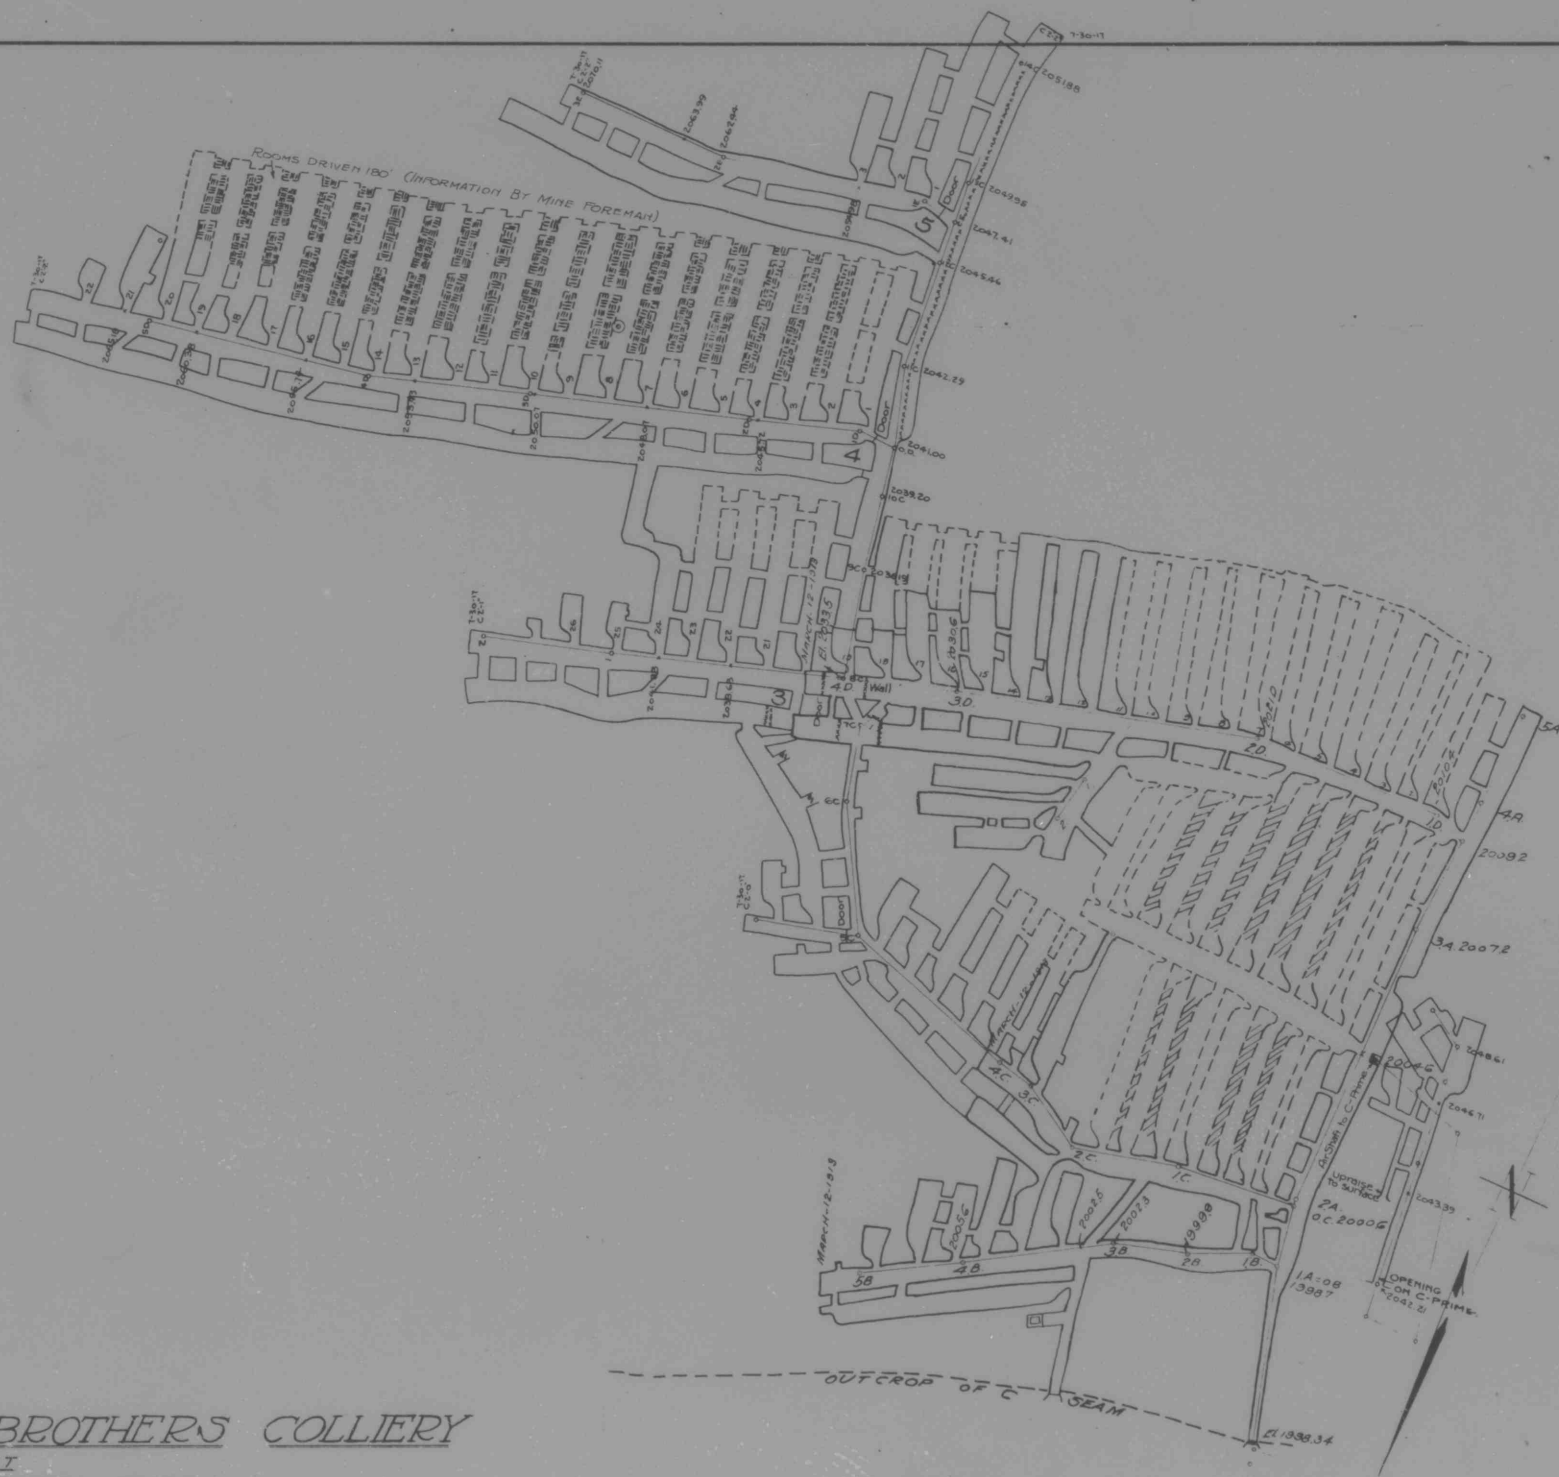

MAP OF BROWN BROTHERS COLLIERY

AI

MOUNTAINDALE - CAMBRIA CO. PA.

SCALE = 1" = 100'

J. S. SILLYMAN & CO.  
ENGINEERS

2578