B-7

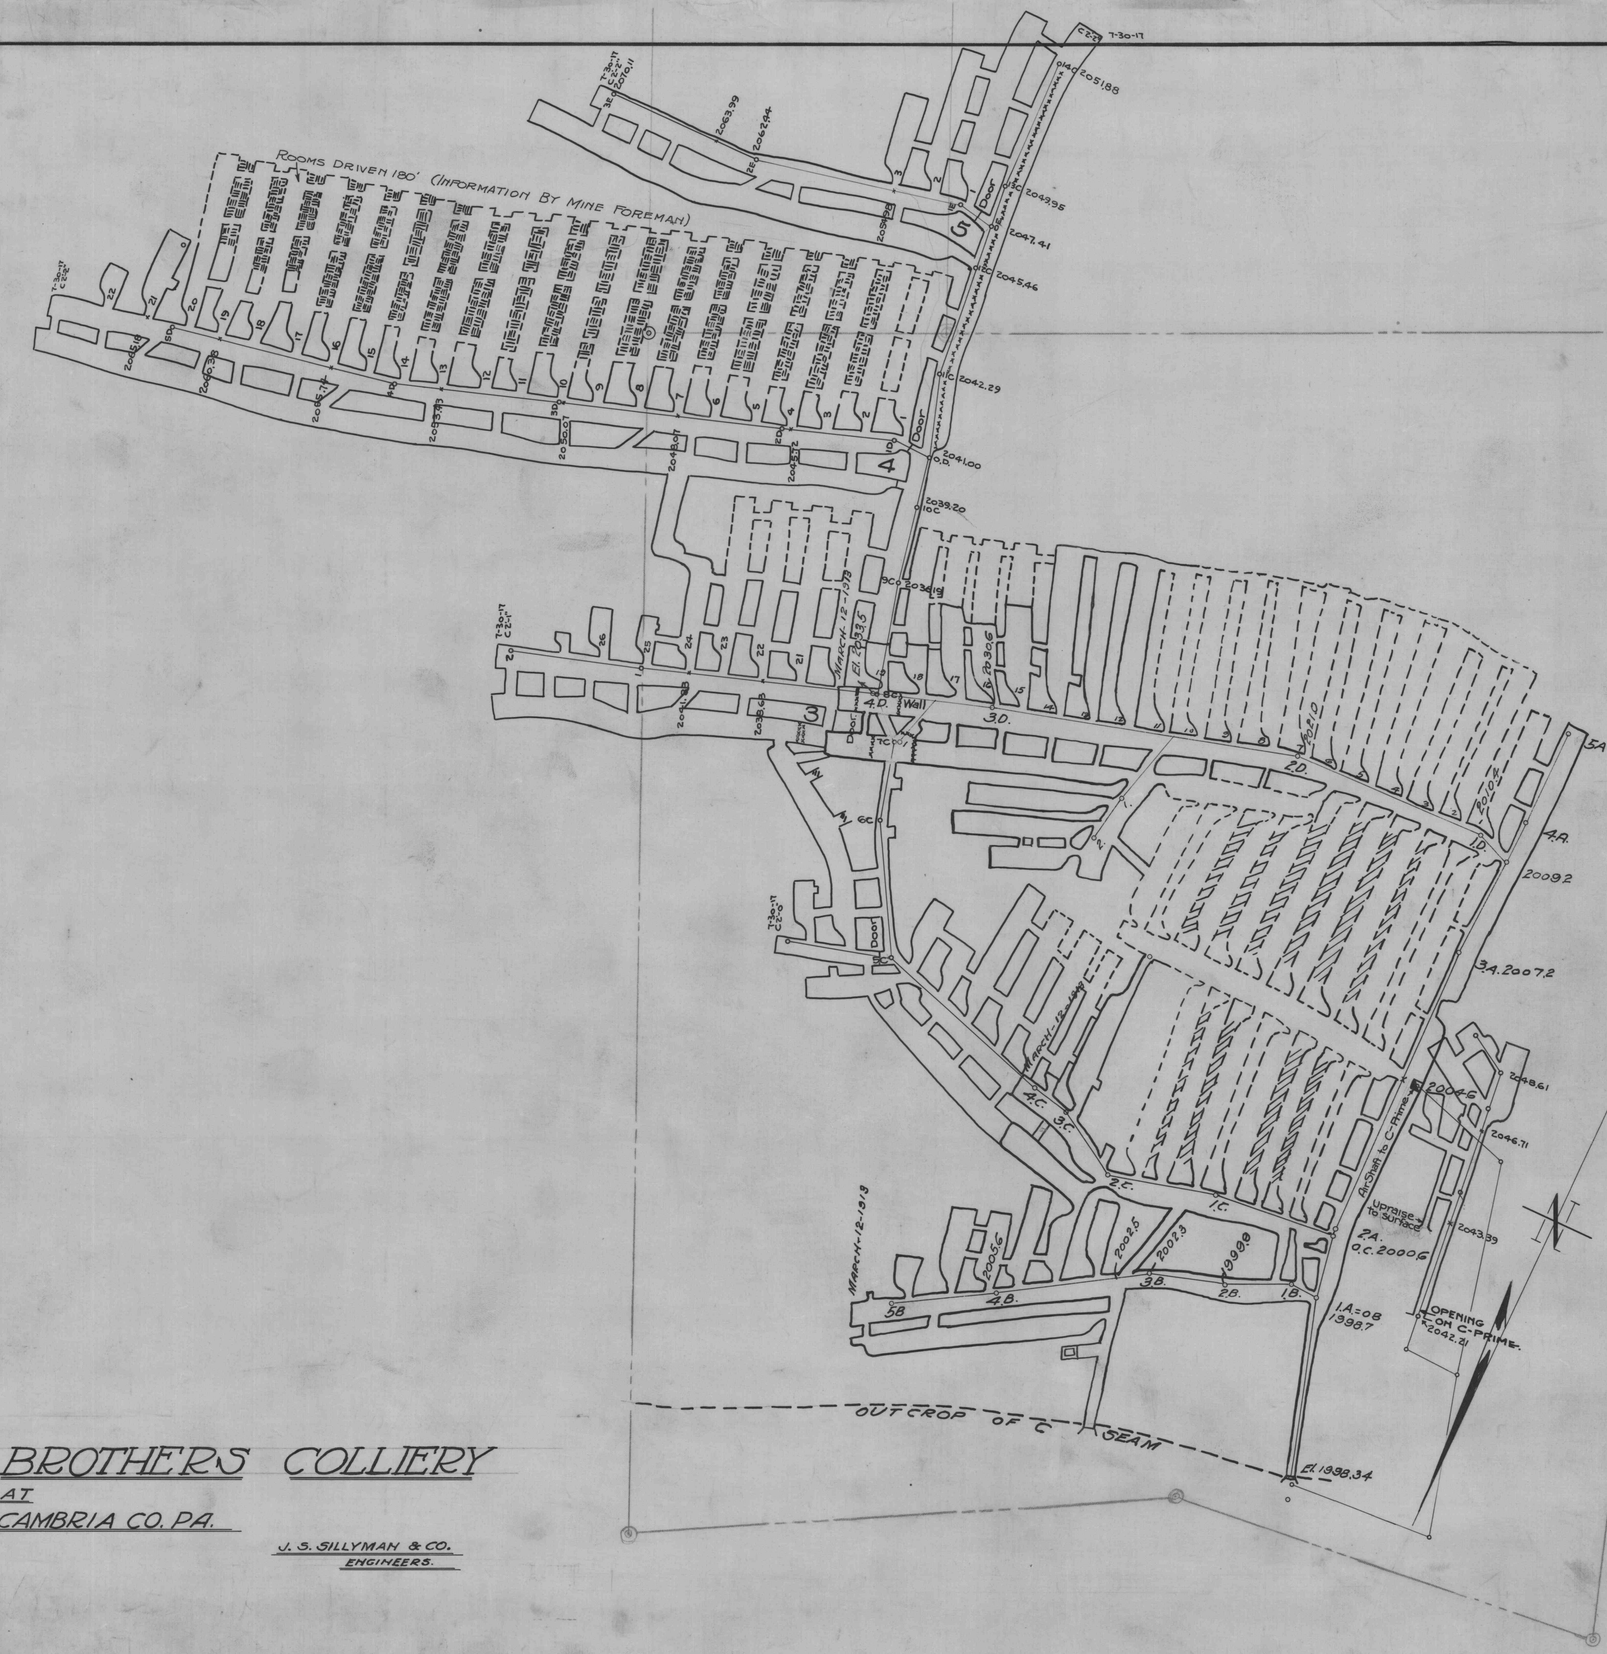

MAP OF BROWN BROTHERS COLLIERY

AT

MOUNTAINDALE-CAMBRIA CO. PA.

SCALE= 1"=100'

J. S. SILLYMAN & CO.
ENGINEERS.

#288

B-7 C7T1-4