


CRESSON & CLEARFIELD C. & C.

Stone
Corner

PLACK

DOUGHERTY

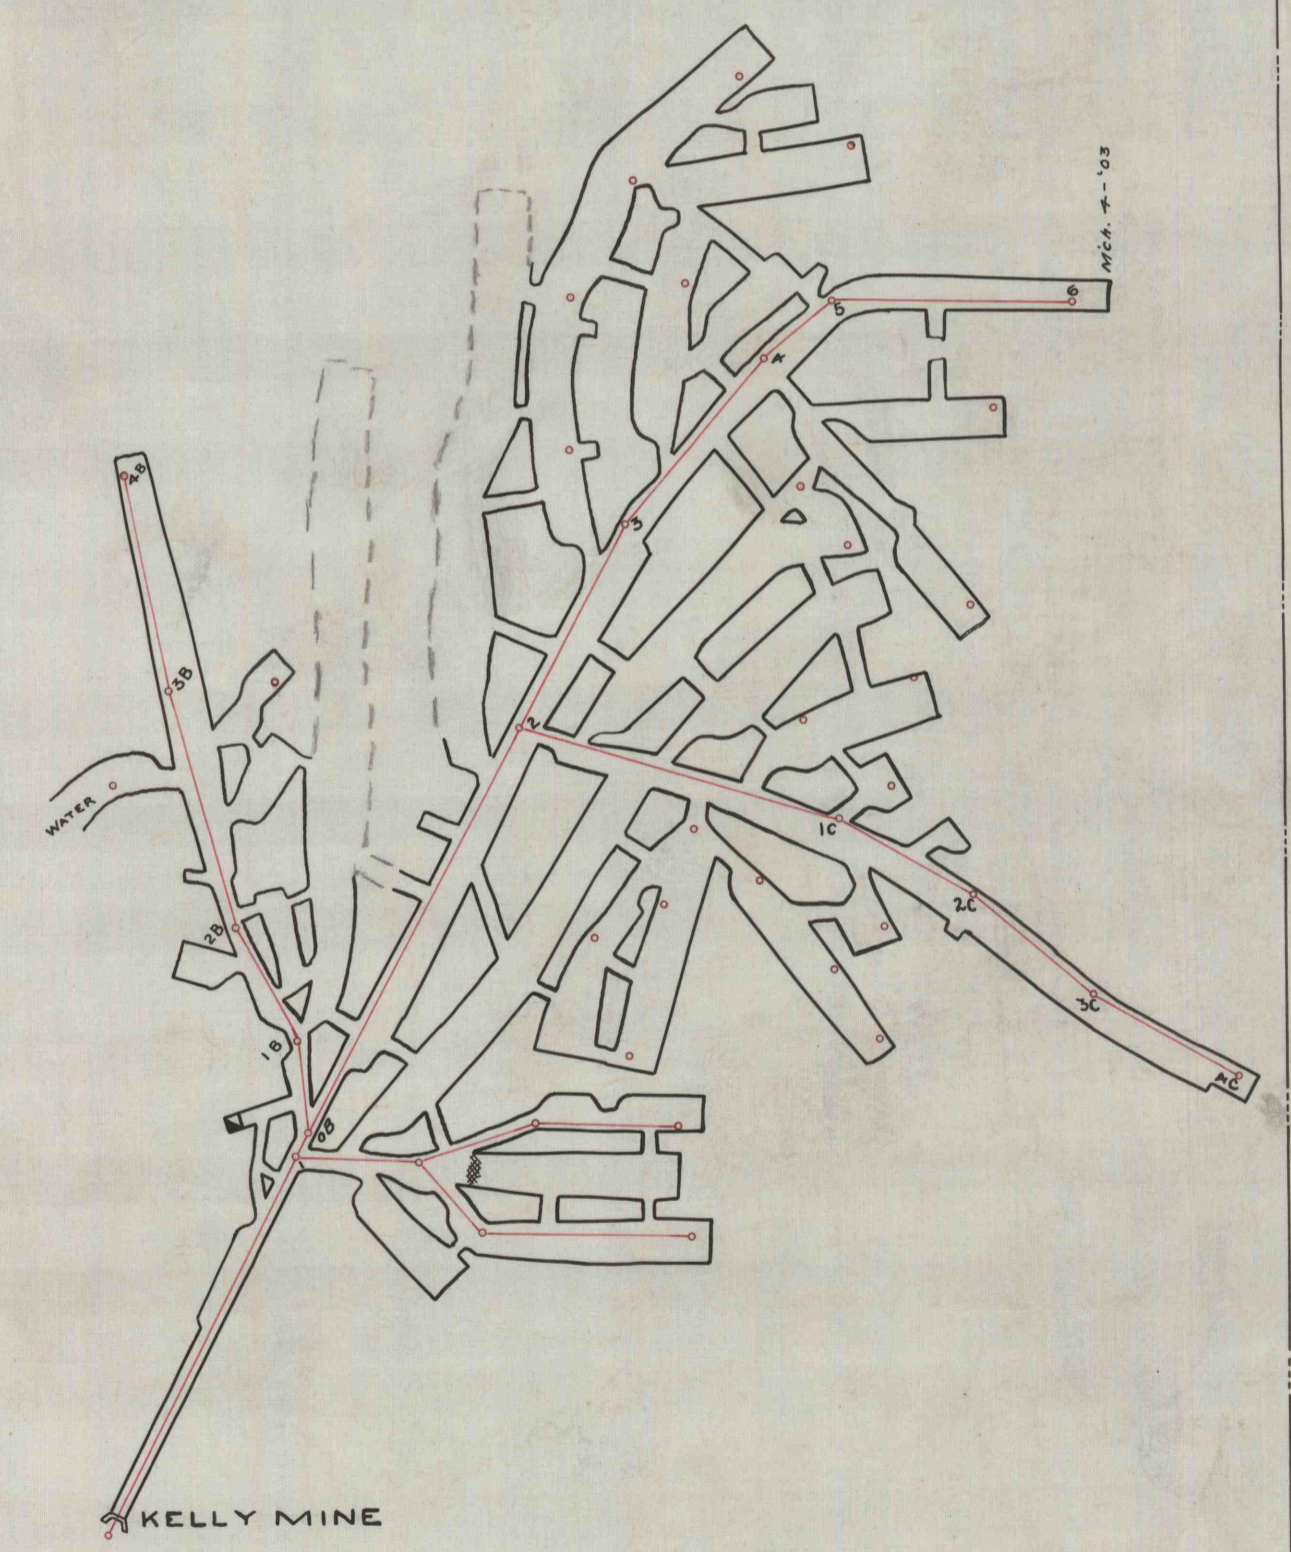

N

KELLY MINE
ON
PLACK LANDS

READE TOWNSHIP, CAMBRIA CO., PA

SCALE: 100' = 1"

Jos. S. SILLYMAN & Co.,
ENGINEERS.

*Kelly Mine
Cambria Co. Pa.
4-2-34*