


HEGARTY

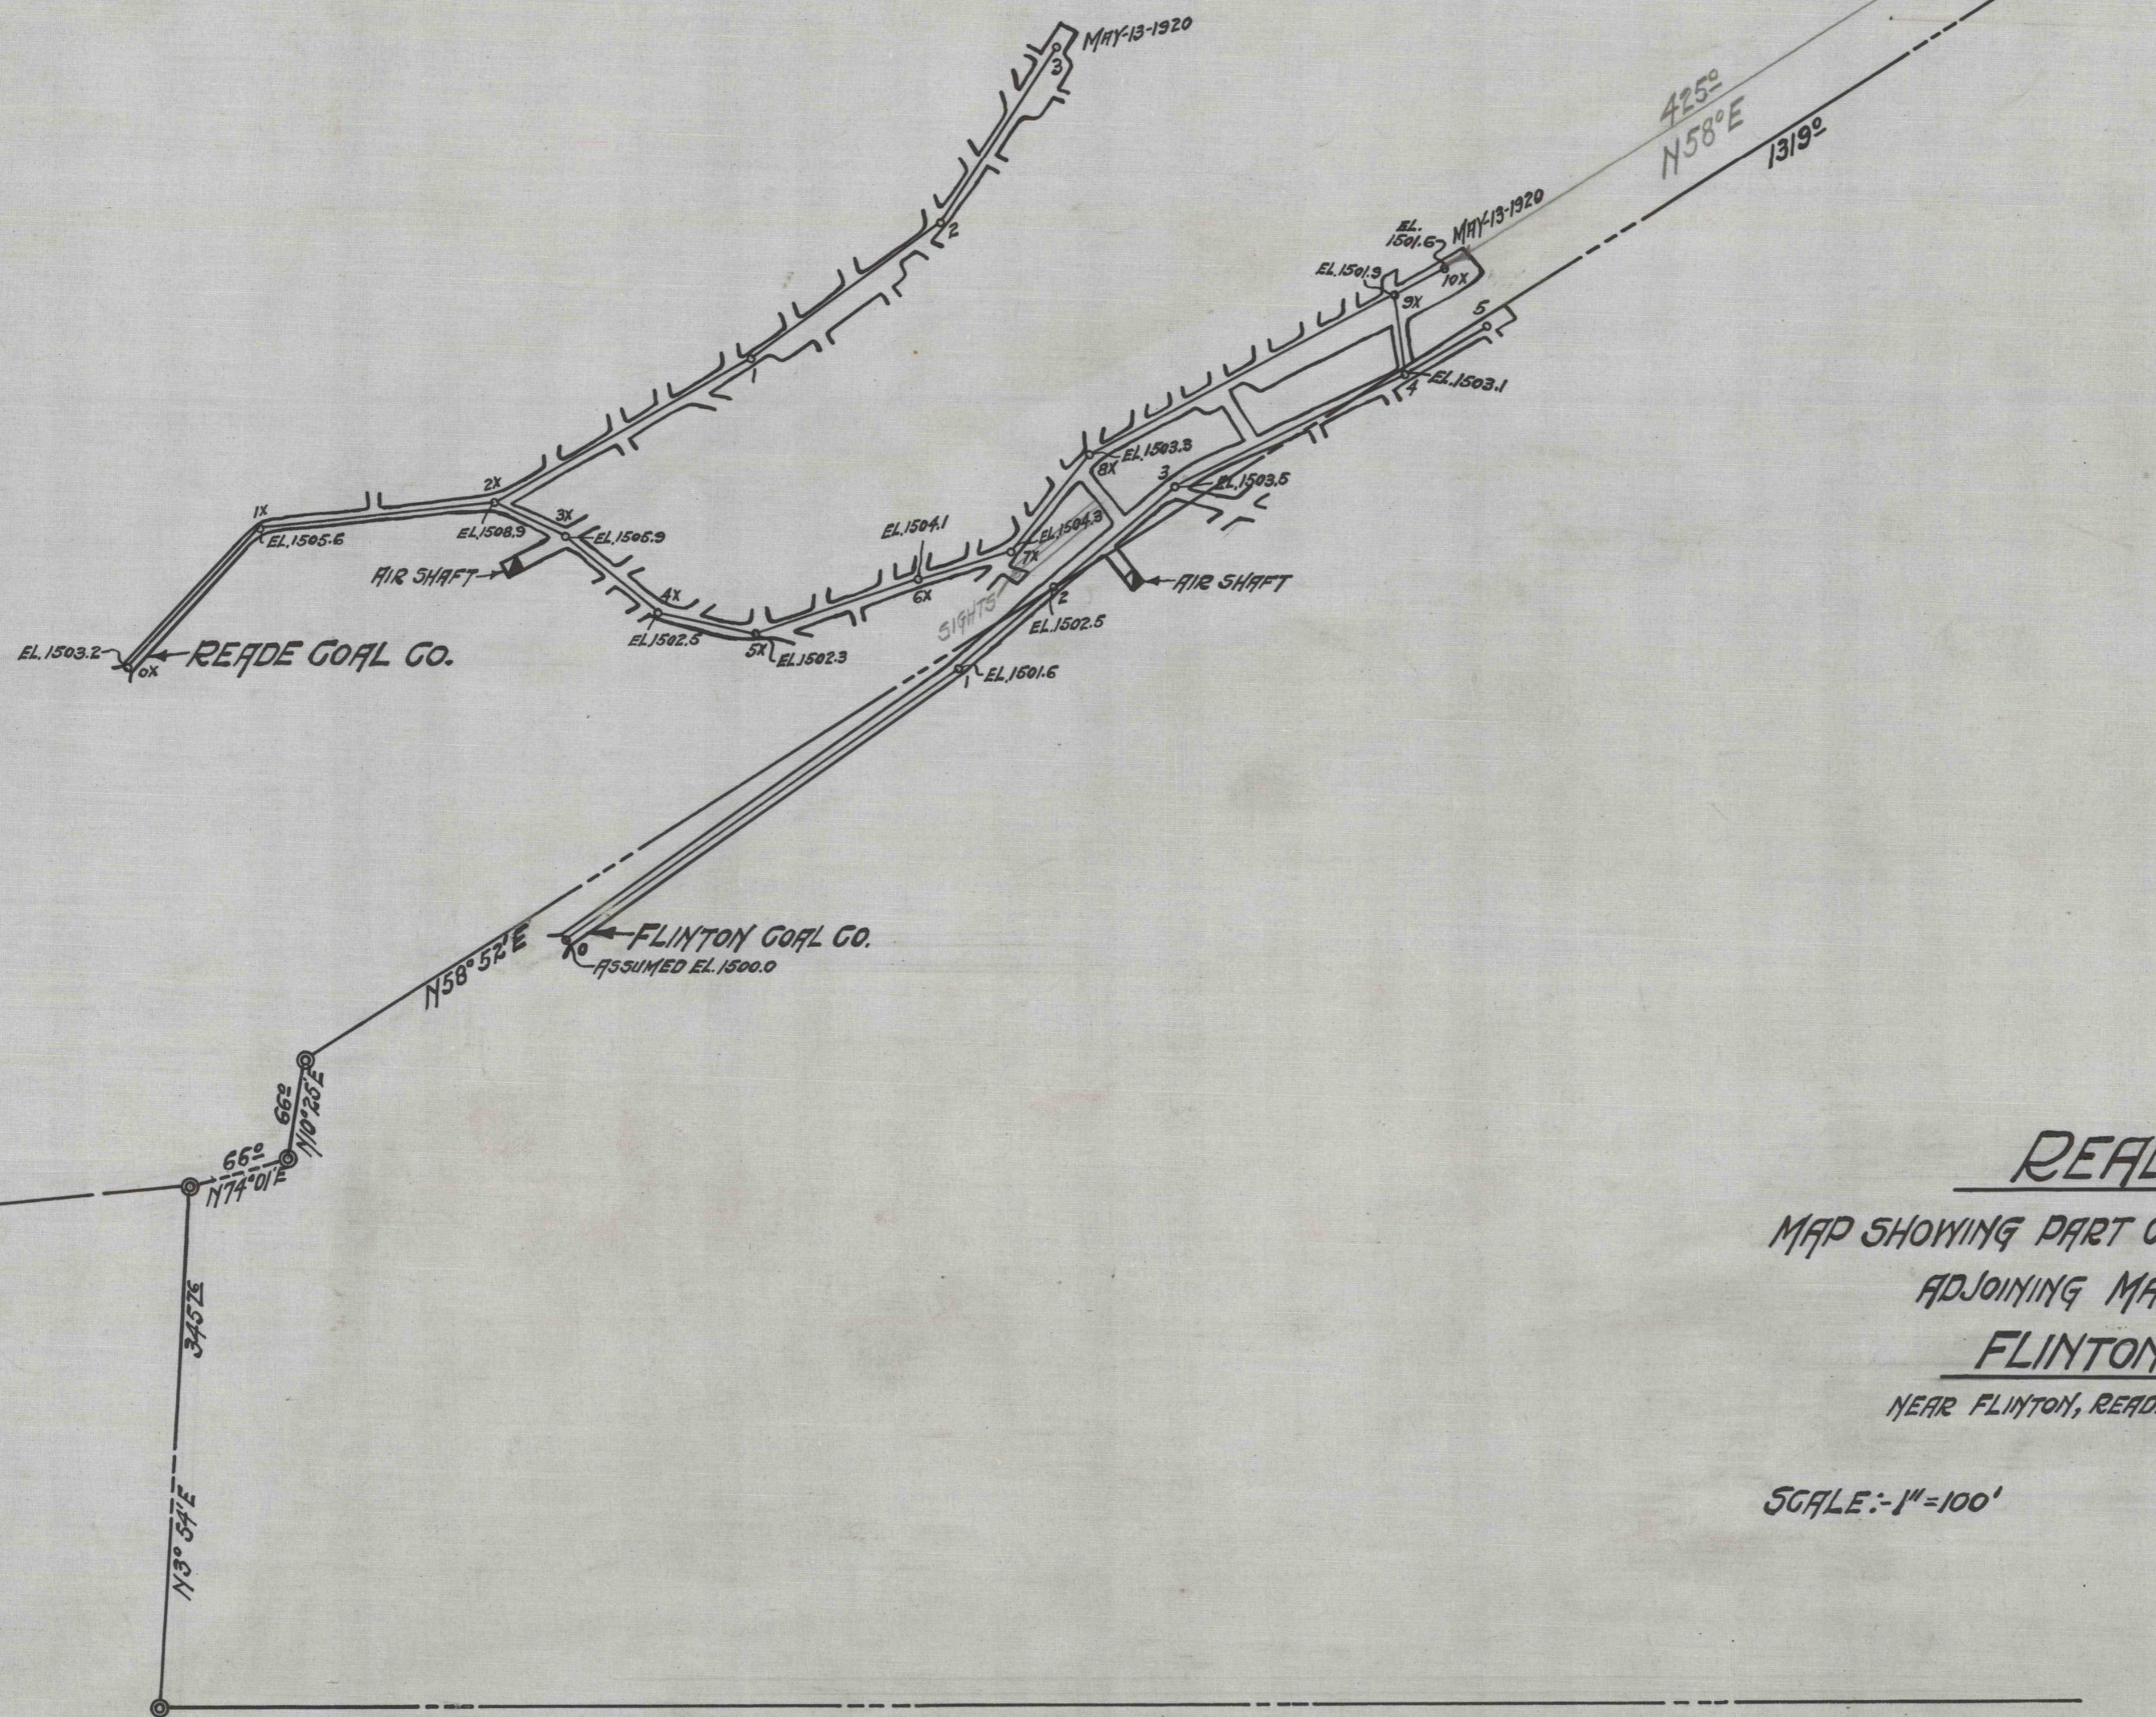

READE GOAL CO.
 MAP SHOWING PART OF MINE WORKINGS IN "D" SEAM
 ADJOINING MAIN HEADING OF THE
FLINTON GOAL CO.
 NEAR FLINTON, READE TWP, GAMBRIA CO., PENNSA.

SCALE: - 1" = 100'

JOS. S. SILLYMAN & CO.
 ENGINEERS
 PH. BHOOLTA

Handwritten notes and signatures at the bottom right corner, including the number 67820-4.