


HENRIETTE COAL MINING CO.
PLAN SHOWING TRAVELING WAYS AND
AIR WAYS, HENRIETTE No 2 SHAFT.

SCALE: 1" = 400'

J.S. SILLYMAN & CO.
ENGINEERS

DIRECTION OF AIR CURRENTS INDICATED THUS:

TRAVELING WAYS " "

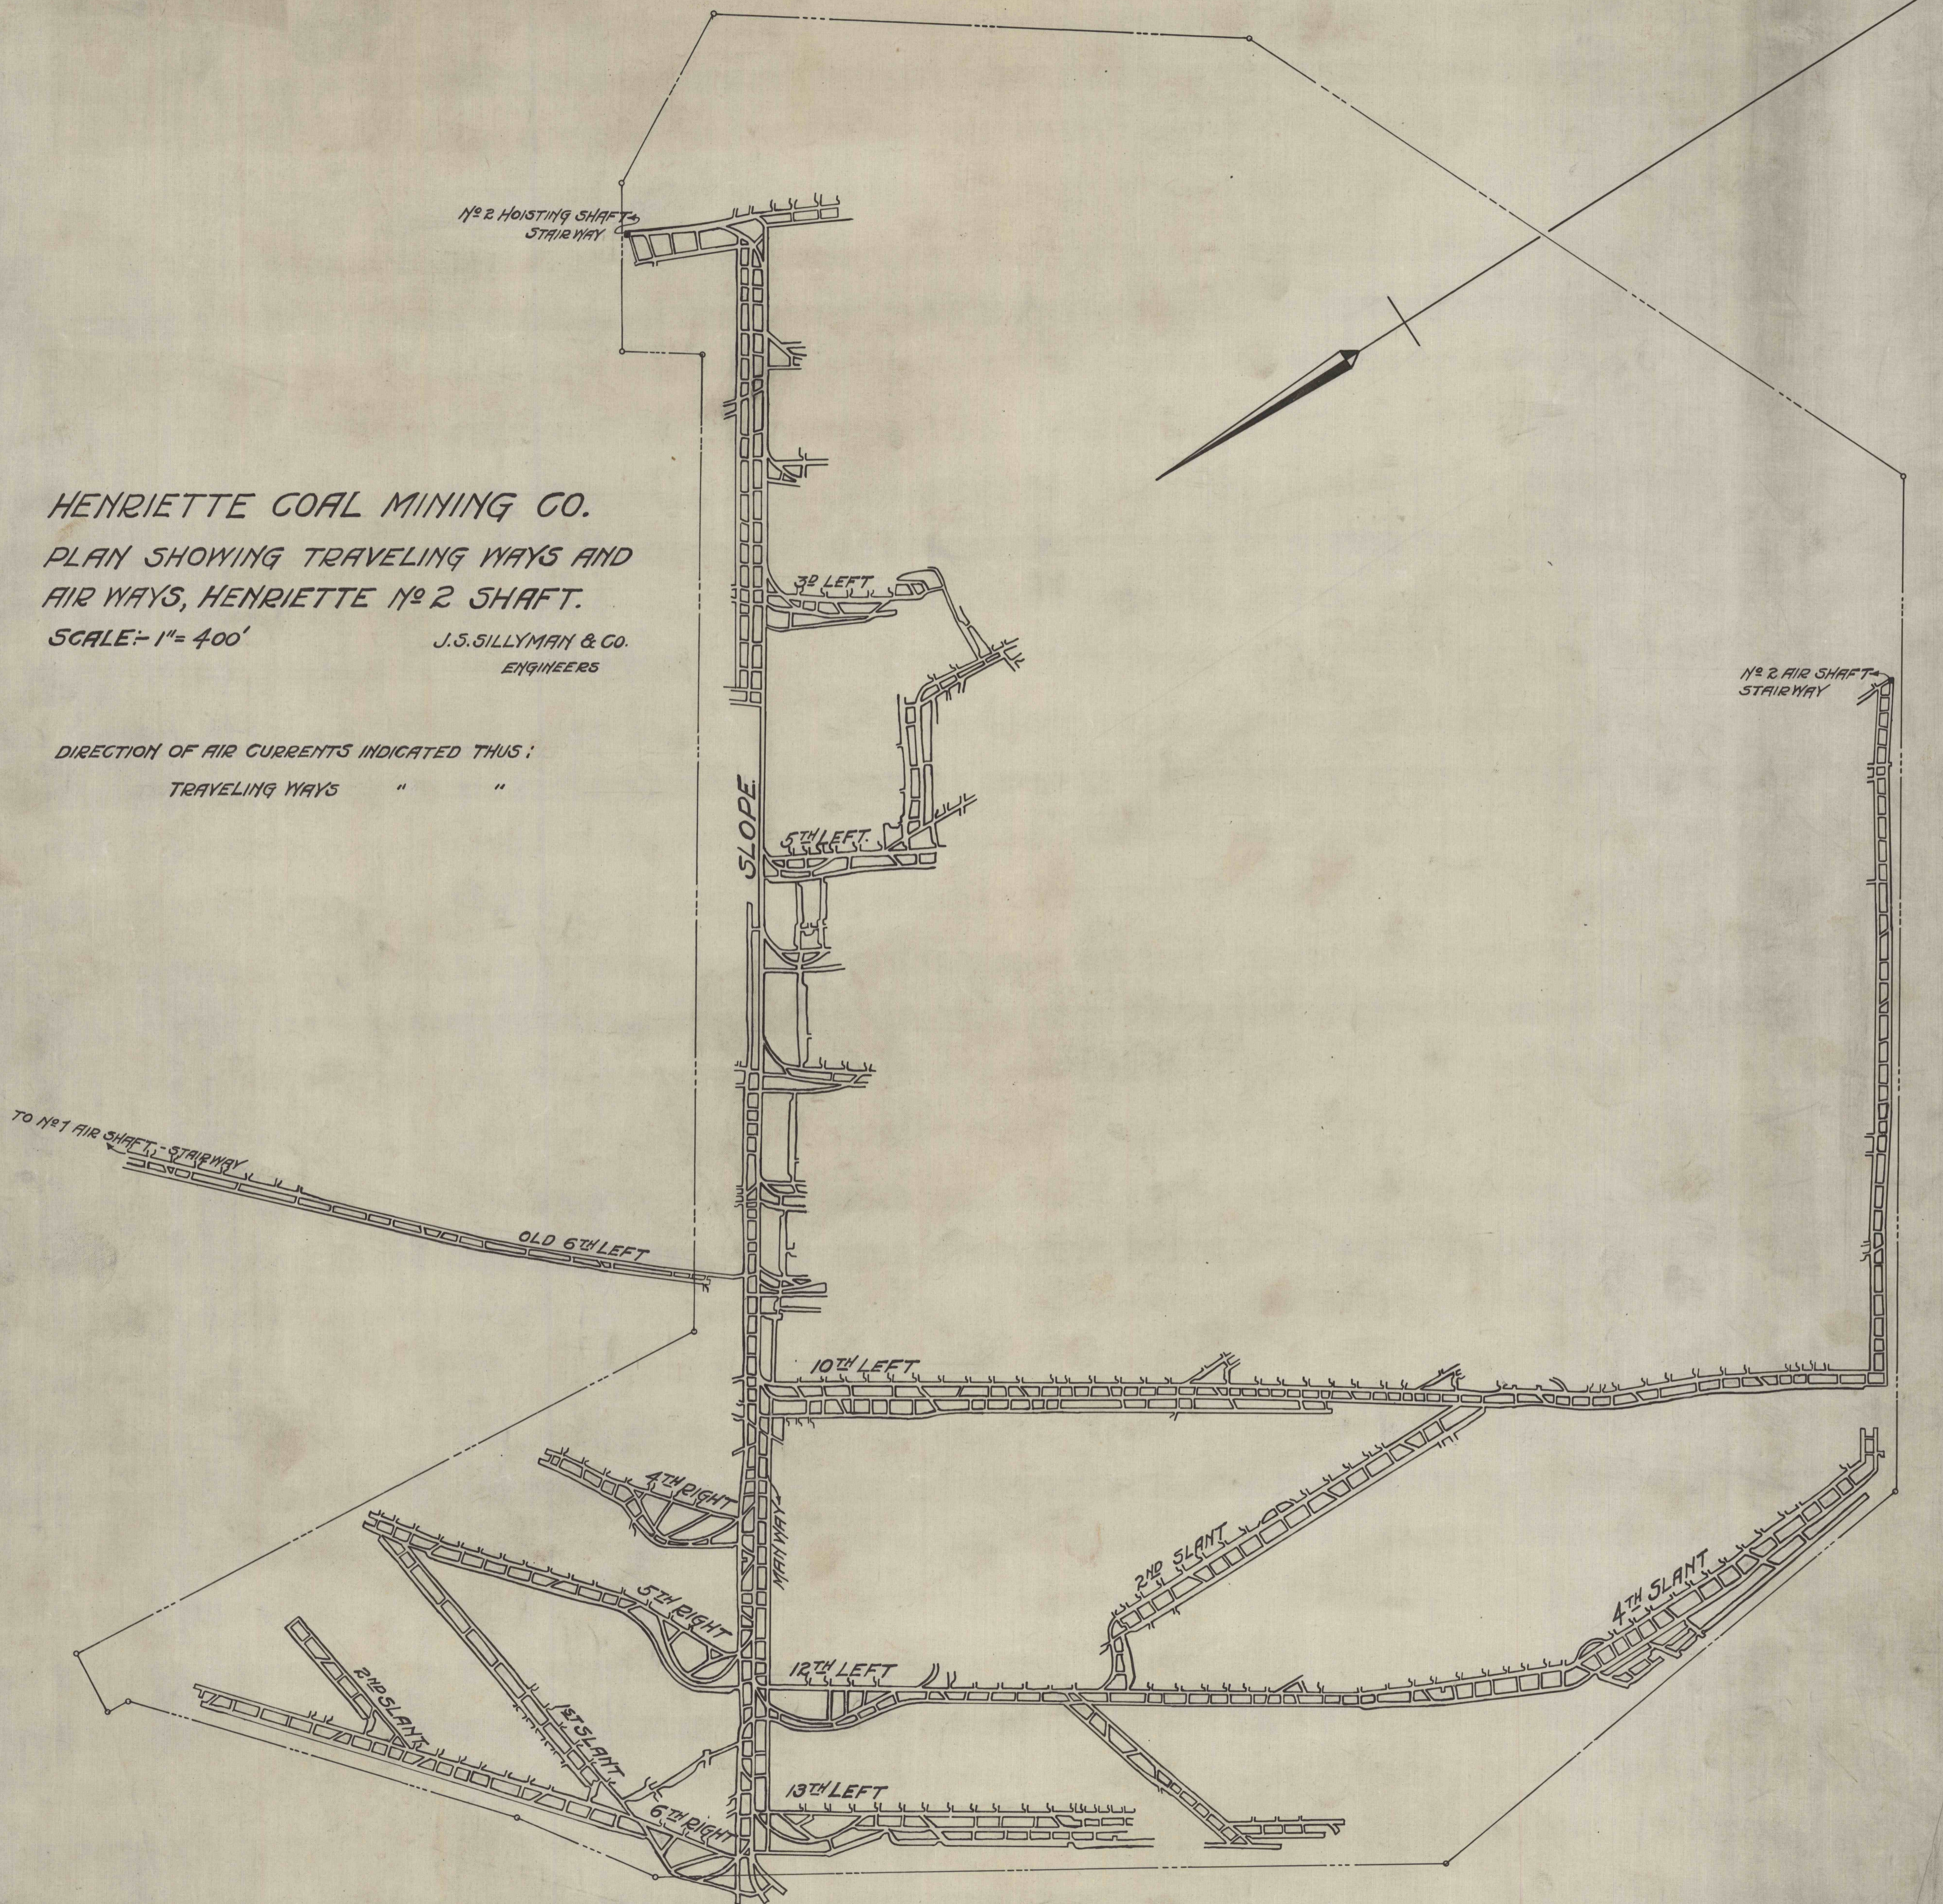

CD 204