


CA-7

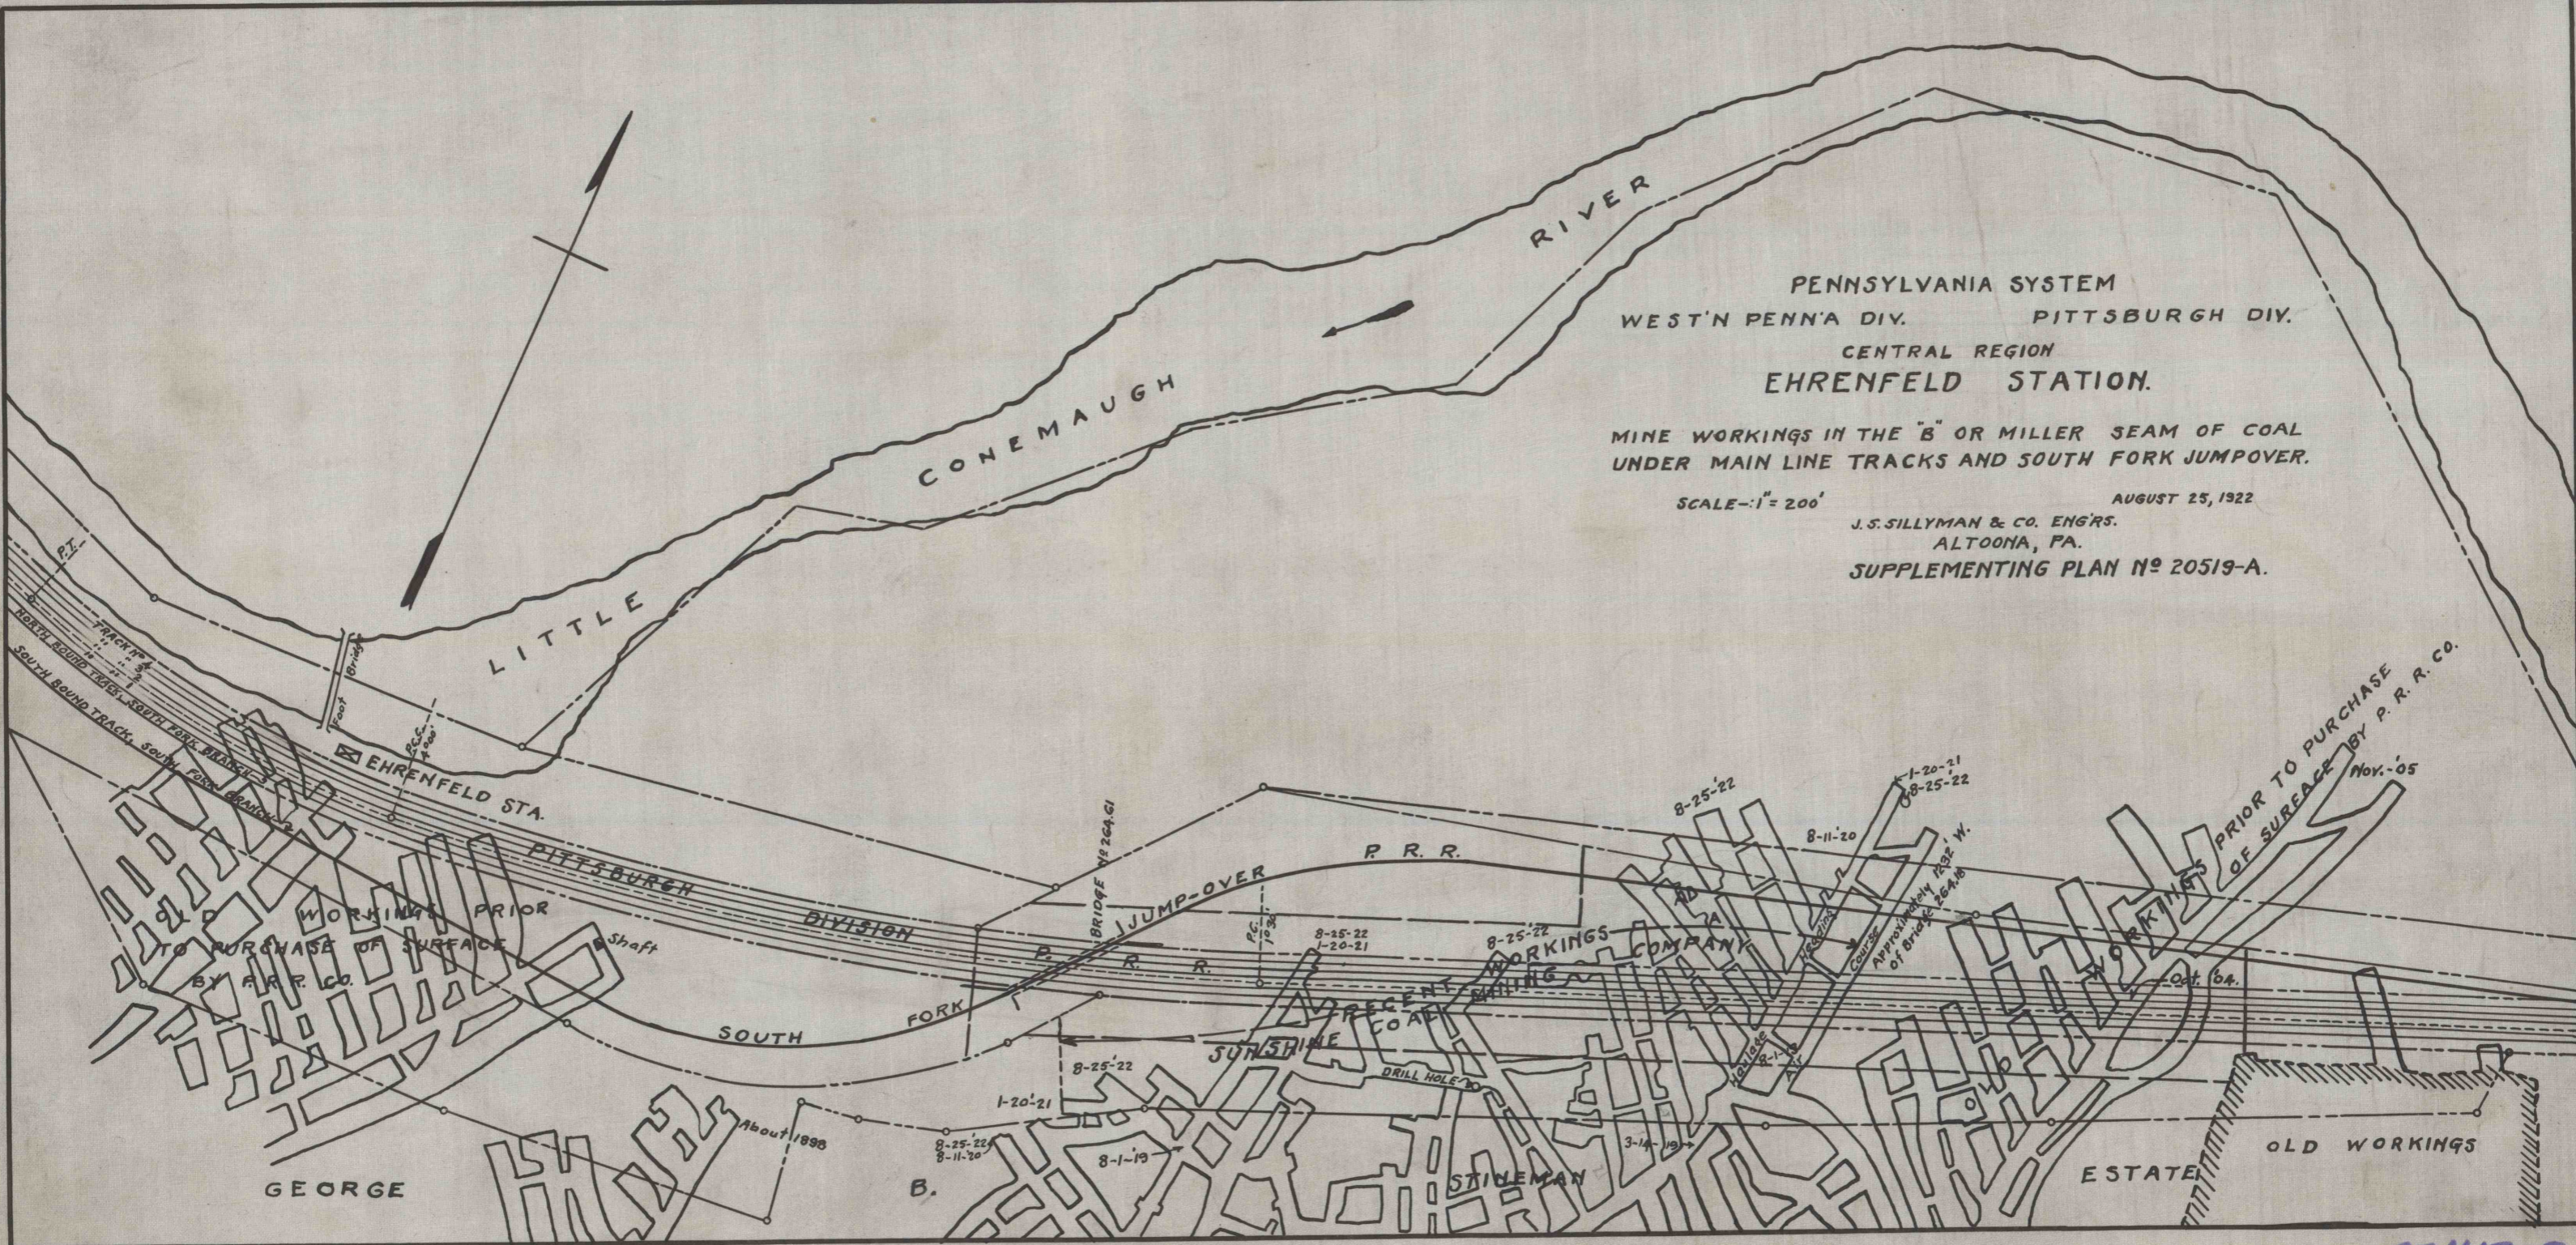

PENNSYLVANIA SYSTEM
 WEST'N PENN'A DIV. PITTSBURGH DIV.
 CENTRAL REGION
 EHRENFELD STATION.

MINE WORKINGS IN THE "B" OR MILLER SEAM OF COAL
 UNDER MAIN LINE TRACKS AND SOUTH FORK JUMPOVER.

SCALE--1"=200' AUGUST 25, 1922
 J.S. SILLYMAN & CO. ENGRS.
 ALTOONA, PA.
 SUPPLEMENTING PLAN No 20519-A.

CA-7

C7H12-3