


CA-9
H-3H
L-10

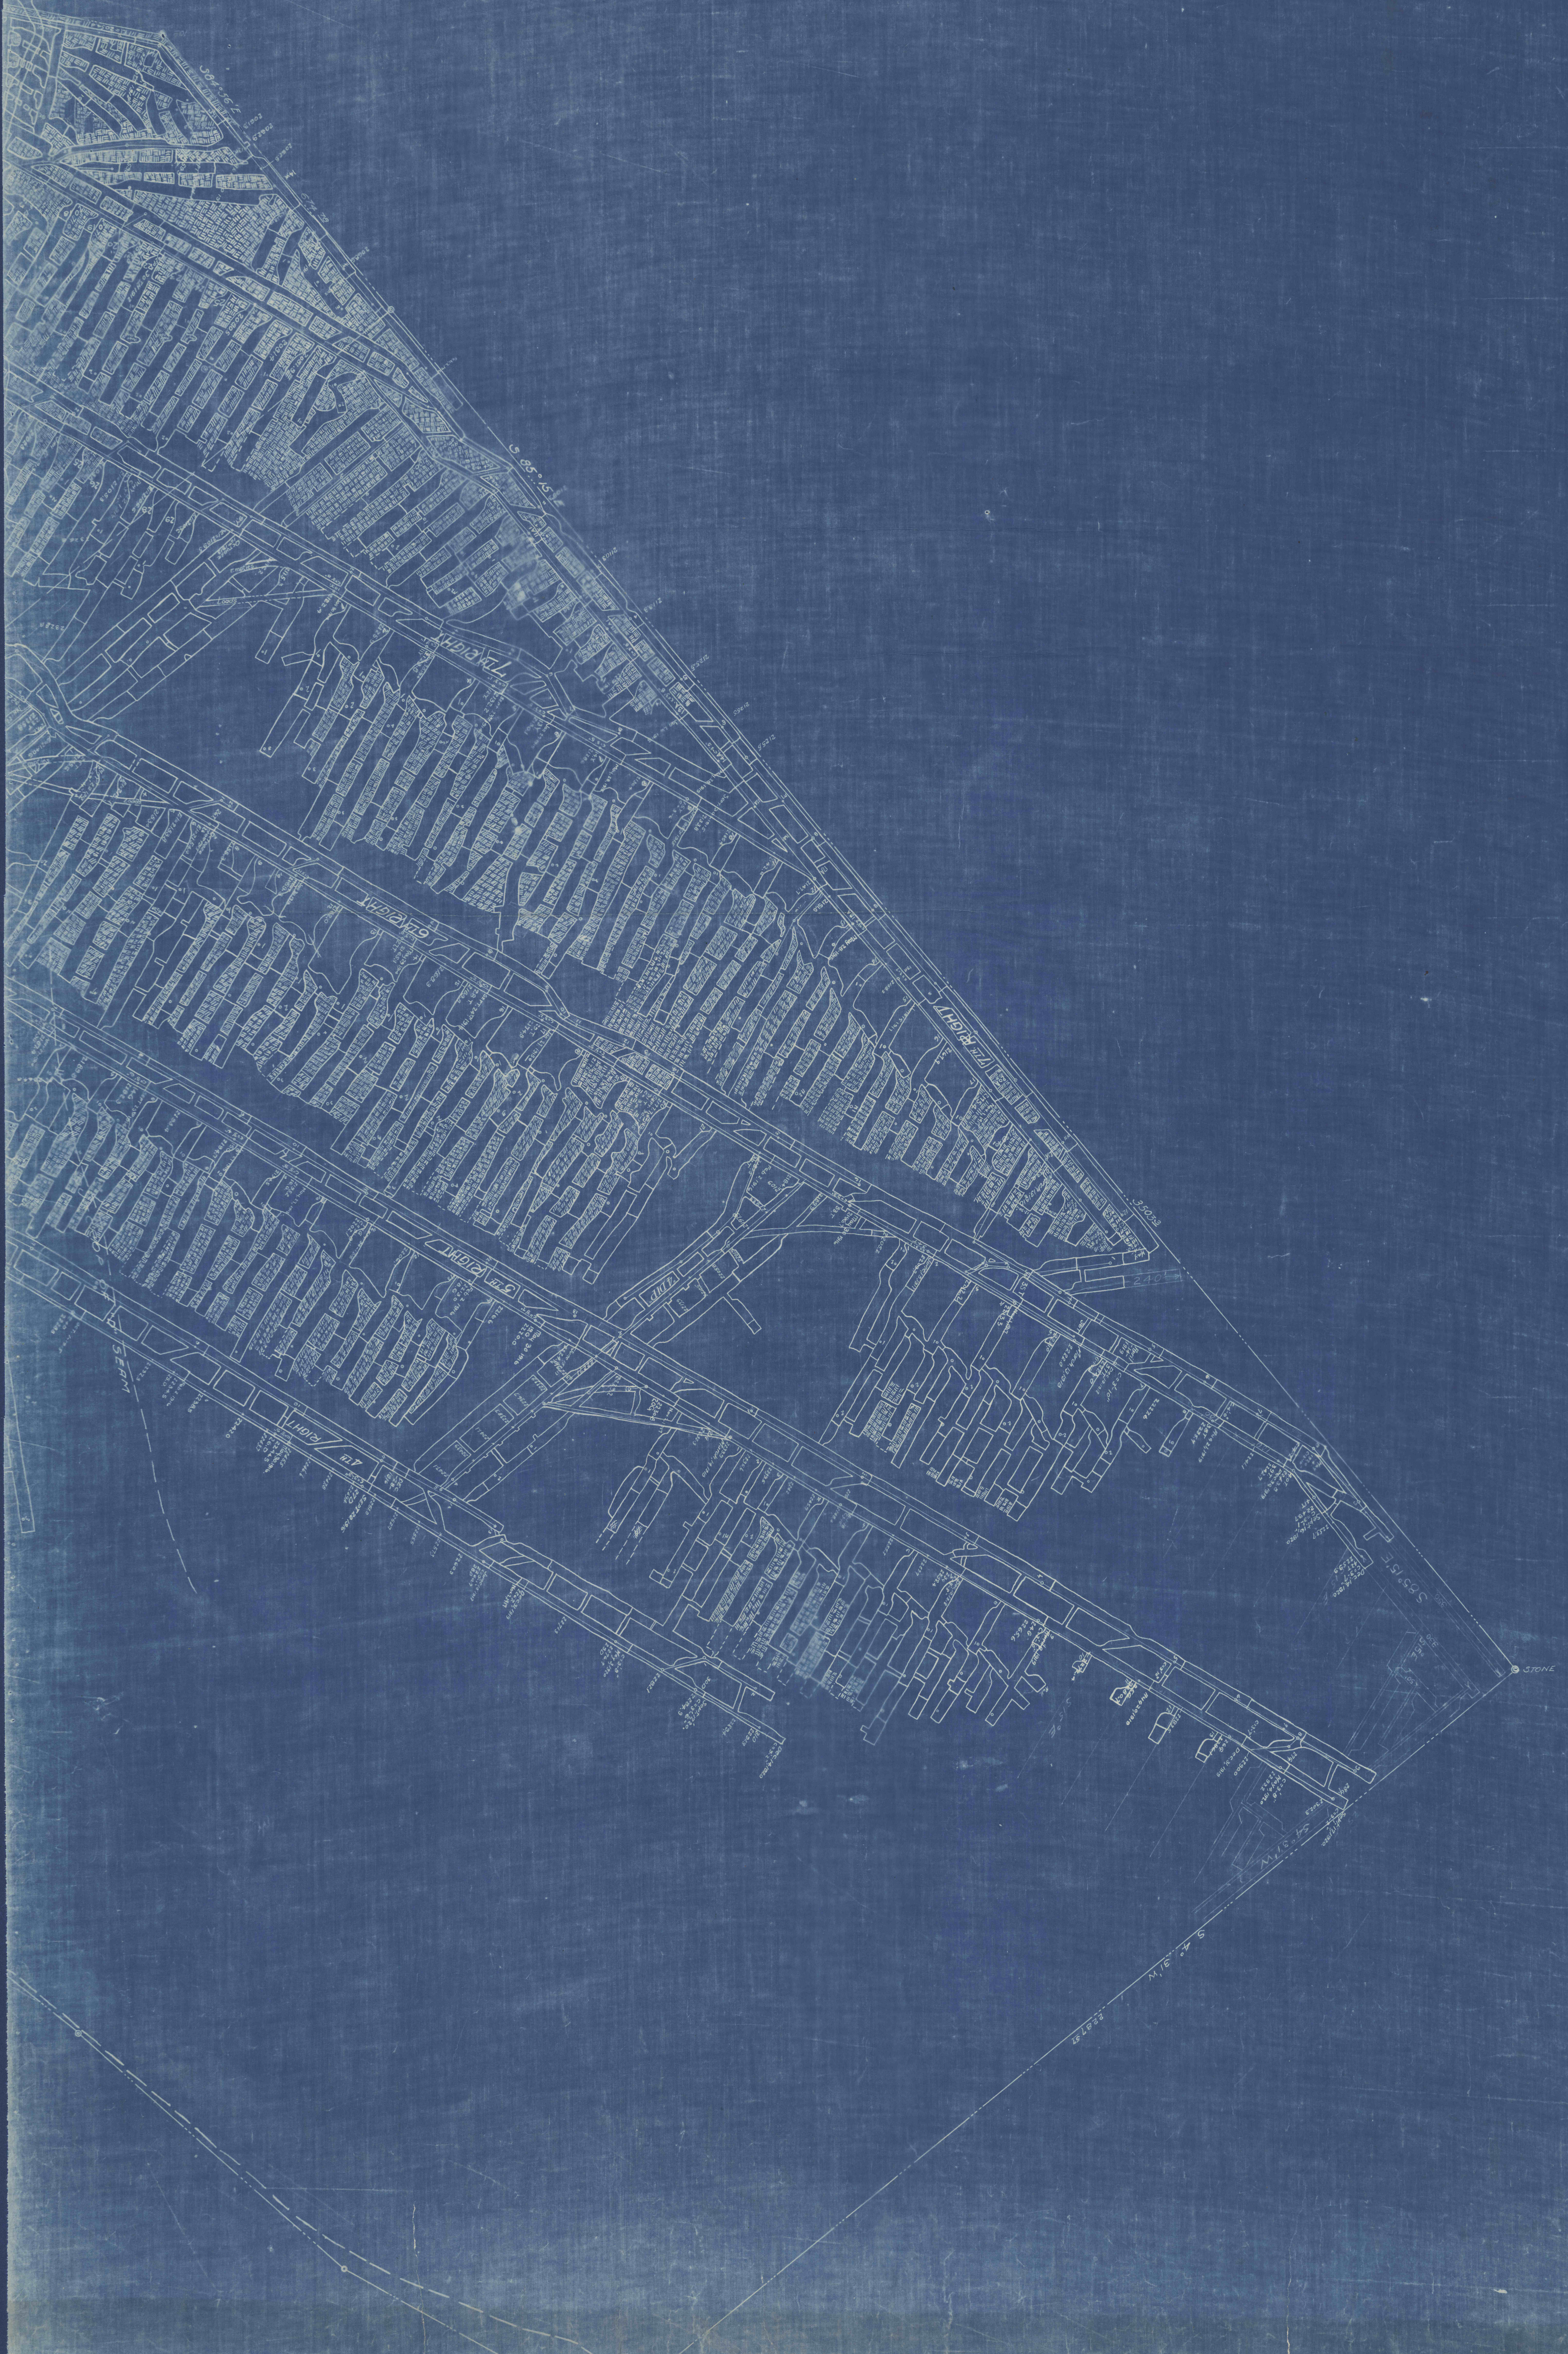

CA-9
H-3H