


645

MAP  
of  
NO 3 MINE  
LOYAL HANNA C & C Co  
Situated at  
Ormalinda Cambria County Penna.  
SCALE 1"=100' 1906. J. S. BILLYMAN & CO.

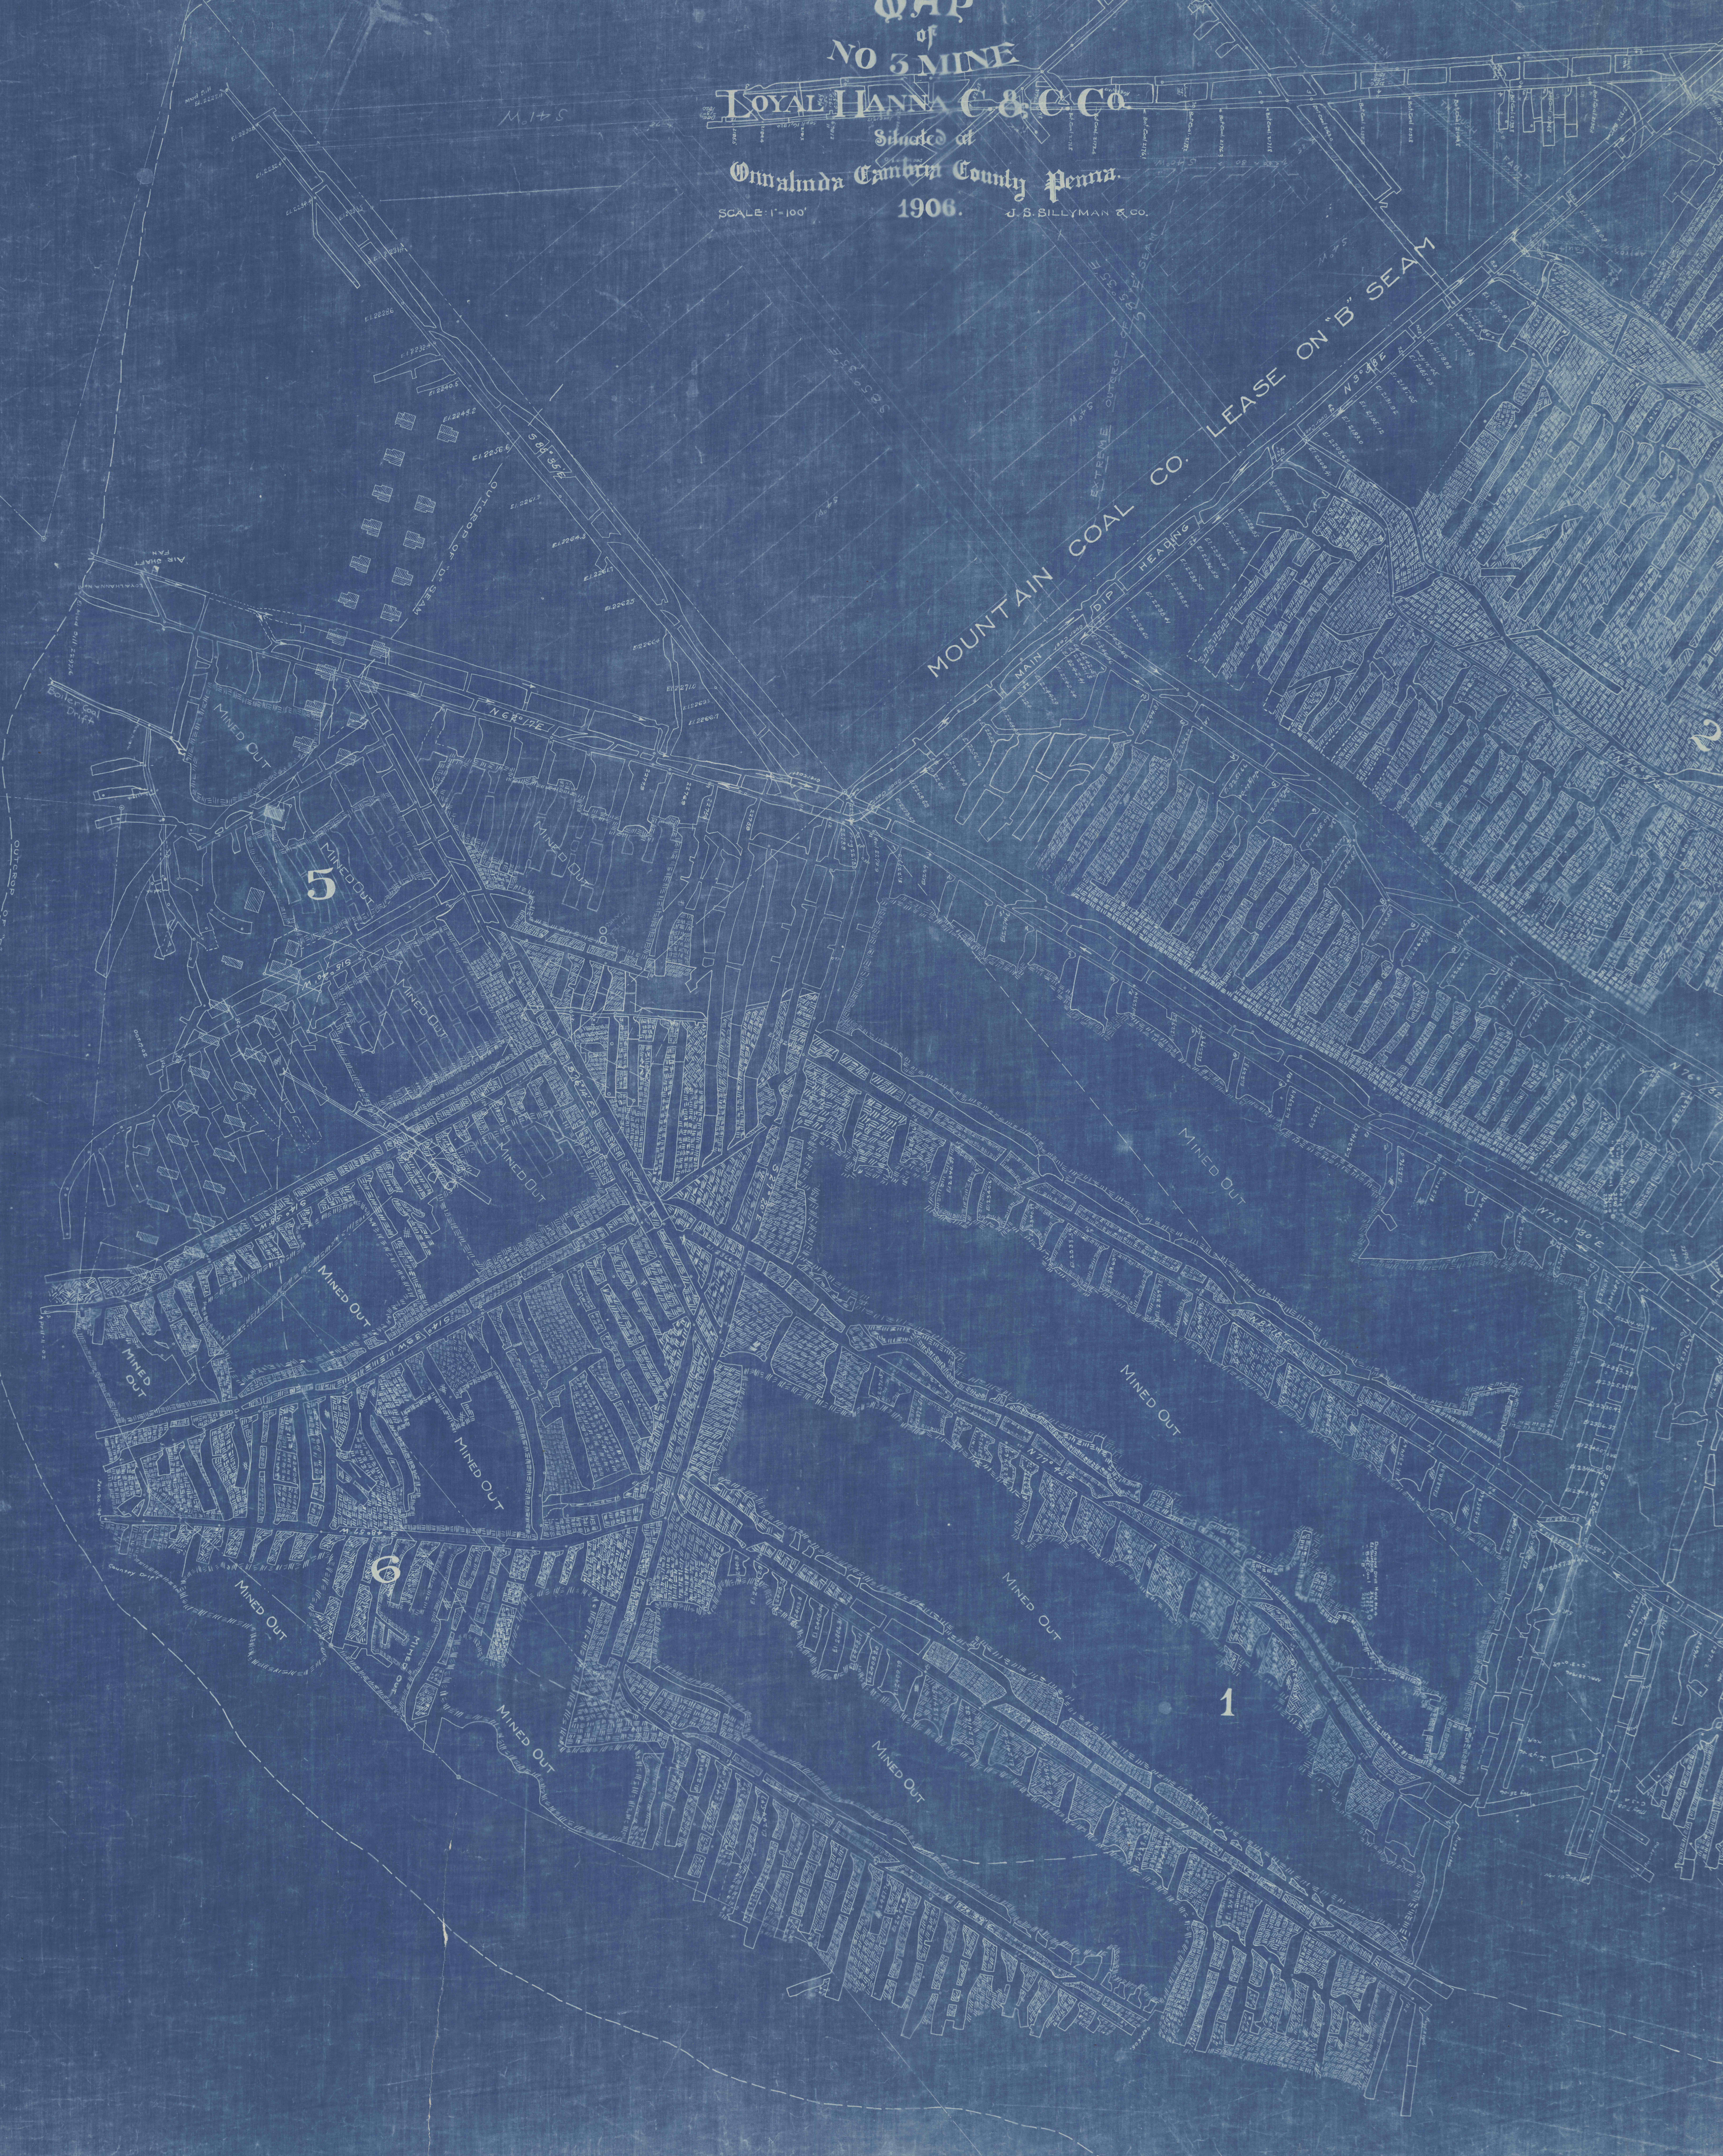

5

6

1

CA-9  
HCL

HCL