


COLOR	PERMIT	ACREAGE AFFECTED	RESTORED	DELETED	PLANTED	PERMIT REMAINING	AC UNDER BOND	BONDS

- TO BE MINED
- UPPER FREEPORT
- LOWER FREEPORT
- LOWER KITTANNING
- BROOKVILLE
- MERCER
- BROOKVILLE & MERCER
- BROOKVILLE & LOWER KITTANNING
- INCIDENTAL ACREAGE

- TOTAL PERMIT
- STRIPPED
- TO BE AFFECTED
- COMPLETION
- TOPSOIL
- DELETION

WATER SOURCES

1. EVAN L. JONES	None

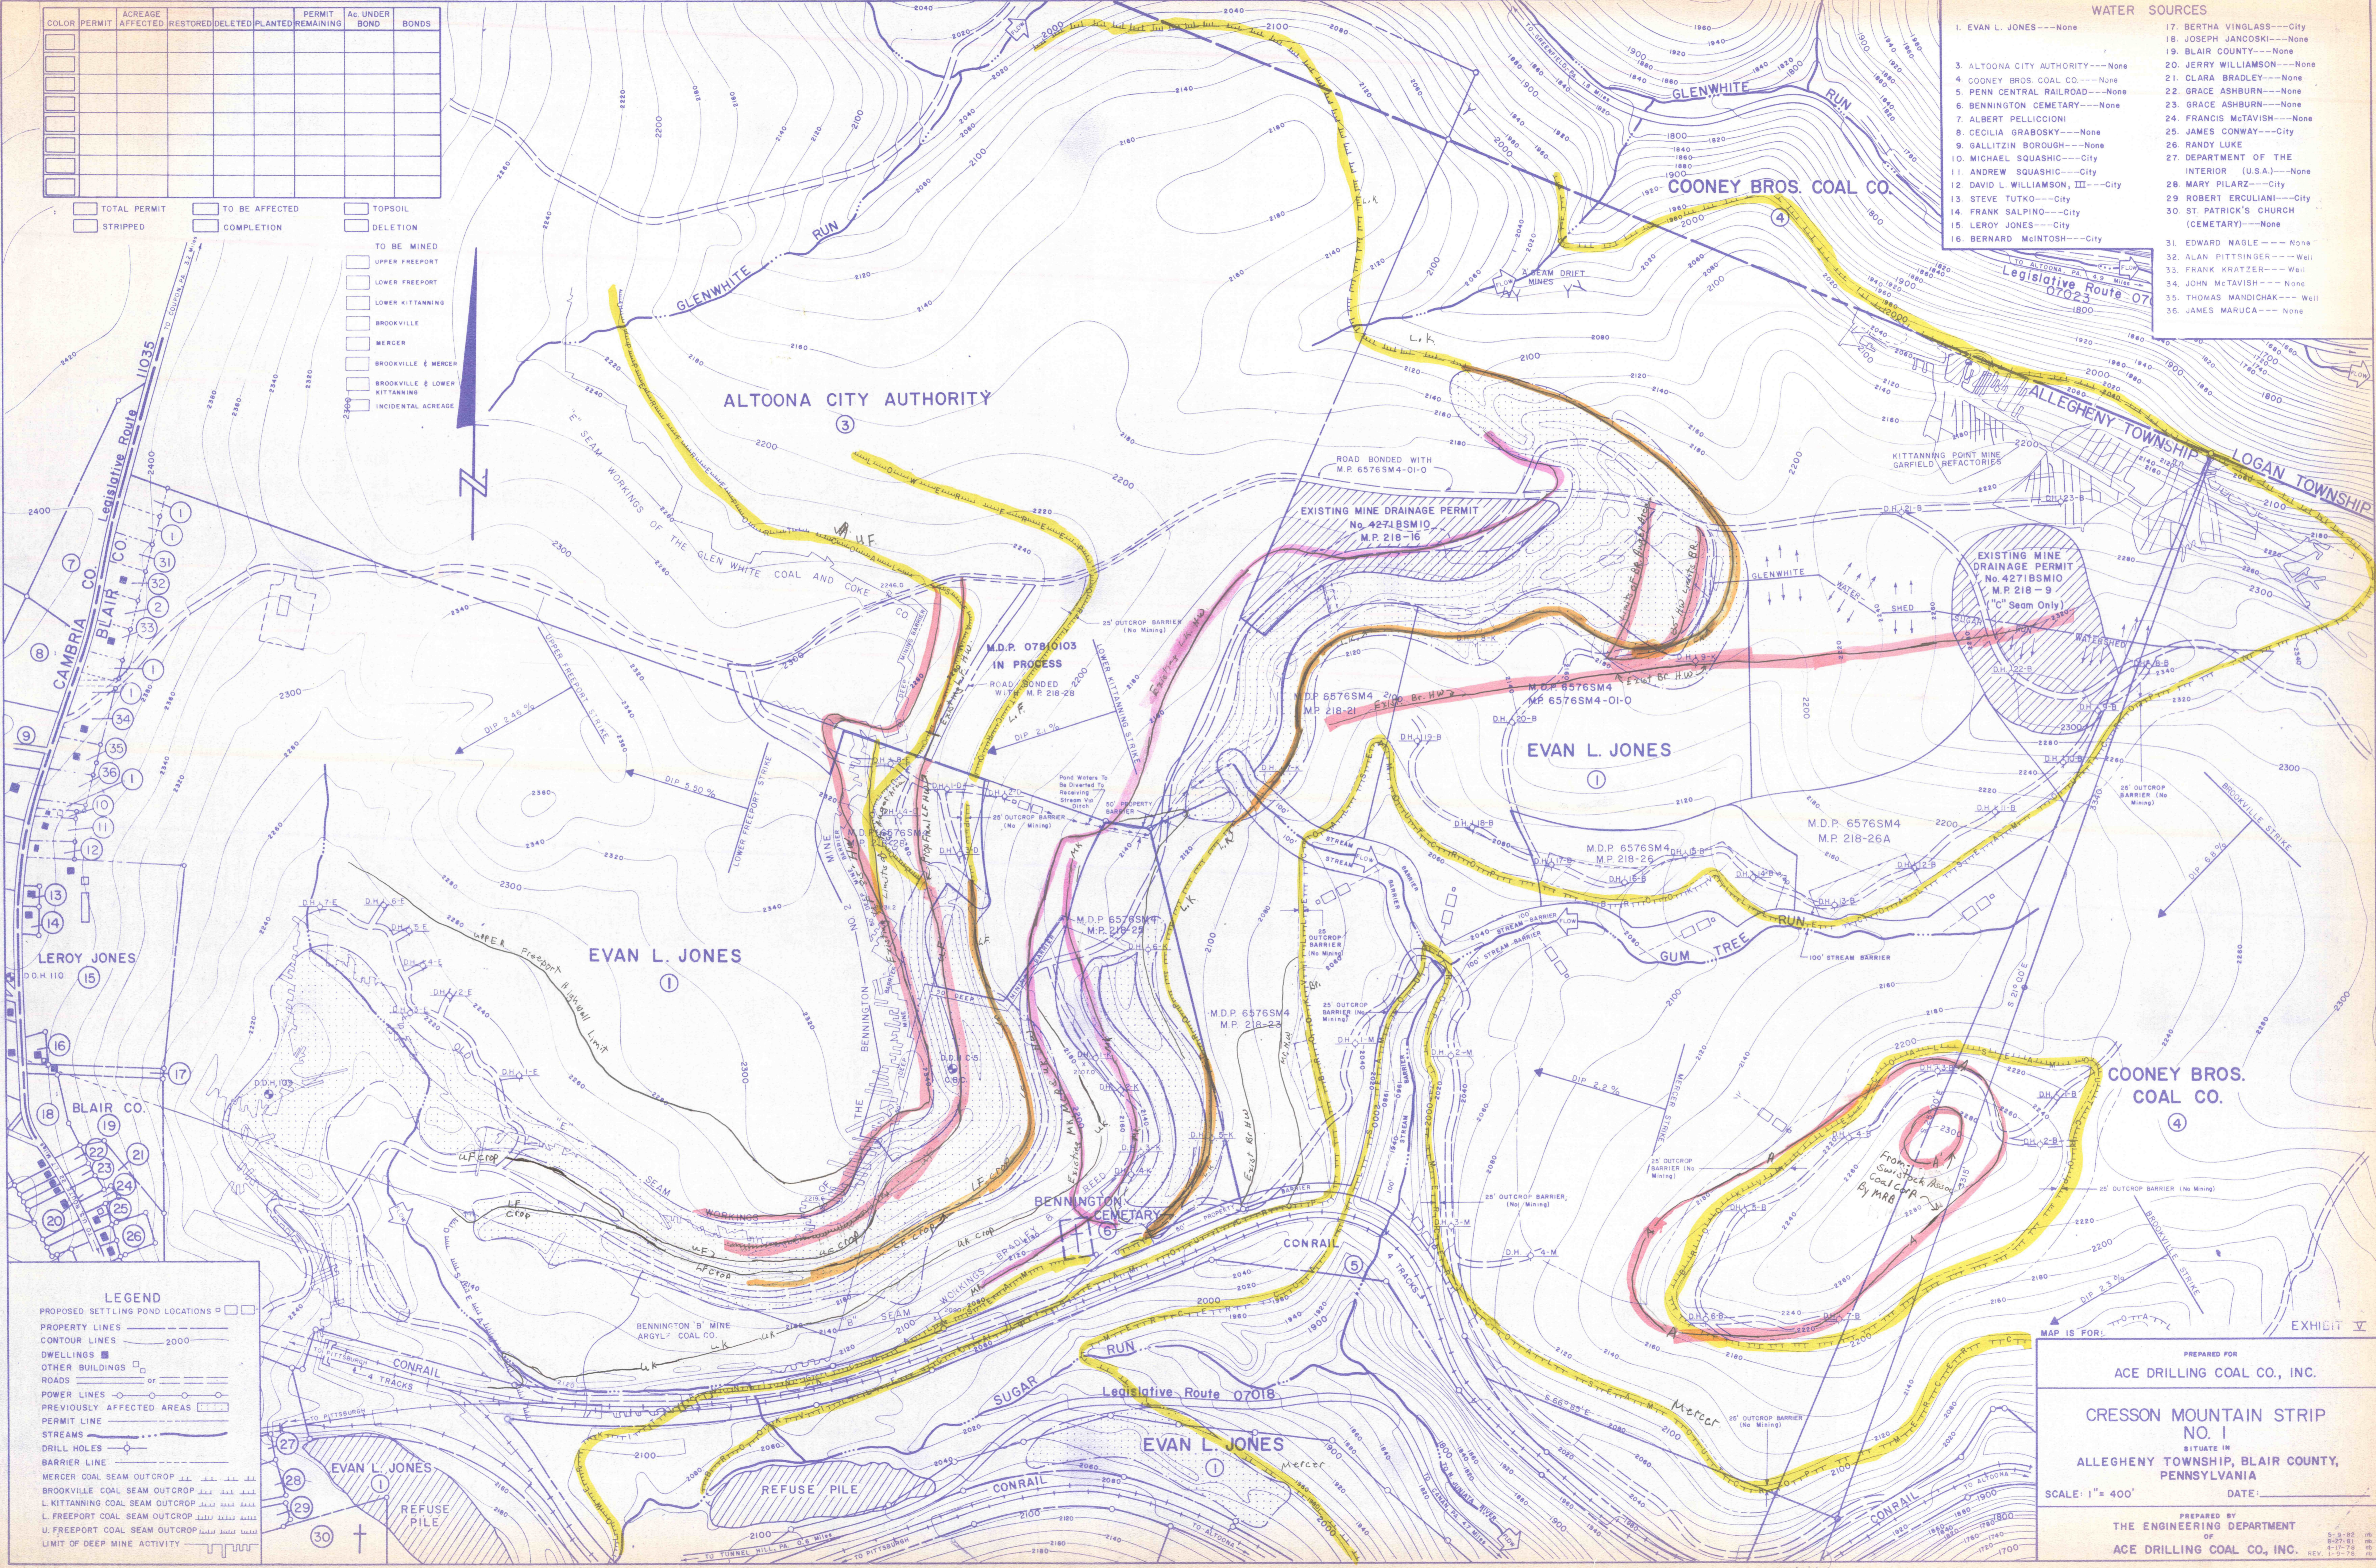

LEGEND

- PROPOSED SETTLING POND LOCATIONS
- PROPERTY LINES
- CONTOUR LINES 2000
- DWELLINGS
- OTHER BUILDINGS
- ROADS
- POWER LINES
- PREVIOUSLY AFFECTED AREAS
- PERMIT LINE
- STREAMS
- DRILL HOLES
- BARRIER LINE
- MERCER COAL SEAM OUTCROP
- BROOKVILLE COAL SEAM OUTCROP
- L. KITTANNING COAL SEAM OUTCROP
- U. FREEPORT COAL SEAM OUTCROP
- L. FREEPORT COAL SEAM OUTCROP
- U. FREEPORT COAL SEAM OUTCROP
- LIMIT OF DEEP MINE ACTIVITY

PREPARED FOR
ACE DRILLING COAL CO., INC.

**CRESSON MOUNTAIN STRIP
NO. 1**
SITUATE IN
ALLEGHENY TOWNSHIP, BLAIR COUNTY,
PENNSYLVANIA

SCALE: 1" = 400'

DATE: _____

PREPARED BY
THE ENGINEERING DEPARTMENT
OF
ACE DRILLING COAL CO., INC.