


- 6 BENNINGTON CEMETARY---None
- 7 ALBERT PELLICIONI---None
- 8 CECILIA GRABOSKY---None
- 9 GALLITZIN BOROUGH---None
- 10 MICHAEL SQUASHIC---City
- 11 ANDREW SQUASHIC---City
- 12 DAVID L. WILLIAMSON, III---City
- 13 STEVE TUTKO---City
- 14 FRANK SALPINO---City
- 15 LEROY JONES---City
- 16 BERNARD MCINTOSH---City
- 23 GRACE ASHBURN---None
- 24 FRANCIS McTAVISH---None
- 25 JAMES CONWAY---City
- 26 RANDY LUKE---None
- 27 DEPARTMENT OF THE INTERIOR (U.S.A.)---None
- 28 MARY PILARZ---City
- 29 ROBERT ERCULIANI---City
- 30 ST. PATRICK'S CHURCH (CEMETARY)---None
- 31 EDWARD NAGLE---None
- 32 ALAN PITTSINGER---Well
- 33 FRANK KRATZER---Well
- 34 JOHN McTAVISH---None
- 35 THOMAS MANDICHAK---Well
- 36 JAMES MARUCA---None

*Extend Contours  
Add Elevations*

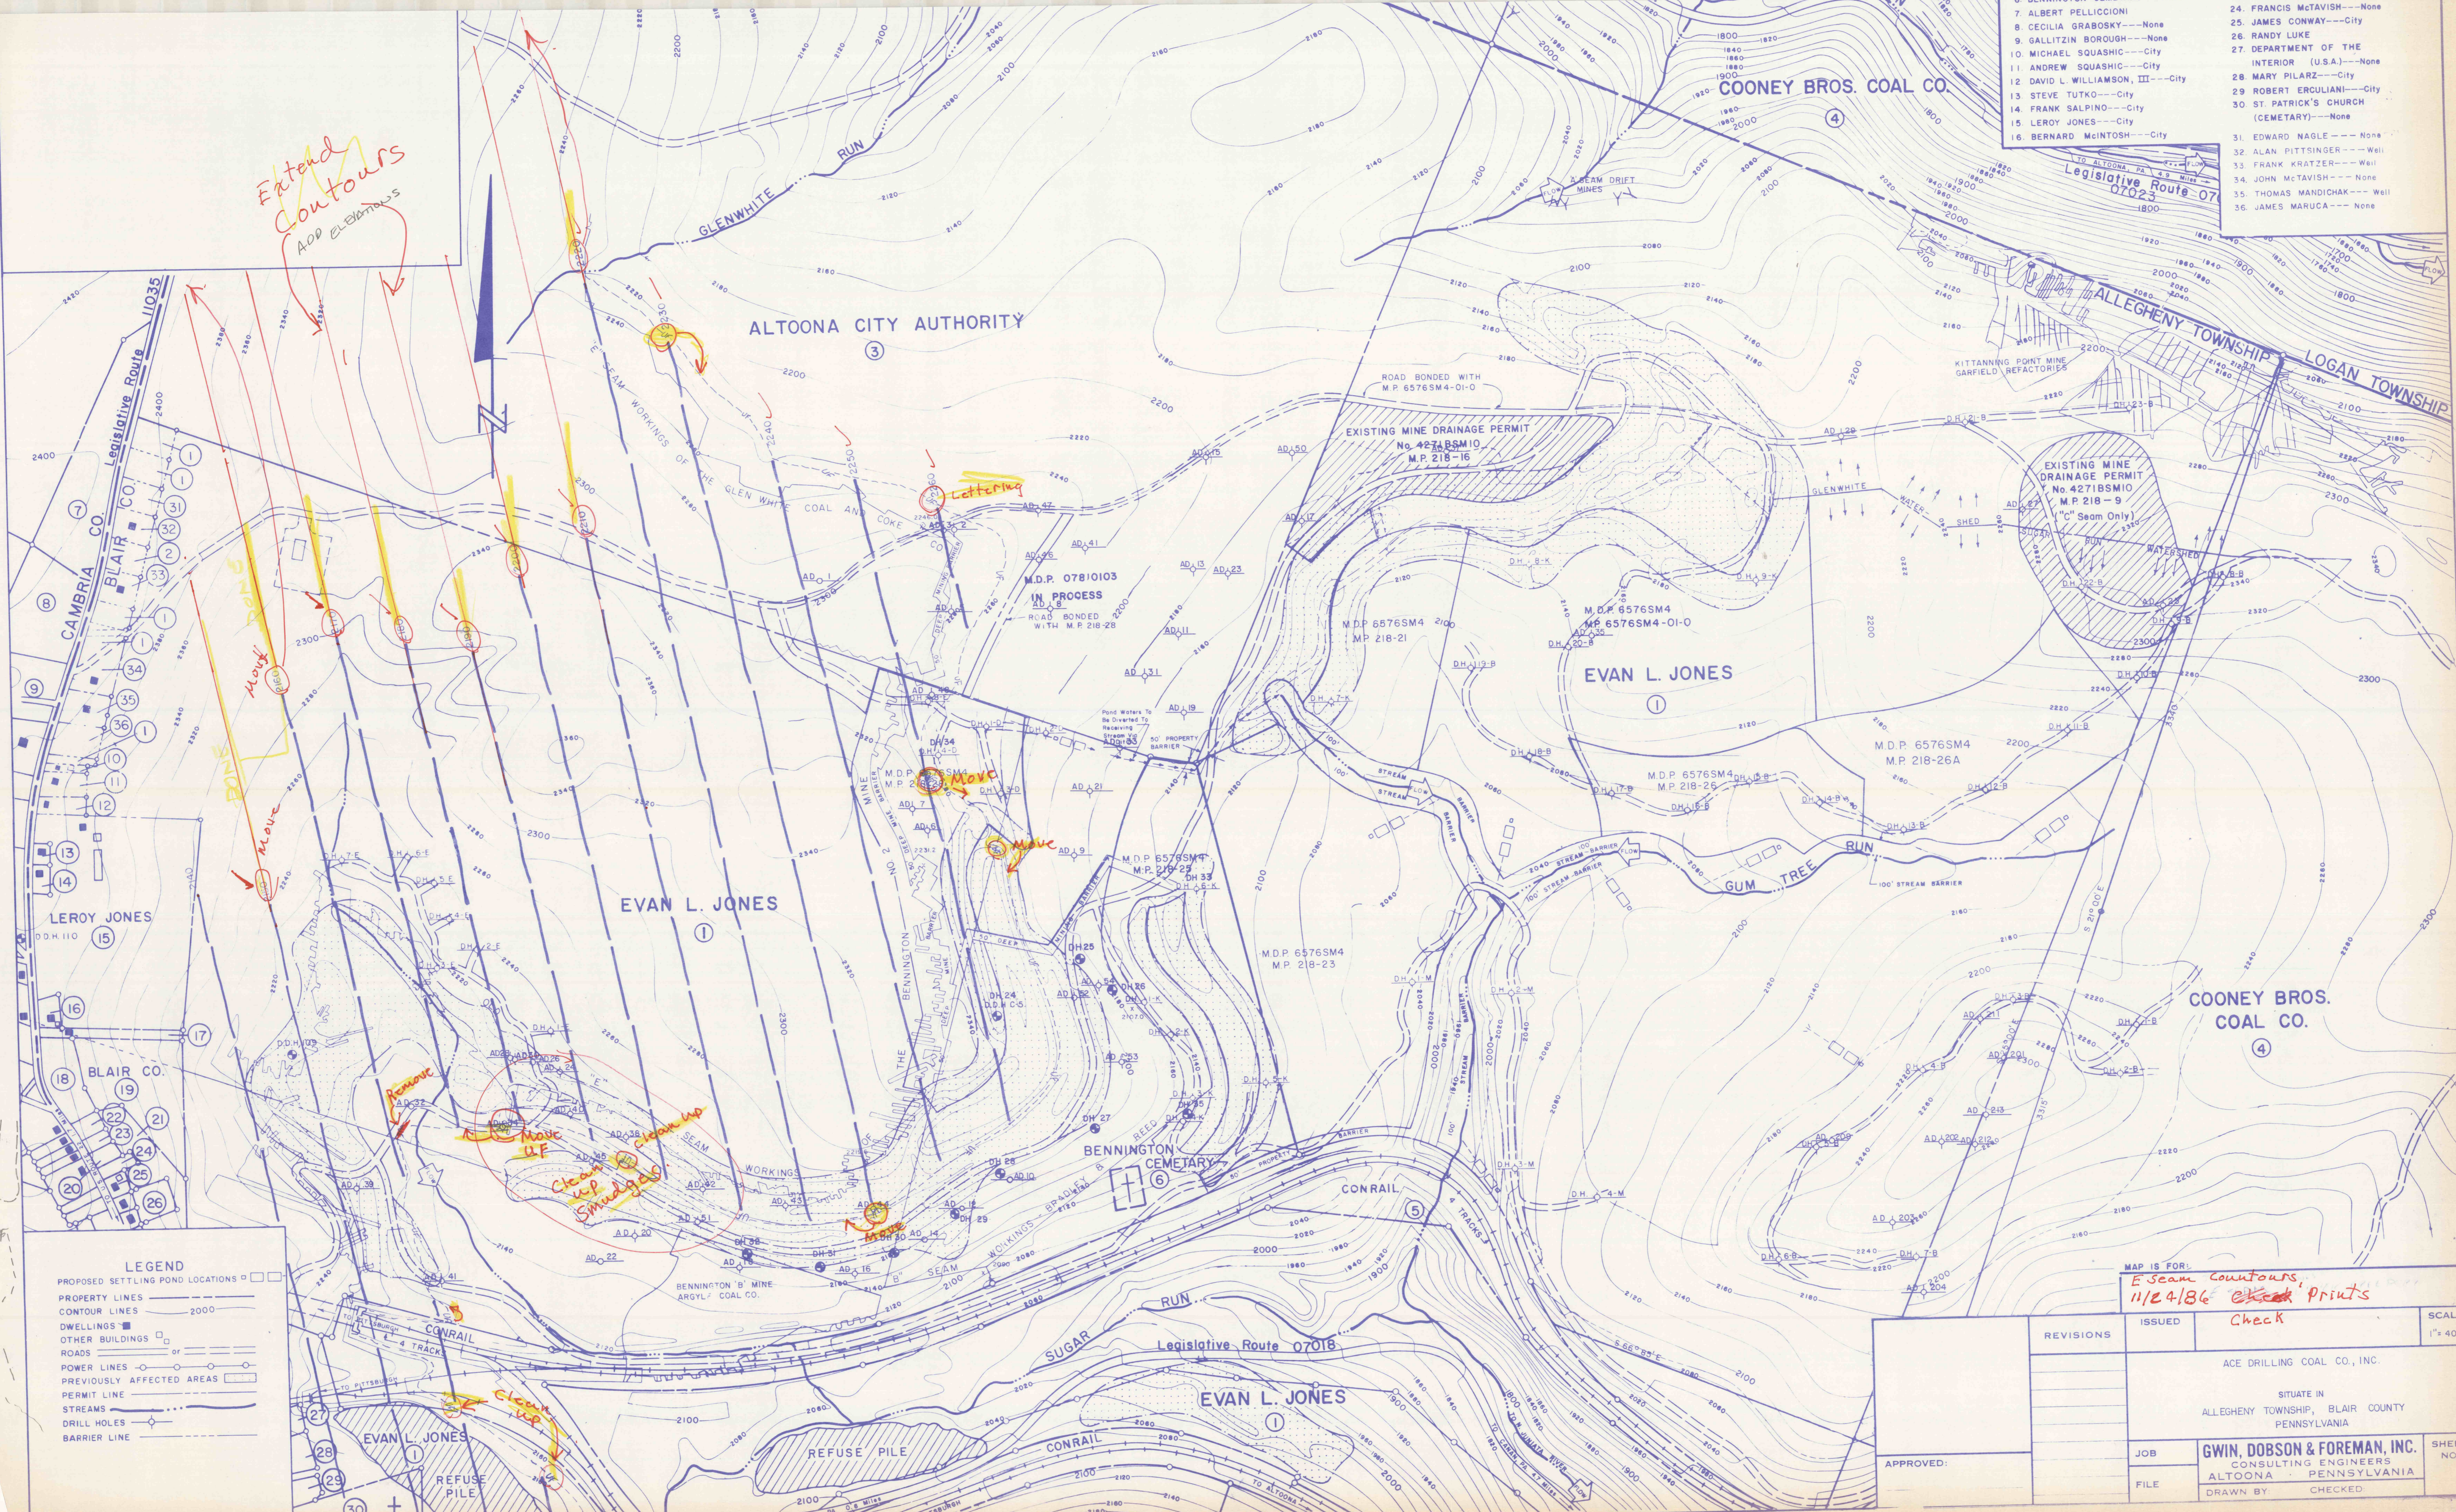

**LEGEND**

- PROPOSED SETTLING POND LOCATIONS □
- PROPERTY LINES ———
- CONTOUR LINES ——— 2000
- DWELLINGS ■
- OTHER BUILDINGS □
- ROADS ——— or ———
- POWER LINES ———
- PREVIOUSLY AFFECTED AREAS [Hatched]
- PERMIT LINE ———
- STREAMS ———
- DRILL HOLES ○
- BARRIER LINE - - - - -

MAP IS FOR:  
*E Seam Contours,  
11/24/86 Check Prints*

ISSUED	SCALE 1" = 400'
REVISIONS	ACE DRILLING COAL CO., INC.
APPROVED:	SITUATE IN ALLEGHENY TOWNSHIP, BLAIR COUNTY PENNSYLVANIA
JOB	<b>GWIN, DOBSON &amp; FOREMAN, INC.</b> CONSULTING ENGINEERS
FILE	ALTOONA PENNSYLVANIA DRAWN BY: CHECKED
	SHEET NO.