


WATER SOURCES

- 1. EVAN L. JONES --- None
- 3. ALTOONA CITY AUTHORITY --- None
- 4. COONEY BROS. COAL CO. --- None
- 5. PENN. CENTRAL RAILROAD --- None
- 6. BENNINGTON CEMETARY --- None
- 7. ALBERT PELLICIONI
- 8. CECILIA GRABOSKY --- None
- 9. GALLITZIN BOROUGH --- None
- 10. MICHAEL SQUASHIC --- City
- 11. ANDREW SQUASHIC --- City
- 12. DAVID L. WILLIAMSON, III --- City
- 13. STEVE TUTKO --- City
- 14. FRANK SALPINO --- City
- 15. LEROY JONES --- City
- 16. BERNARD McINTOSH --- City

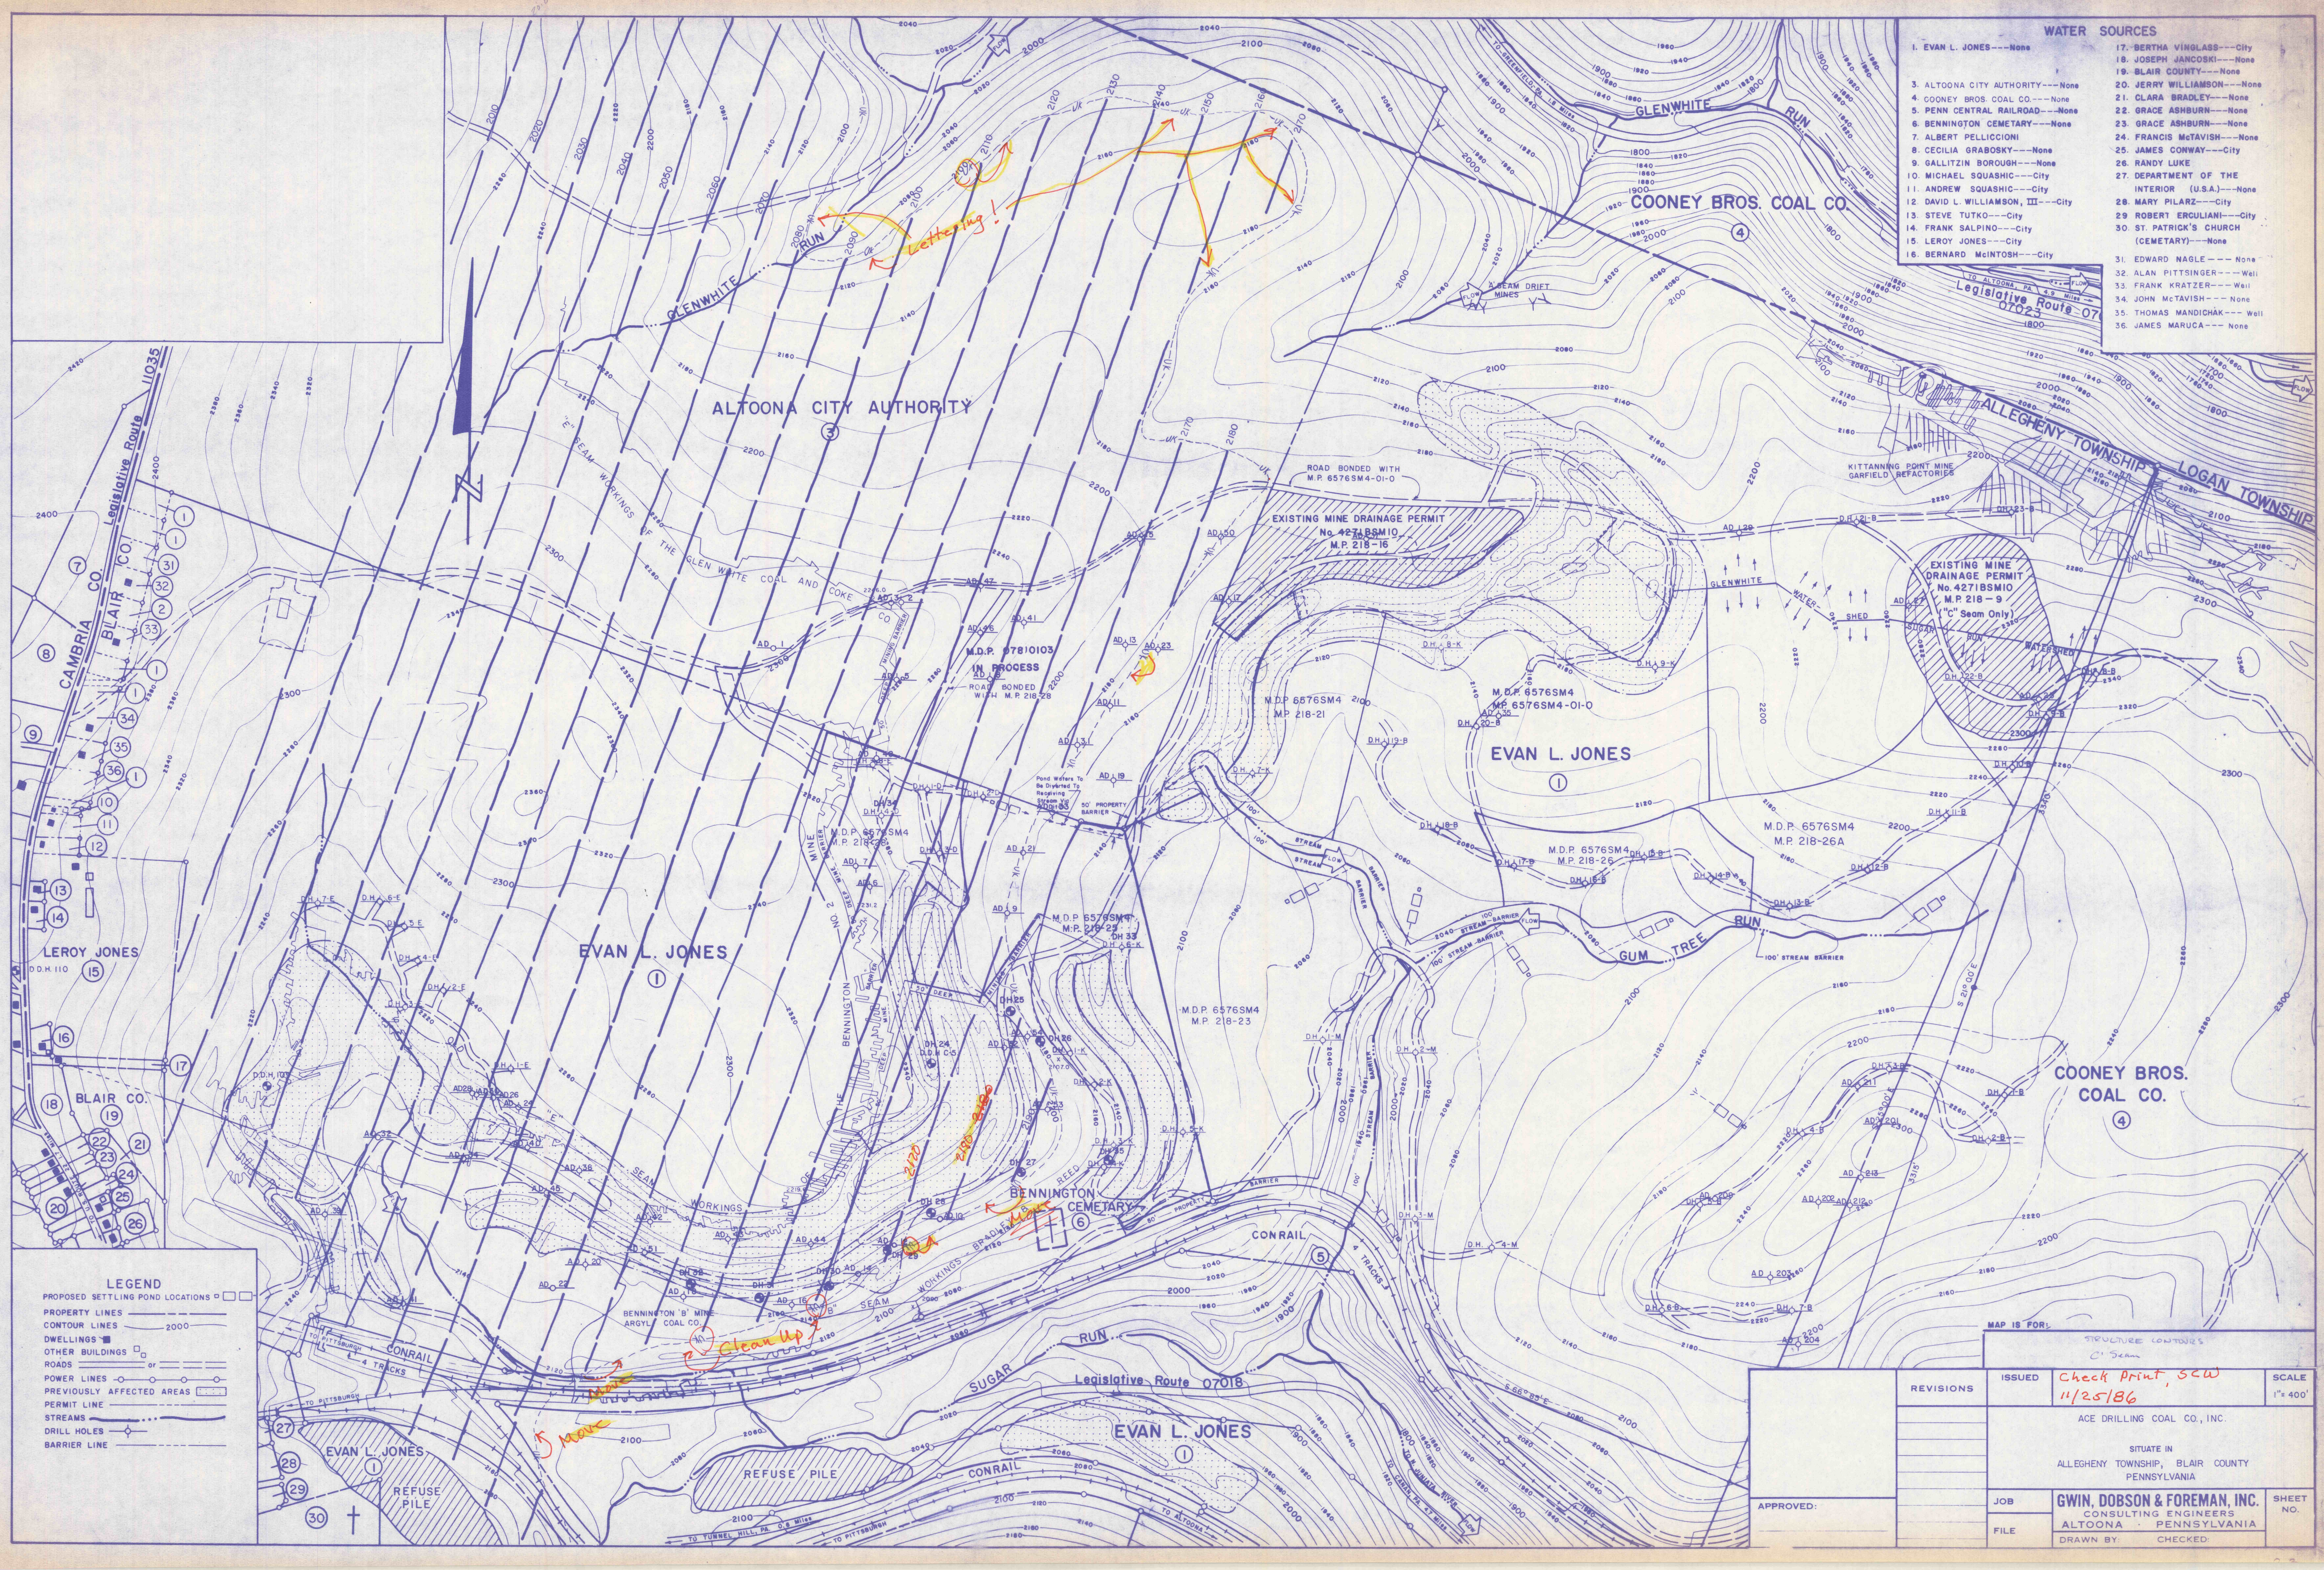

LEGEND

- PROPOSED SETTLING POND LOCATIONS □ □ □
- PROPERTY LINES ———
- CONTOUR LINES 2000
- DWELLINGS ■
- OTHER BUILDINGS □
- ROADS ——— or ———
- POWER LINES ———
- PREVIOUSLY AFFECTED AREAS [shaded]
- PERMIT LINE ———
- STREAMS ———
- DRILL HOLES ○
- BARRIER LINE ———

MAP IS FOR:		STRUCTURE CONTROLS C Seam	
ISSUED	11/25/86	CHECK PRINT, SCW	SCALE 1" = 400'
ACE DRILLING COAL CO., INC.			
SITUATE IN ALLEGHENY TOWNSHIP, BLAIR COUNTY PENNSYLVANIA			
APPROVED:	JOB	GWIN, DOBSON & FOREMAN, INC. CONSULTING ENGINEERS ALTOONA, PENNSYLVANIA	
FILE	FILE	DRAWN BY:	CHECKED: