


WATER SOURCES

- 1. EVAN L. JONES---None
- 2. ALTOONA CITY AUTHORITY---None
- 3. COONEY BROS. COAL CO.---None
- 4. PENN CENTRAL RAILROAD---None
- 5. BENNINGTON CEMETARY---None
- 6. ALBERT PELLICIONI
- 7. CECILIA GRABOSKY---None
- 8. GALLITZIN BOROUGH---None
- 9. MICHAEL SQUASHIC---City
- 10. ANDREW SQUASHIC---City
- 11. DAVID L. WILLIAMSON, III---City
- 12. STEVE TUTKO---City
- 13. FRANK SALPINO---City
- 14. LEROY JONES---City
- 15. BERNARD McINTOSH---City
- 16. BERTHA VINGLASS---City
- 17. JOSEPH JANCOSKI---None
- 18. BLAIR COUNTY---None
- 19. JERRY WILLIAMSON---None
- 20. CLARA BRADLEY---None
- 21. GRACE ASHBURN---None
- 22. BENNINGTON CEMETARY---None
- 23. FRANCIS McTAVISH---None
- 24. JAMES CONWAY---City
- 25. RANDY LUKE
- 26. DEPARTMENT OF THE INTERIOR (U.S.A.)---None
- 27. MARY PILARZ---City
- 28. ROBERT ERCULIANI---City
- 29. ST. PATRICK'S CHURCH (CEMETARY)---None
- 30. EDWARD NAGLE---None
- 31. ALAN PITTSINGER---Well
- 32. FRANK KRATZER---Well
- 33. JOHN McTAVISH---None
- 34. THOMAS MANDICHAK---Well
- 35. JAMES MARUCA---None

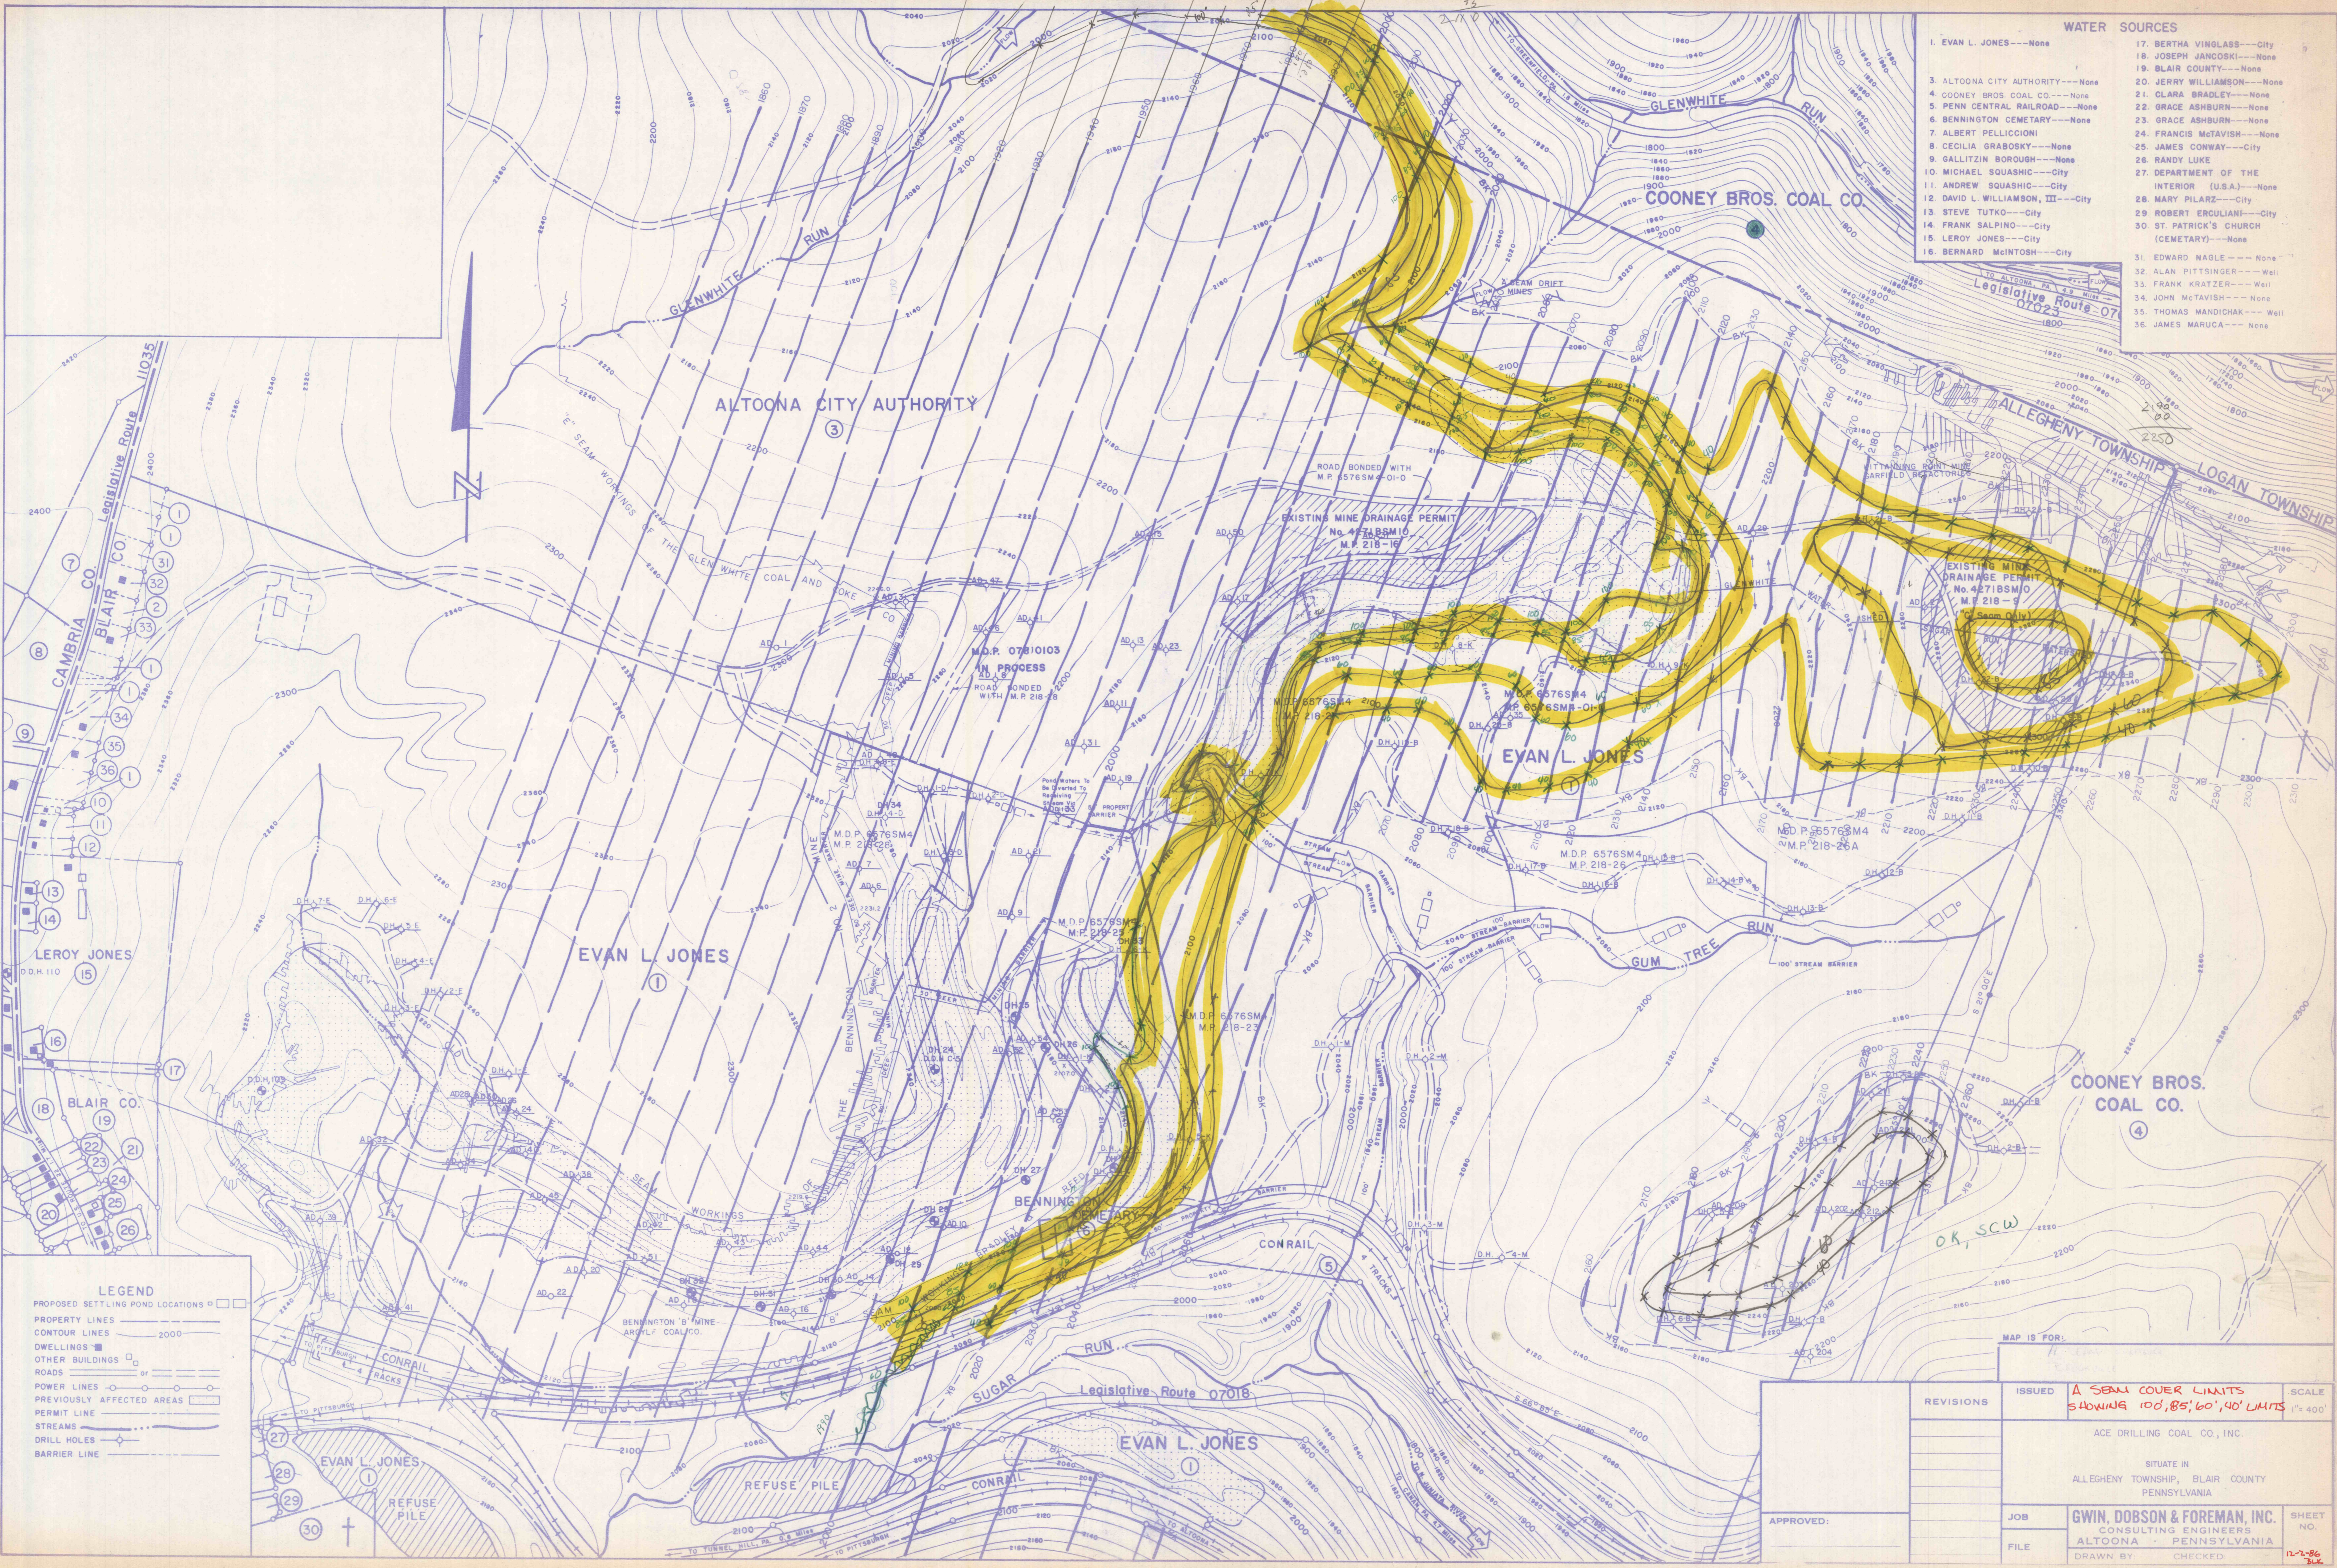

LEGEND

- PROPOSED SETTLING POND LOCATIONS □ □ □
- PROPERTY LINES ———
- CONTOUR LINES ——— 2000
- DWELLINGS ■
- OTHER BUILDINGS □
- ROADS ——— or ———
- POWER LINES ———
- PREVIOUSLY AFFECTED AREAS [Hatched Box]
- PERMIT LINE ———
- STREAMS ———
- DRILL HOLES ○
- BARRIER LINE - - - - -

MAP IS FOR:

ISSUED	A SEAM COVER LIMITS SHOWING 100', 85', 60', 40' LIMITS	SCALE	1" = 400'
REVISIONS			
ACE DRILLING COAL CO., INC.			
SITUATE IN ALLEGHENY TOWNSHIP, BLAIR COUNTY, PENNSYLVANIA			
JOB	GWIN, DOBSON & FOREMAN, INC. CONSULTING ENGINEERS ALTOONA, PENNSYLVANIA	SHEET NO.	
FILE	DRAWN BY: CHECKED:		12-2-86

APPROVED: