


LEGEND

- ACE DRILLING COAL CO., INC.
- SWISTOCK ASSOCIATES COAL CORR.
- SHERBINE COAL CO.
- CAVALIER COAL CO.
- WANT AREA (NO COAL)
- COVER LIMITS (100', 85', 60', 40')

WATER SOURCES

1. EVAN L. JONES --- None	17. BERTHA VINGLASS --- City
3. ALTOONA CITY AUTHORITY --- None	18. JOSEPH JANCOSKI --- None
4. COONEY BROS. COAL CO. --- None	19. BLAIR COUNTY --- None
5. PENN. CENTRAL RAILROAD --- None	20. JERRY WILLIAMSON --- None
6. BENNINGTON CEMETARY --- None	21. CLARA BRADLEY --- None
7. ALBERT PELLICIONI	22. GRACE ASHBURN --- None
8. CECILIA GRABOSKY --- None	23. GRACE ASHBURN --- None
9. GALLITZIN BOROUGH --- None	24. FRANCIS McTAVISH --- None
10. MICHAEL SQUASHIC --- City	25. JAMES CONWAY --- City
11. ANDREW SQUASHIC --- City	26. RANDY LUKE
12. DAVID L. WILLIAMSON, III --- City	27. DEPARTMENT OF THE INTERIOR (U.S.A.) --- None
13. STEVE TUTKO --- City	28. MARY PILARZ --- City
14. FRANK SALPINO --- City	29. ROBERT ERCLIANI --- City
15. LEROY JONES --- City	30. ST. PATRICK'S CHURCH (CEMETARY) --- None
16. BERNARD McINTOSH --- City	31. EDWARD NAGLE --- None
	32. ALAN PITTSINGER --- Well
	33. FRANK KRATZER --- Well
	34. JOHN McTAVISH --- None
	35. THOMAS MANDICHAK --- Well
	36. JAMES MARUCA --- None

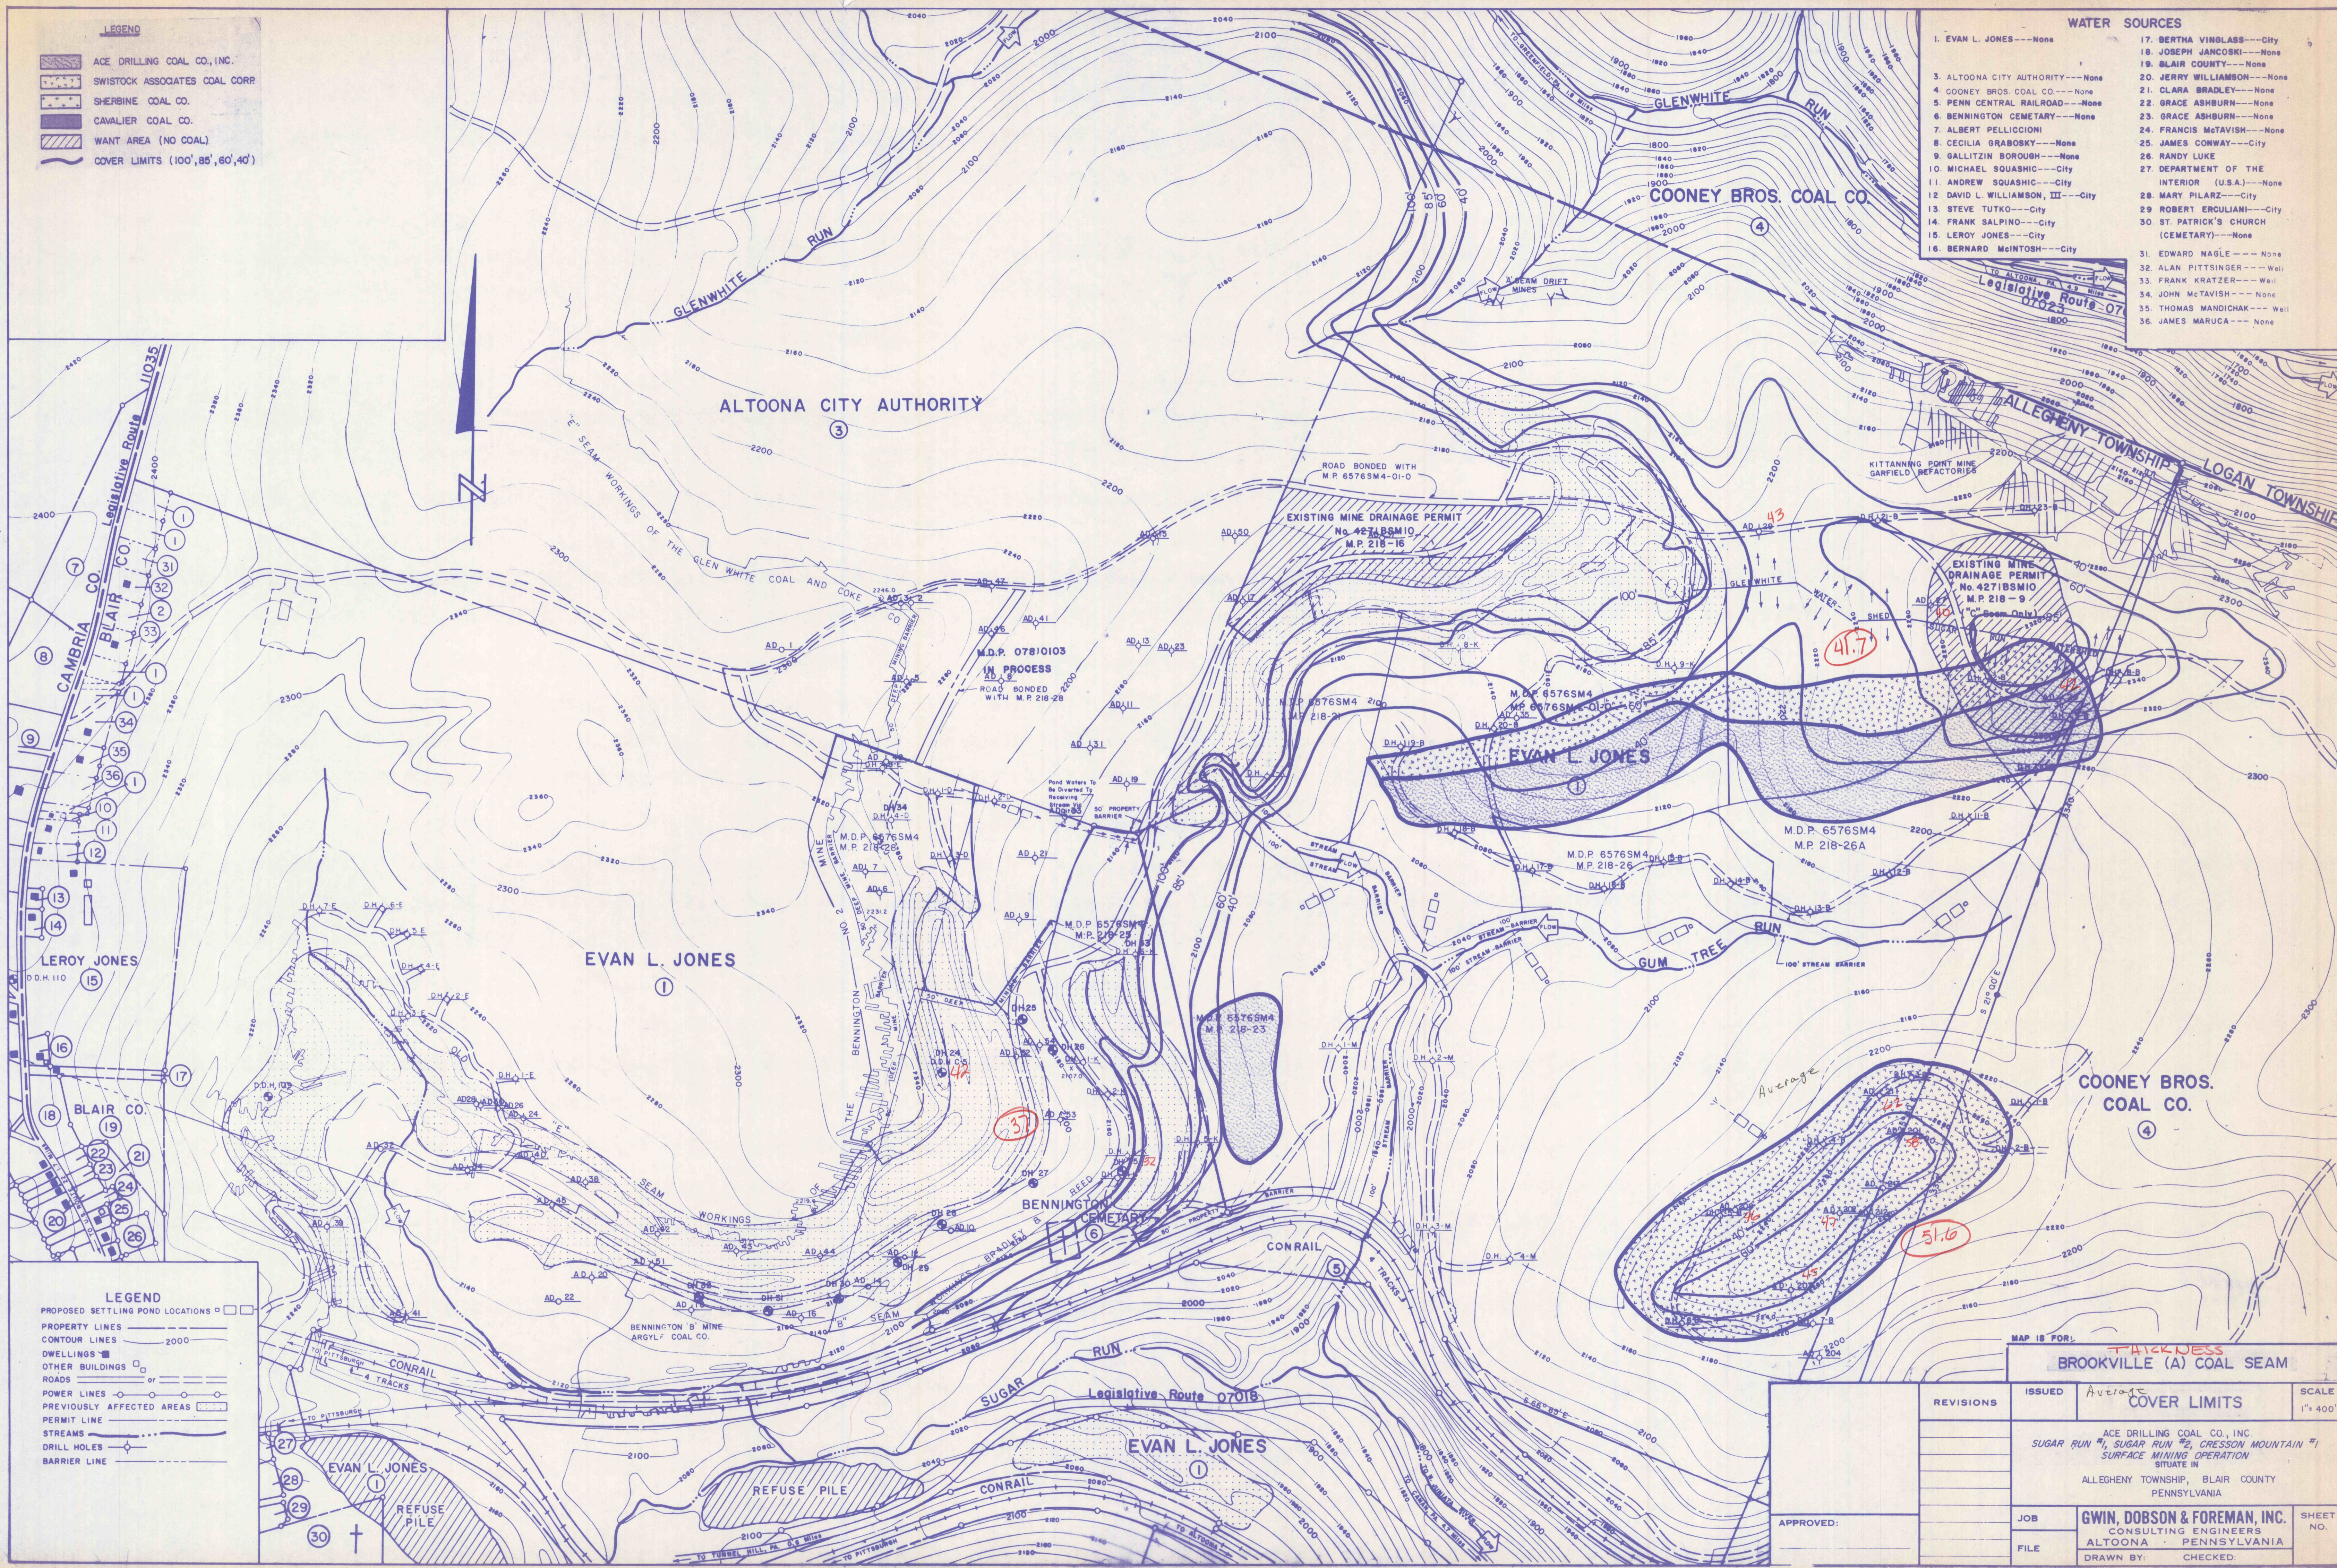

LEGEND

- PROPOSED SETTLING POND LOCATIONS
- PROPERTY LINES
- CONTOUR LINES 2000'
- DWELLINGS
- OTHER BUILDINGS
- ROADS
- POWER LINES
- PREVIOUSLY AFFECTED AREAS
- PERMIT LINE
- STREAMS
- DRILL HOLES
- BARRIER LINE

MAP IS FOR: **TRUCKESS BROOKVILLE (A) COAL SEAM**

REVISIONS	ISSUED	Average COVER LIMITS	SCALE 1" = 400'
		ACE DRILLING COAL CO., INC. SUGAR RUN #1, SUGAR RUN #2, CRESSON MOUNTAIN #1 SURFACE MINING OPERATION ALLEGHENY TOWNSHIP, BLAIR COUNTY PENNSYLVANIA	
		APPROVED:	
		JOB GWIN, DOBSON & FOREMAN, INC. CONSULTING ENGINEERS ALTOONA - PENNSYLVANIA	SHEET NO.
		FILE DRAWN BY: CHECKED:	