


**LEGEND**

- ACE DRILLING COAL CO., INC.
- SWISTOCK ASSOCIATES COAL CORP
- SHERBINE COAL CO.
- CAVALIER COAL CO.
- WANT AREA (NO COAL)
- COVER LIMITS (100', 85', 60', 40')

**WATER SOURCES**

1. EVAN L. JONES	None
2. ALTOONA CITY AUTHORITY	None
3. COONEY BROS. COAL CO.	None
4. PENN CENTRAL RAILROAD	None
5. BENNINGTON CEMETARY	None
6. ALBERT PELLICIONI	None
7. CECILIA GRABOSKY	None
8. GALLITZIN BOROUGH	None
9. MICHAEL SQUASHIC	City
10. ANDREW SQUASHIC	City
11. DAVID L. WILLIAMSON, III	City
12. STEVE TUTKO	City
13. FRANK SALPINO	City
14. LEROY JONES	City
15. BERNARD McINTOSH	City
16. BERTHA VINGLASS	City
17. JOSEPH JANCOSKI	None
18. BLAIR COUNTY	None
19. JERRY WILLIAMSON	None
20. CLARA BRADLEY	None
21. GRACE ASHBURN	None
22. GRACE ASHBURN	None
23. FRANCIS McTAVISH	None
24. JAMES CONWAY	City
25. RANDY LUKE	None
26. DEPARTMENT OF THE INTERIOR (U.S.A.)	None
27. MARY PILARZ	City
28. ROBERT ERCULIANI	City
29. ST. PATRICK'S CHURCH (CEMETARY)	None
30. EDWARD NAGLE	None
31. ALAN PITTSINGER	Well
32. FRANK KRATZER	Well
33. JOHN McTAVISH	None
34. THOMAS MANDICHAK	Well
35. JAMES MARUCA	None

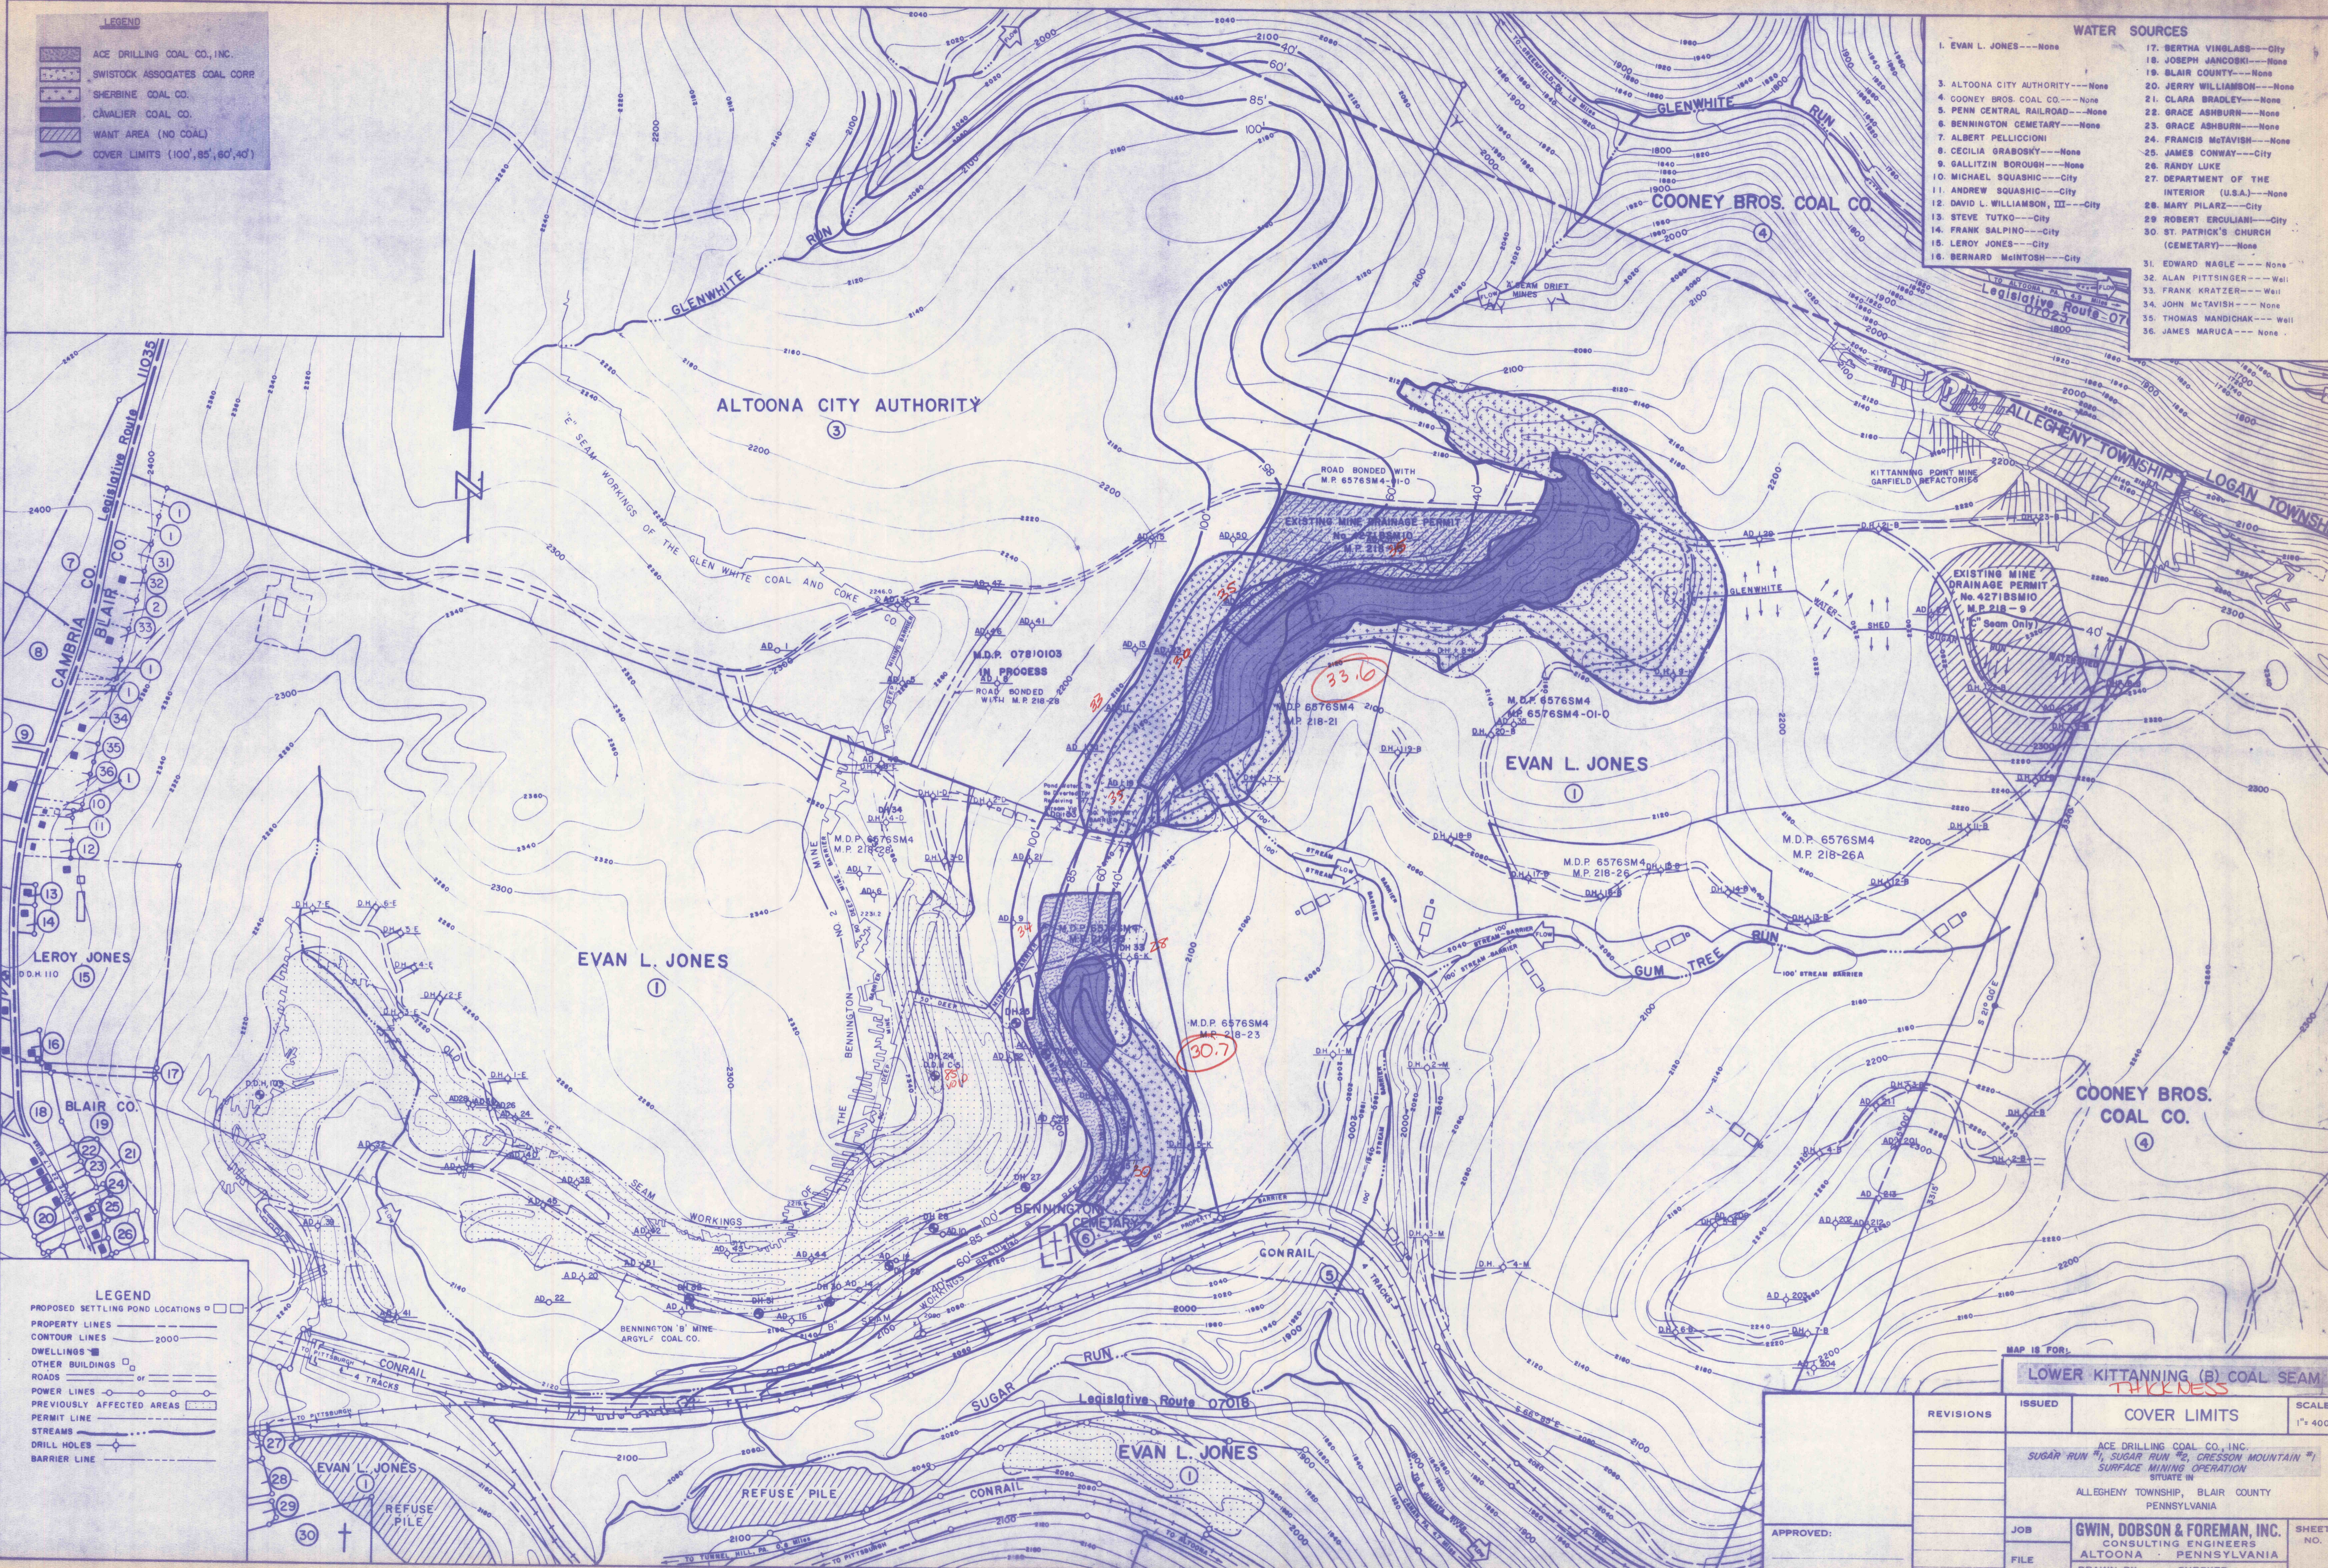

**LEGEND**

- PROPOSED SETTLING POND LOCATIONS
- PROPERTY LINES
- CONTOUR LINES 2000
- DWELLINGS
- OTHER BUILDINGS
- ROADS
- POWER LINES
- PREVIOUSLY AFFECTED AREAS
- PERMIT LINE
- STREAMS
- DRILL HOLES
- BARRIER LINE

MAP IS FOR:

**LOWER KITTANNING (B) COAL SEAM THICKNESS**

REVISIONS	ISSUED	COVER LIMITS	SCALE
		ACE DRILLING COAL CO., INC. SUGAR RUN #1, SUGAR RUN #2, GRESSON MOUNTAIN #1 SURFACE MINING OPERATION SITUATION III ALLEGHENY TOWNSHIP, BLAIR COUNTY PENNSYLVANIA	1" = 400'
APPROVED:	JOB	<b>GWIN, DOBSON &amp; FOREMAN, INC.</b> CONSULTING ENGINEERS ALTOONA - PENNSYLVANIA	SHEET NO.
	FILE	DRAWN BY: CHECKED:	