


LEGEND

- ACE DRILLING COAL CO., INC.
- SWISTOCK ASSOCIATES COAL CORP.
- SHERBINE COAL CO.
- CAVALIER COAL CO.
- WANT AREA (NO COAL)
- COVER LIMITS (100', 85', 60', 40')

WATER SOURCES

1. EVAN L. JONES---None
2. ALTOONA CITY AUTHORITY---None
3. ALTOONA CITY AUTHORITY---None
4. COONEY BROS. COAL CO.---None
5. PENN CENTRAL RAILROAD---None
6. BENNINGTON CEMETARY---None
7. ALBERT PELLICIONI
8. CECILIA GRABOSKY---None
9. GALLITZIN BOROUGH---None
10. MICHAEL SQUASHIC---City
11. ANDREW SQUASHIC---City
12. DAVID L. WILLIAMSON, III---City
13. STEVE TUTKO---City
14. FRANK SALPINO---City
15. LEROY JONES---City
16. BERNARD McINTOSH---City
17. BERTHA VINGLASS---City
18. JOSEPH JANCOSKI---None
19. BLAIR COUNTY---None
20. JERRY WILLIAMSON---None
21. CLARA BRADLEY---None
22. GRACE ASHBURN---None
23. GRACE ASHBURN---None
24. FRANCIS McTAVISH---None
25. JAMES CONWAY---City
26. RANDY LUKE
27. DEPARTMENT OF THE INTERIOR (U.S.A.)---None
28. MARY PILARZ---City
29. ROBERT ERCOLIANI---City
30. ST. PATRICK'S CHURCH (CEMETARY)---None
31. EDWARD NAGLE---None
32. ALAN PITTSINGER---Well
33. FRANK KRATZER---Well
34. JOHN McTAVISH---None
35. THOMAS MANDICHAK---Well
36. JAMES MARUCA---None

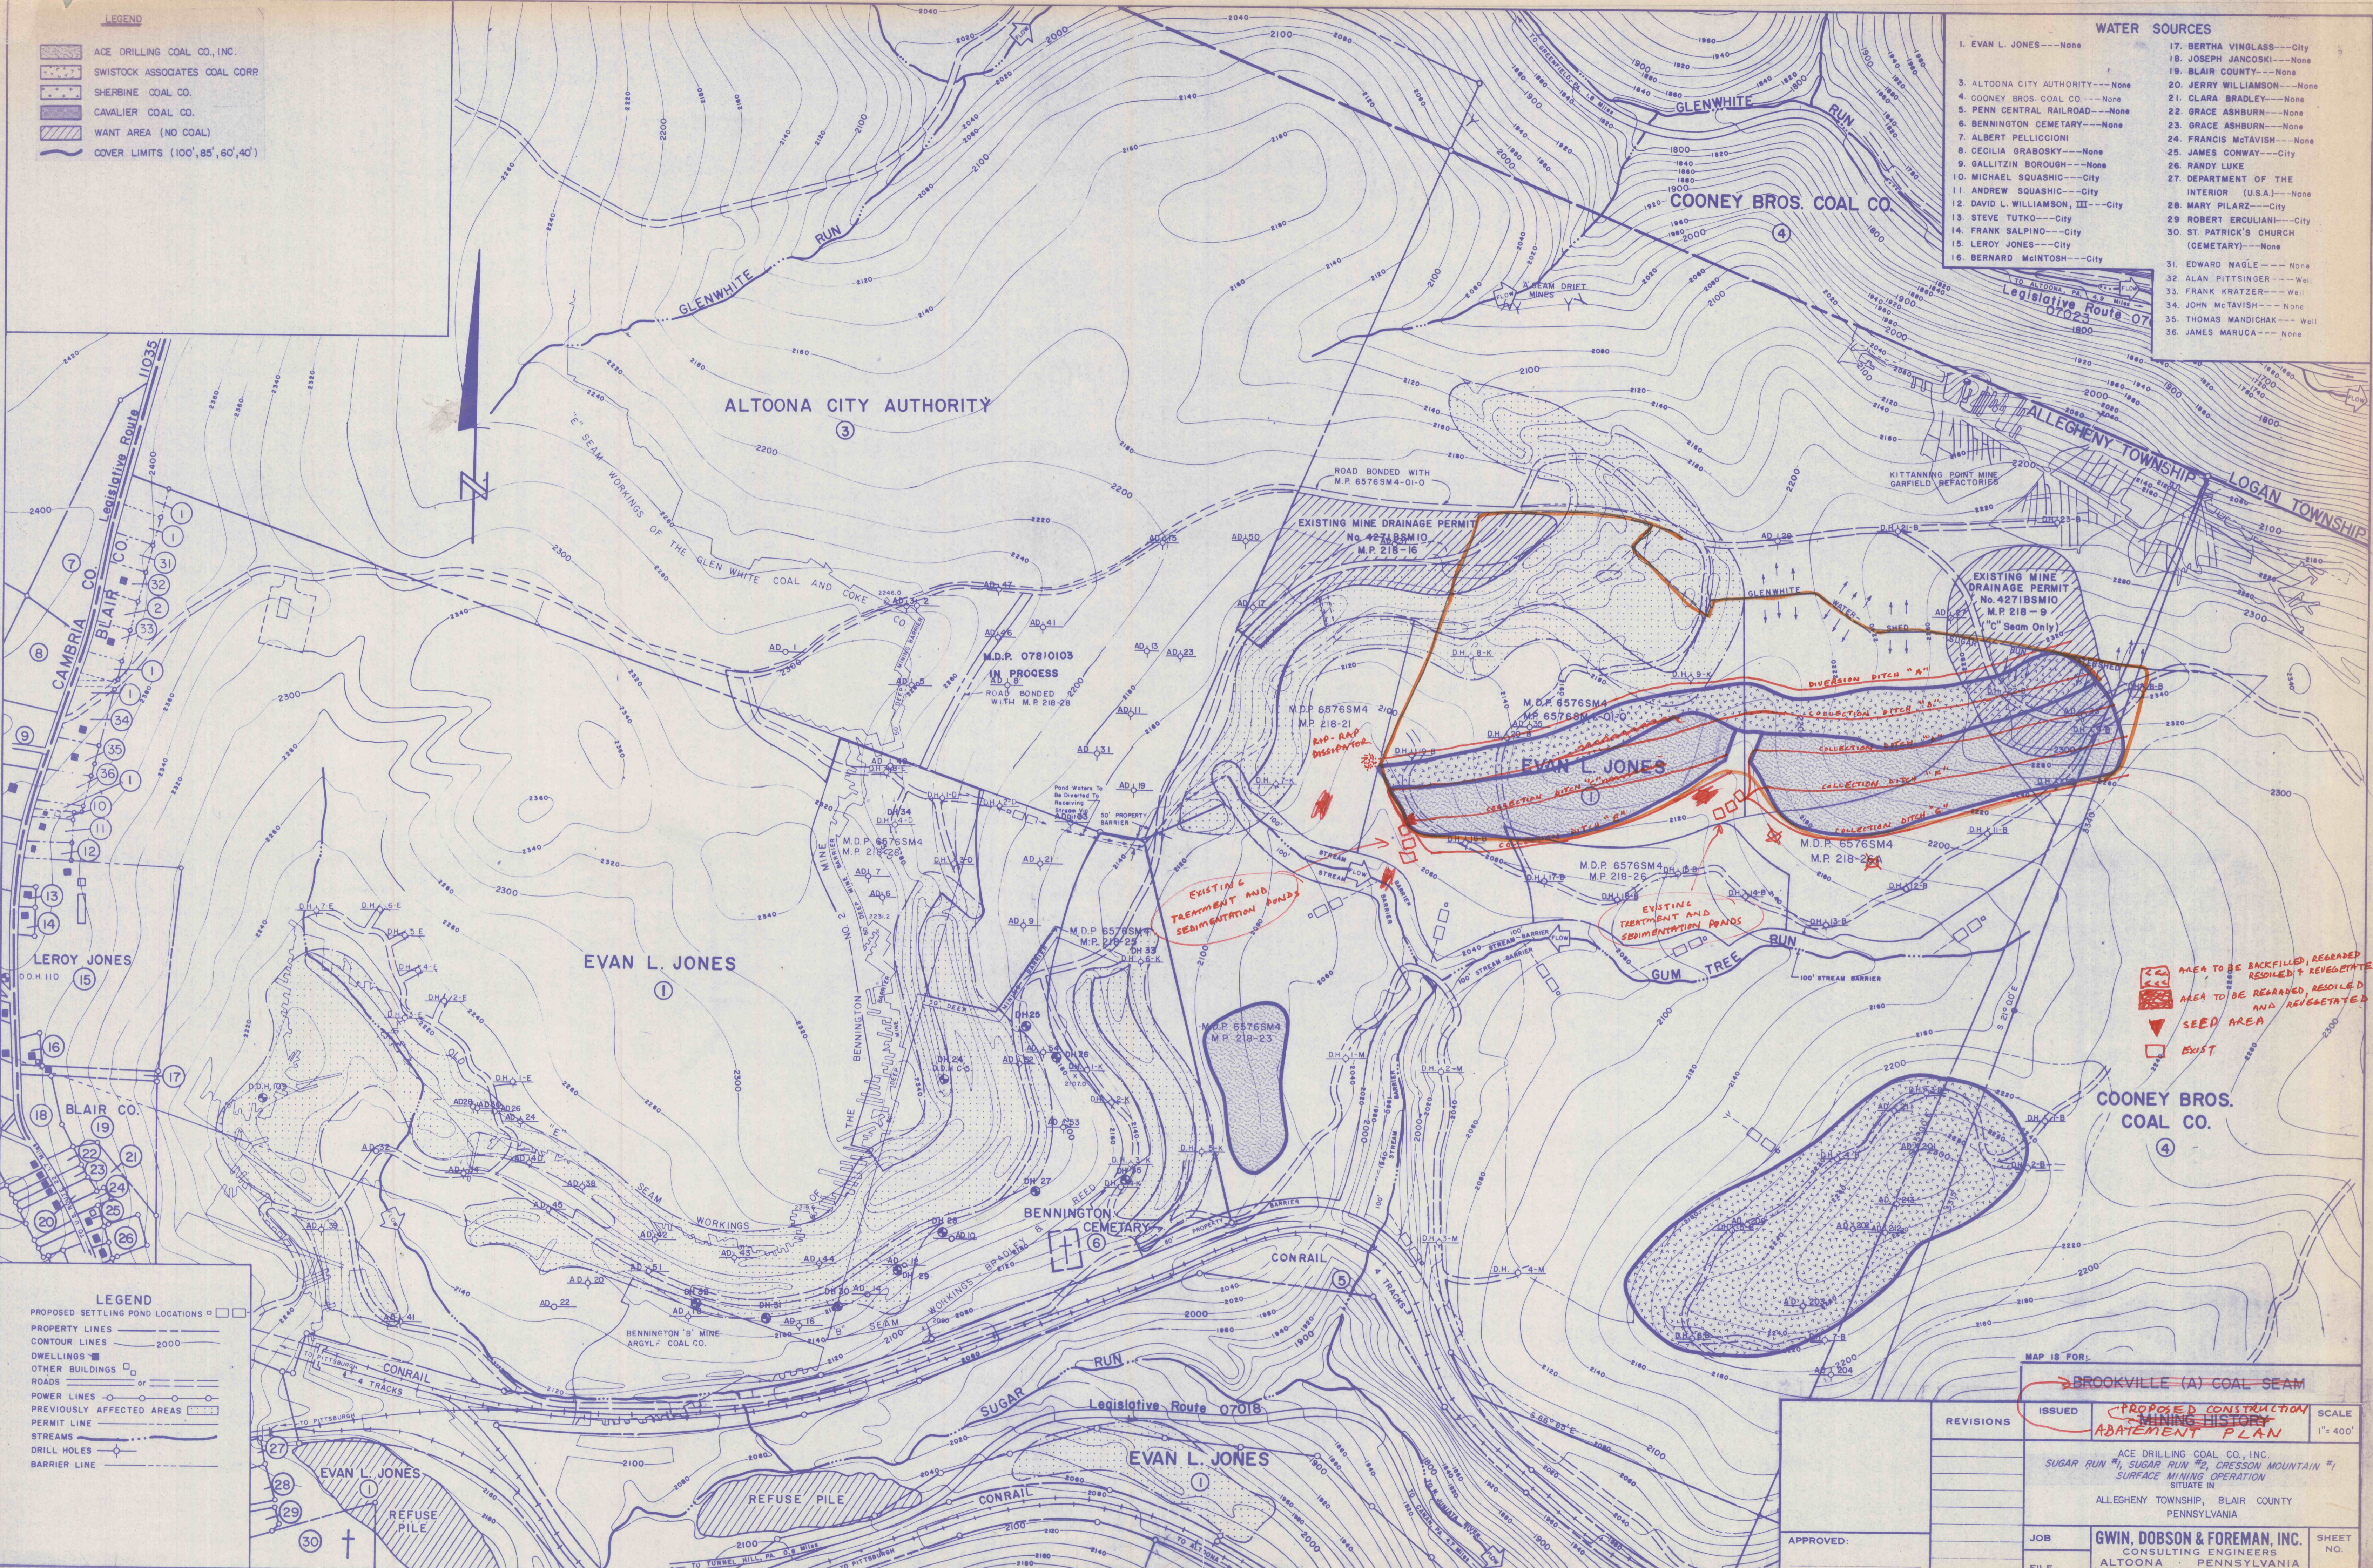

AREA TO BE BACKFILLED, REGRADED, RESOLDED & REVEGETATED
 AREA TO BE REGRADED, RESOLDED AND REVEGETATED
 SEED AREA
 EXIST

- LEGEND
- PROPOSED SETTLING POND LOCATIONS
 - PROPERTY LINES
 - CONTOUR LINES 2000
 - DWELLINGS
 - OTHER BUILDINGS
 - ROADS
 - POWER LINES
 - PREVIOUSLY AFFECTED AREAS
 - PERMIT LINE
 - STREAMS
 - DRILL HOLES
 - BARRIER LINE

MAP IS FOR:
 BROOKVILLE (A) COAL SEAM

ISSUED	PROPOSED CONSTRUCTION MINING HISTORY ABATEMENT PLAN	SCALE 1" = 400'
REVISIONS	ACE DRILLING COAL CO., INC. SUGAR RUN #1, SUGAR RUN #2, CRESSON MOUNTAIN #1 SURFACE MINING OPERATION SITUATE IN ALLEGHENY TOWNSHIP, BLAIR COUNTY PENNSYLVANIA	
APPROVED:	JOB GWIN, DOBSON & FOREMAN, INC. CONSULTING ENGINEERS ALTOONA - PENNSYLVANIA	SHEET NO.
FILE	DRAWN BY: CHECKED:	