


- LEGEND**
- ACE DRILLING COAL CO., INC.
 - SWISTOCK ASSOCIATES COAL CORP.
 - SHERBINE COAL CO.
 - CAVALIER COAL CO.
 - WANT AREA (NO COAL)
 - COVER LIMITS (100', 85', 60', 40')

- WATER SOURCES**
1. EVAN L. JONES --- None
 2. ALTOONA CITY AUTHORITY --- None
 3. COONEY BROS. COAL CO. --- None
 4. PENN. CENTRAL RAILROAD --- None
 5. BENNINGTON CEMETARY --- None
 6. ALBERT PELLICIONI
 7. CECILIA GRABOSKY --- None
 8. GALLITZIN BOROUGH --- None
 9. MICHAEL SQUASHIC --- City
 10. ANDREW SQUASHIC --- City
 11. DAVID L. WILLIAMSON, III --- City
 12. STEVE TUTKO --- City
 13. FRANK SALPINO --- City
 14. LEROY JONES --- City
 15. BERNARD McINTOSH --- City
 16. BERTHA VINGLASS --- City
 17. JOSEPH JANCOSKI --- None
 18. BLAIR COUNTY --- None
 19. CLARA BRADLEY --- None
 20. JERRY WILLIAMSON --- None
 21. GRACE ASHBURN --- None
 22. GRACE ASHBURN --- None
 23. FRANCIS McTAVISH --- None
 24. JAMES CONWAY --- City
 25. RANDY LUKE
 26. DEPARTMENT OF THE INTERIOR (U.S.A.) --- None
 27. MARY PILARZ --- City
 28. ROBERT ERULIANI --- City
 29. ST. PATRICK'S CHURCH (CEMETARY) --- None
 30. EDWARD NAGLE --- None
 31. ALAN PITTSINGER --- Well
 32. FRANK KRATZER --- Well
 33. JOHN McTAVISH --- None
 34. THOMAS MANDICHAK --- Well
 35. JAMES MARUCA --- None

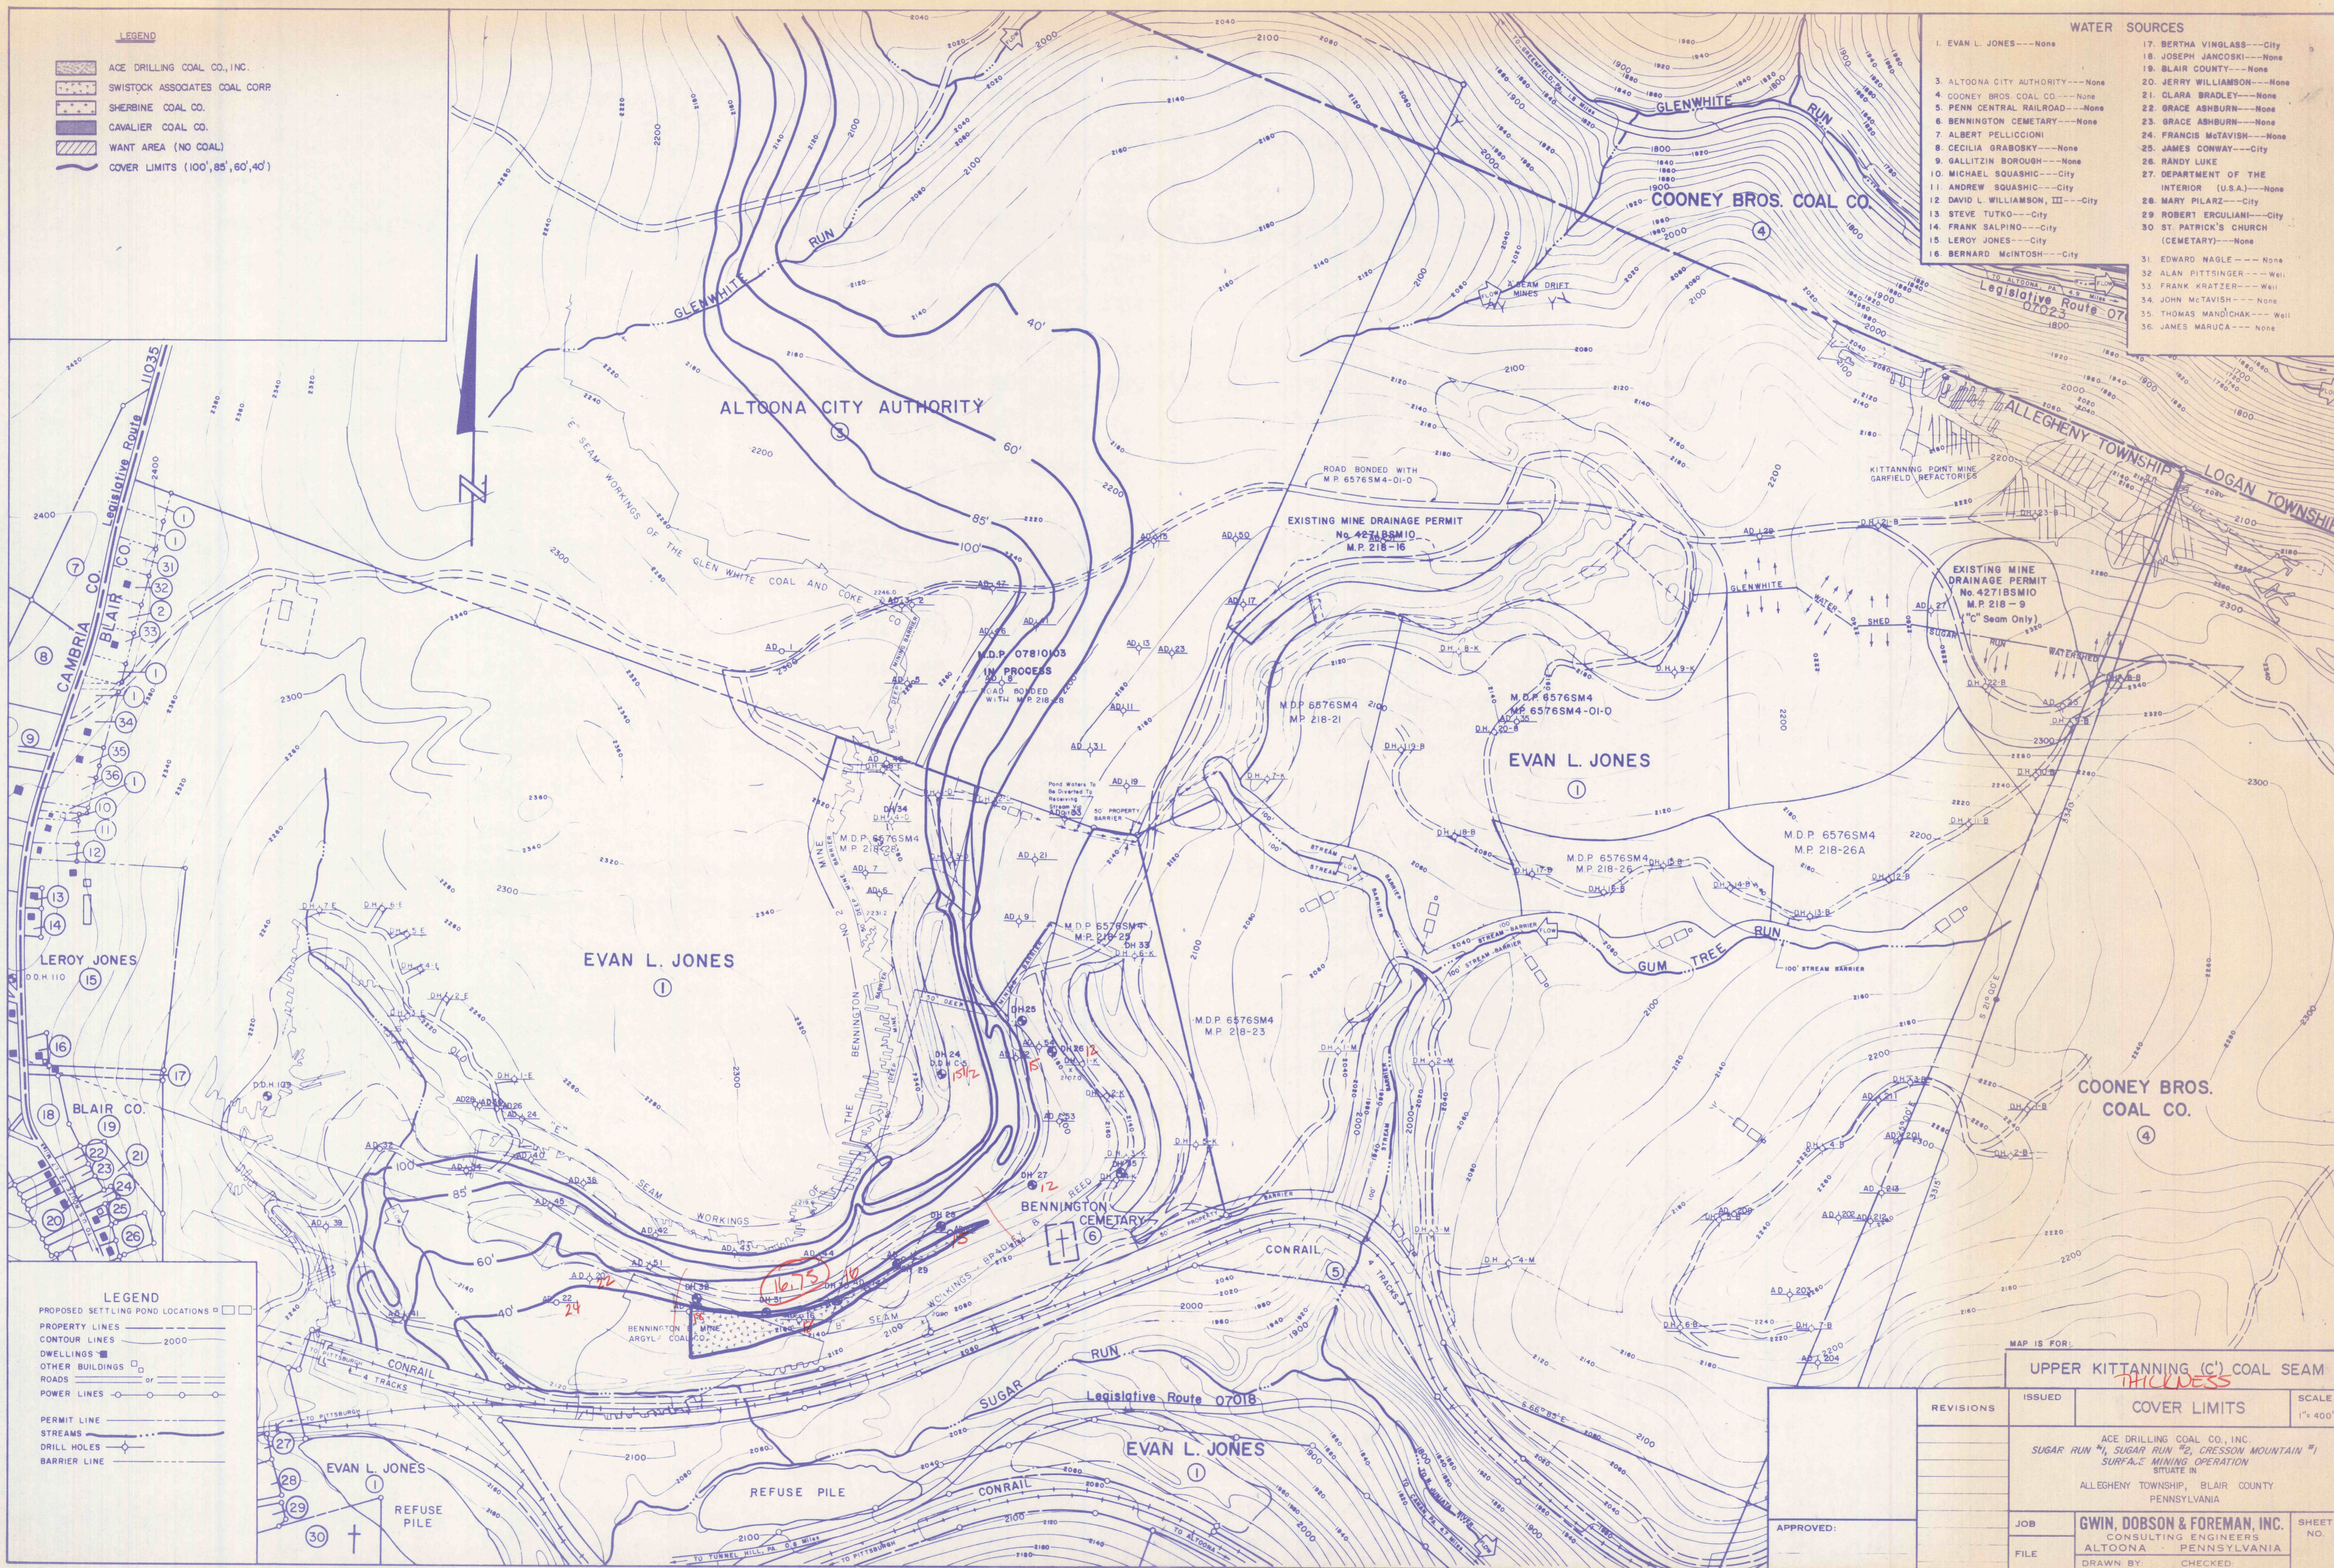

- LEGEND**
- PROPOSED SETTLING POND LOCATIONS
 - PROPERTY LINES
 - CONTOUR LINES 2000
 - DWELLINGS
 - OTHER BUILDINGS
 - ROADS
 - POWER LINES
 - PERMIT LINE
 - STREAMS
 - DRILL HOLES
 - BARRIER LINE

MAP IS FOR:
UPPER KITTANNING (C) COAL SEAM
THICKNESS

REVISIONS	ISSUED	COVER LIMITS	SCALE
		ACE DRILLING COAL CO., INC. SUGAR RUN #1, SUGAR RUN #2, CRESSON MOUNTAIN #1 SURFACE MINING OPERATION SITUATE IN ALLEGHENY TOWNSHIP, BLAIR COUNTY PENNSYLVANIA	1" = 400'
APPROVED:	JOB	GWIN, DOBSON & FOREMAN, INC. CONSULTING ENGINEERS ALTOONA - PENNSYLVANIA	SHEET NO.
	FILE	DRAWN BY: CHECKED:	