


LEGEND

- STRUCTURE CONTOURS
- MK MIDDLE KITTANNING OUTCROP
- INFERRED LOCATION OF THE LOWER KITTANNING OUTCROP

WATER SOURCES

- EVAN L. JONES --- None
- JOSEPH JANCOSKI --- None
- BLAIR COUNTY --- None
- ALTOONA CITY AUTHORITY --- None
- COONEY BROS. COAL CO. --- None
- PENN CENTRAL RAILROAD --- None
- BENNINGTON CEMETARY --- None
- ALBERT PELLICIONI --- None
- CECILIA GRABOSKY --- None
- GALLITZIN BOROUSH --- None
- MICHAEL SQUASHIC --- City
- ANDREW SQUASHIC --- City
- DAVID L. WILLIAMSON, III --- City
- STEVE TUTKO --- City
- FRANK SALPINO --- City
- LEROY JONES --- City
- BERNARD MCINTOSH --- City
- BERTHA VINGLASS --- City
- JERRY WILLIAMSON --- None
- BLAIR COUNTY --- None
- JERRY WILLIAMSON --- None
- CLARA BRADLEY --- None
- GRACE ASHBURN --- None
- FRANCIS ASHBURN --- None
- ALBERT PELLICIONI --- None
- JAMES CONWAY --- City
- RANDY LUKE --- None
- DEPARTMENT OF THE INTERIOR (U.S.A.) --- None
- MARY PILARZ --- City
- ROBERT ERCULIANI --- City
- ST. PATRICK'S CHURCH (CEMETARY) --- None
- EDWARD NAGLE --- None
- ALAN PITTSINGER --- Well
- FRANK KRATZER --- Well
- JOHN McTAVISH --- None
- THOMAS MANDICHAK --- Well
- JAMES MARUCA --- None

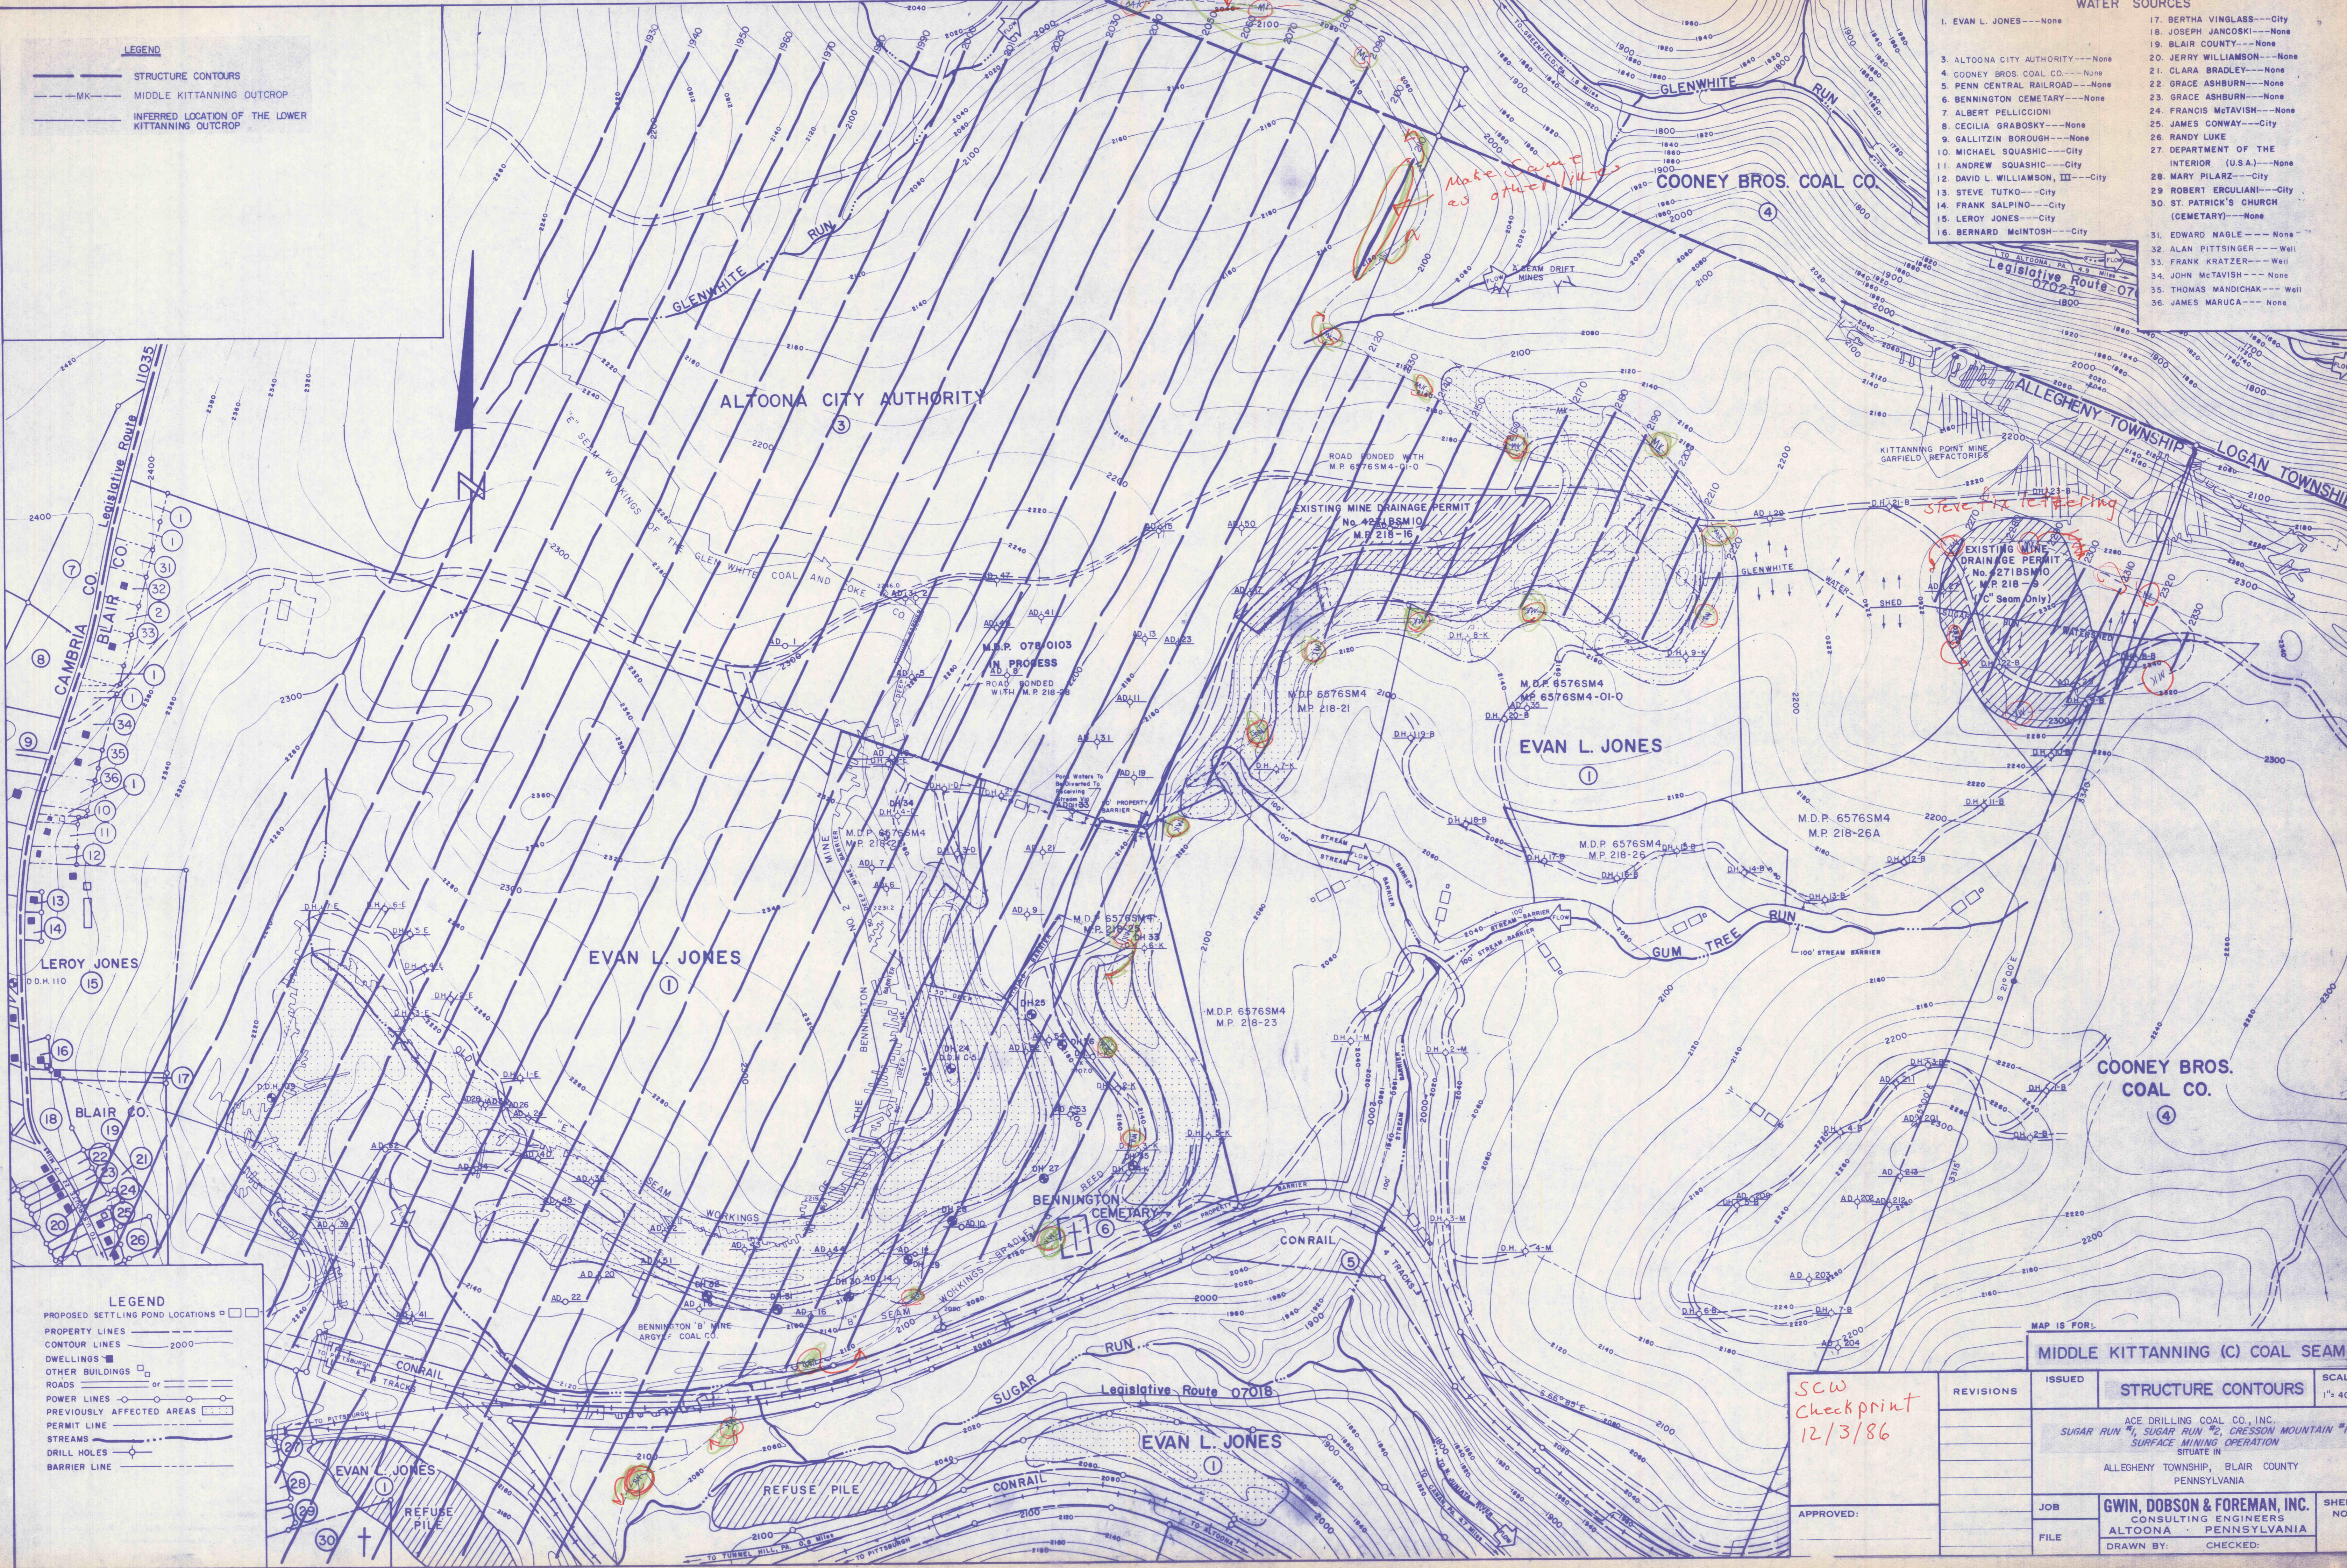

- PROPOSED SETTLING POND LOCATIONS
- PROPERTY LINES
- CONTOUR LINES 2000
- DWELLINGS
- OTHER BUILDINGS
- ROADS or
- POWER LINES
- PREVIOUSLY AFFECTED AREAS
- PERMIT LINE
- STREAMS
- DRILL HOLES
- BARRIER LINE

MAP IS FOR: MIDDLE KITTANNING (C) COAL SEAM

SCW  
checkprint  
12/3/86

REVISIONS	ISSUED	STRUCTURE CONTOURS	SCALE
		ACE DRILLING COAL CO., INC. SUGAR RUN #1, SUGAR RUN #2, CRESSON MOUNTAIN #1 SURFACE MINING OPERATION SITUATE IN ALLEGHENY TOWNSHIP, BLAIR COUNTY PENNSYLVANIA	1" = 400'
		JOB	GWIN, DOBSON & FOREMAN, INC. CONSULTING ENGINEERS ALTOONA - PENNSYLVANIA
		FILE	SHEET NO.
		APPROVED:	DRAWN BY: CHECKED: