


THE 3^d OF LOWER KITTANNING COAL LANDS & WORKINGS
 in SUSQUEHANNA & ADJOINING TOWNSHIPS
 CAMBRIA COUNTY, PENNSYLVANIA

RICH HILL COAL MINING CORPORATION
 ENGINEERING DEPARTMENT
 PORTAGE, PENNSYLVANIA

CONTOUR INTERVAL - 100'
 SCALE 1"=1000'
 DATE

- HEAVY-DUTY ROAD
- MEDIUM-DUTY ROAD
- LIGHT-DUTY ROAD
- TOWNSHIP & BOROUGH LINES
- COUNTY LINE
- PROPERTY LINE
- RAILROAD
- WATER COURSE

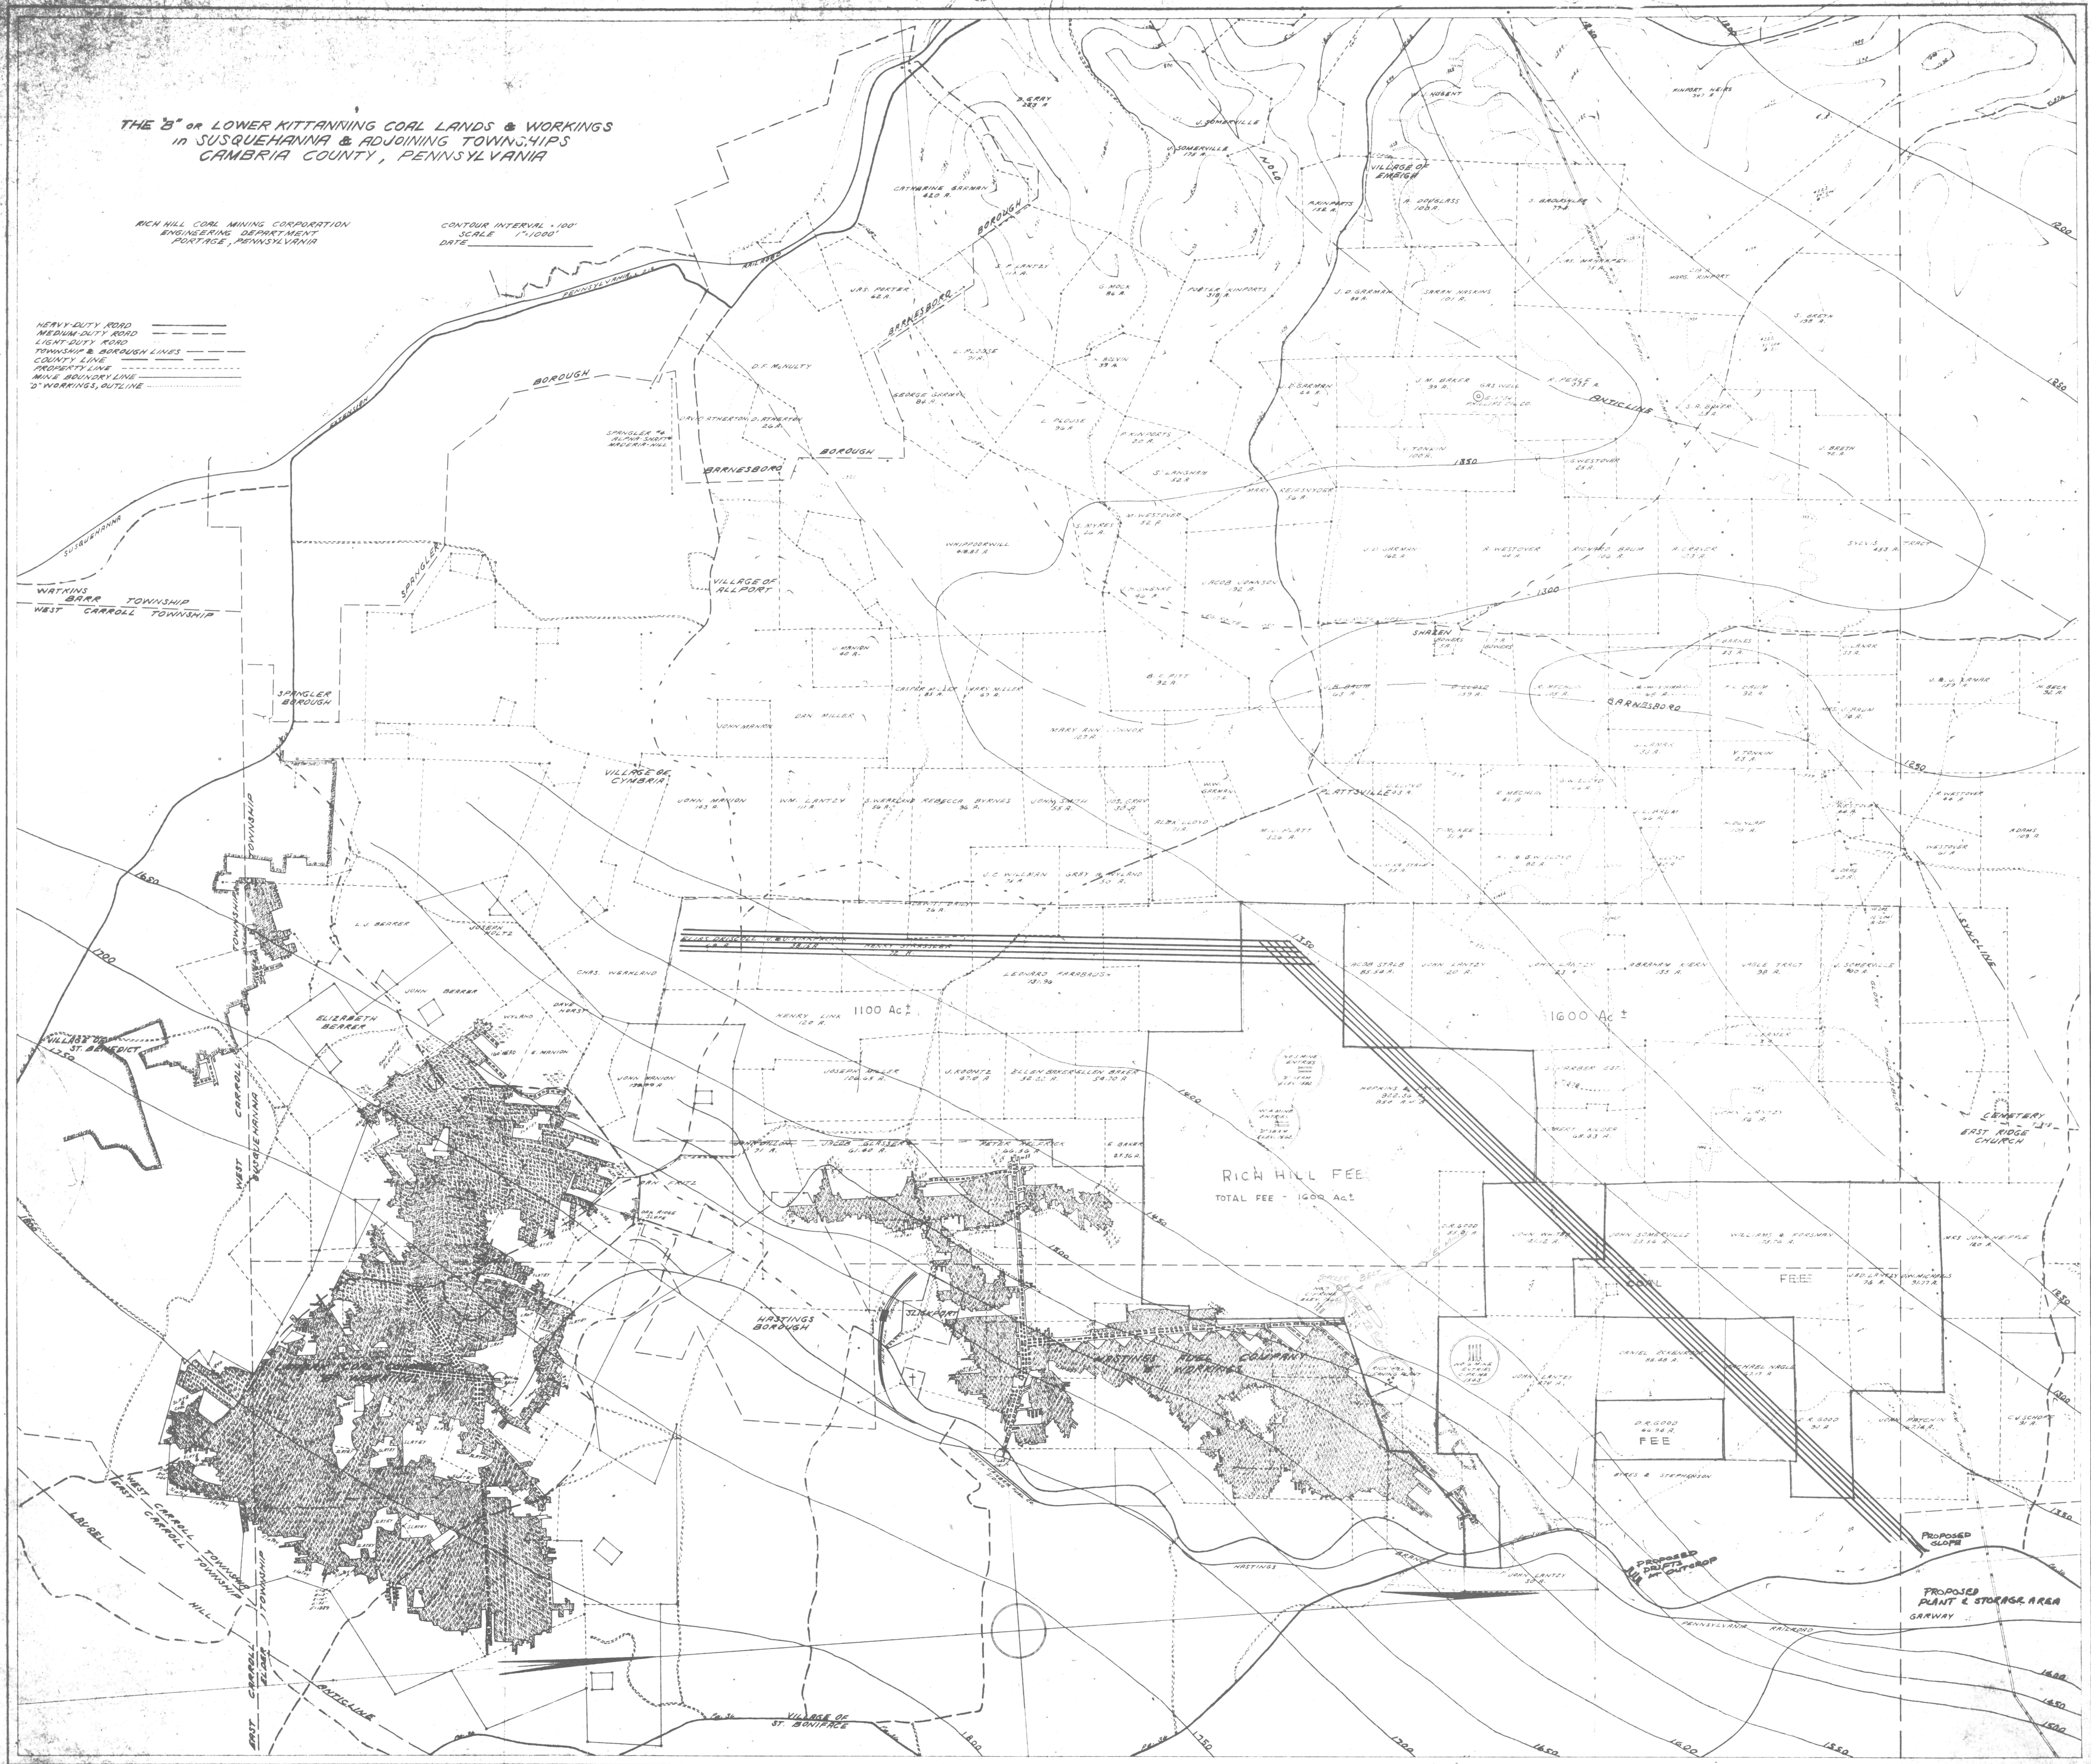

RICH HILL FEE
 TOTAL FEE - 1600 Ac.

FEE

PROPOSED PLANT & STORAGE AREA
 GARWAY