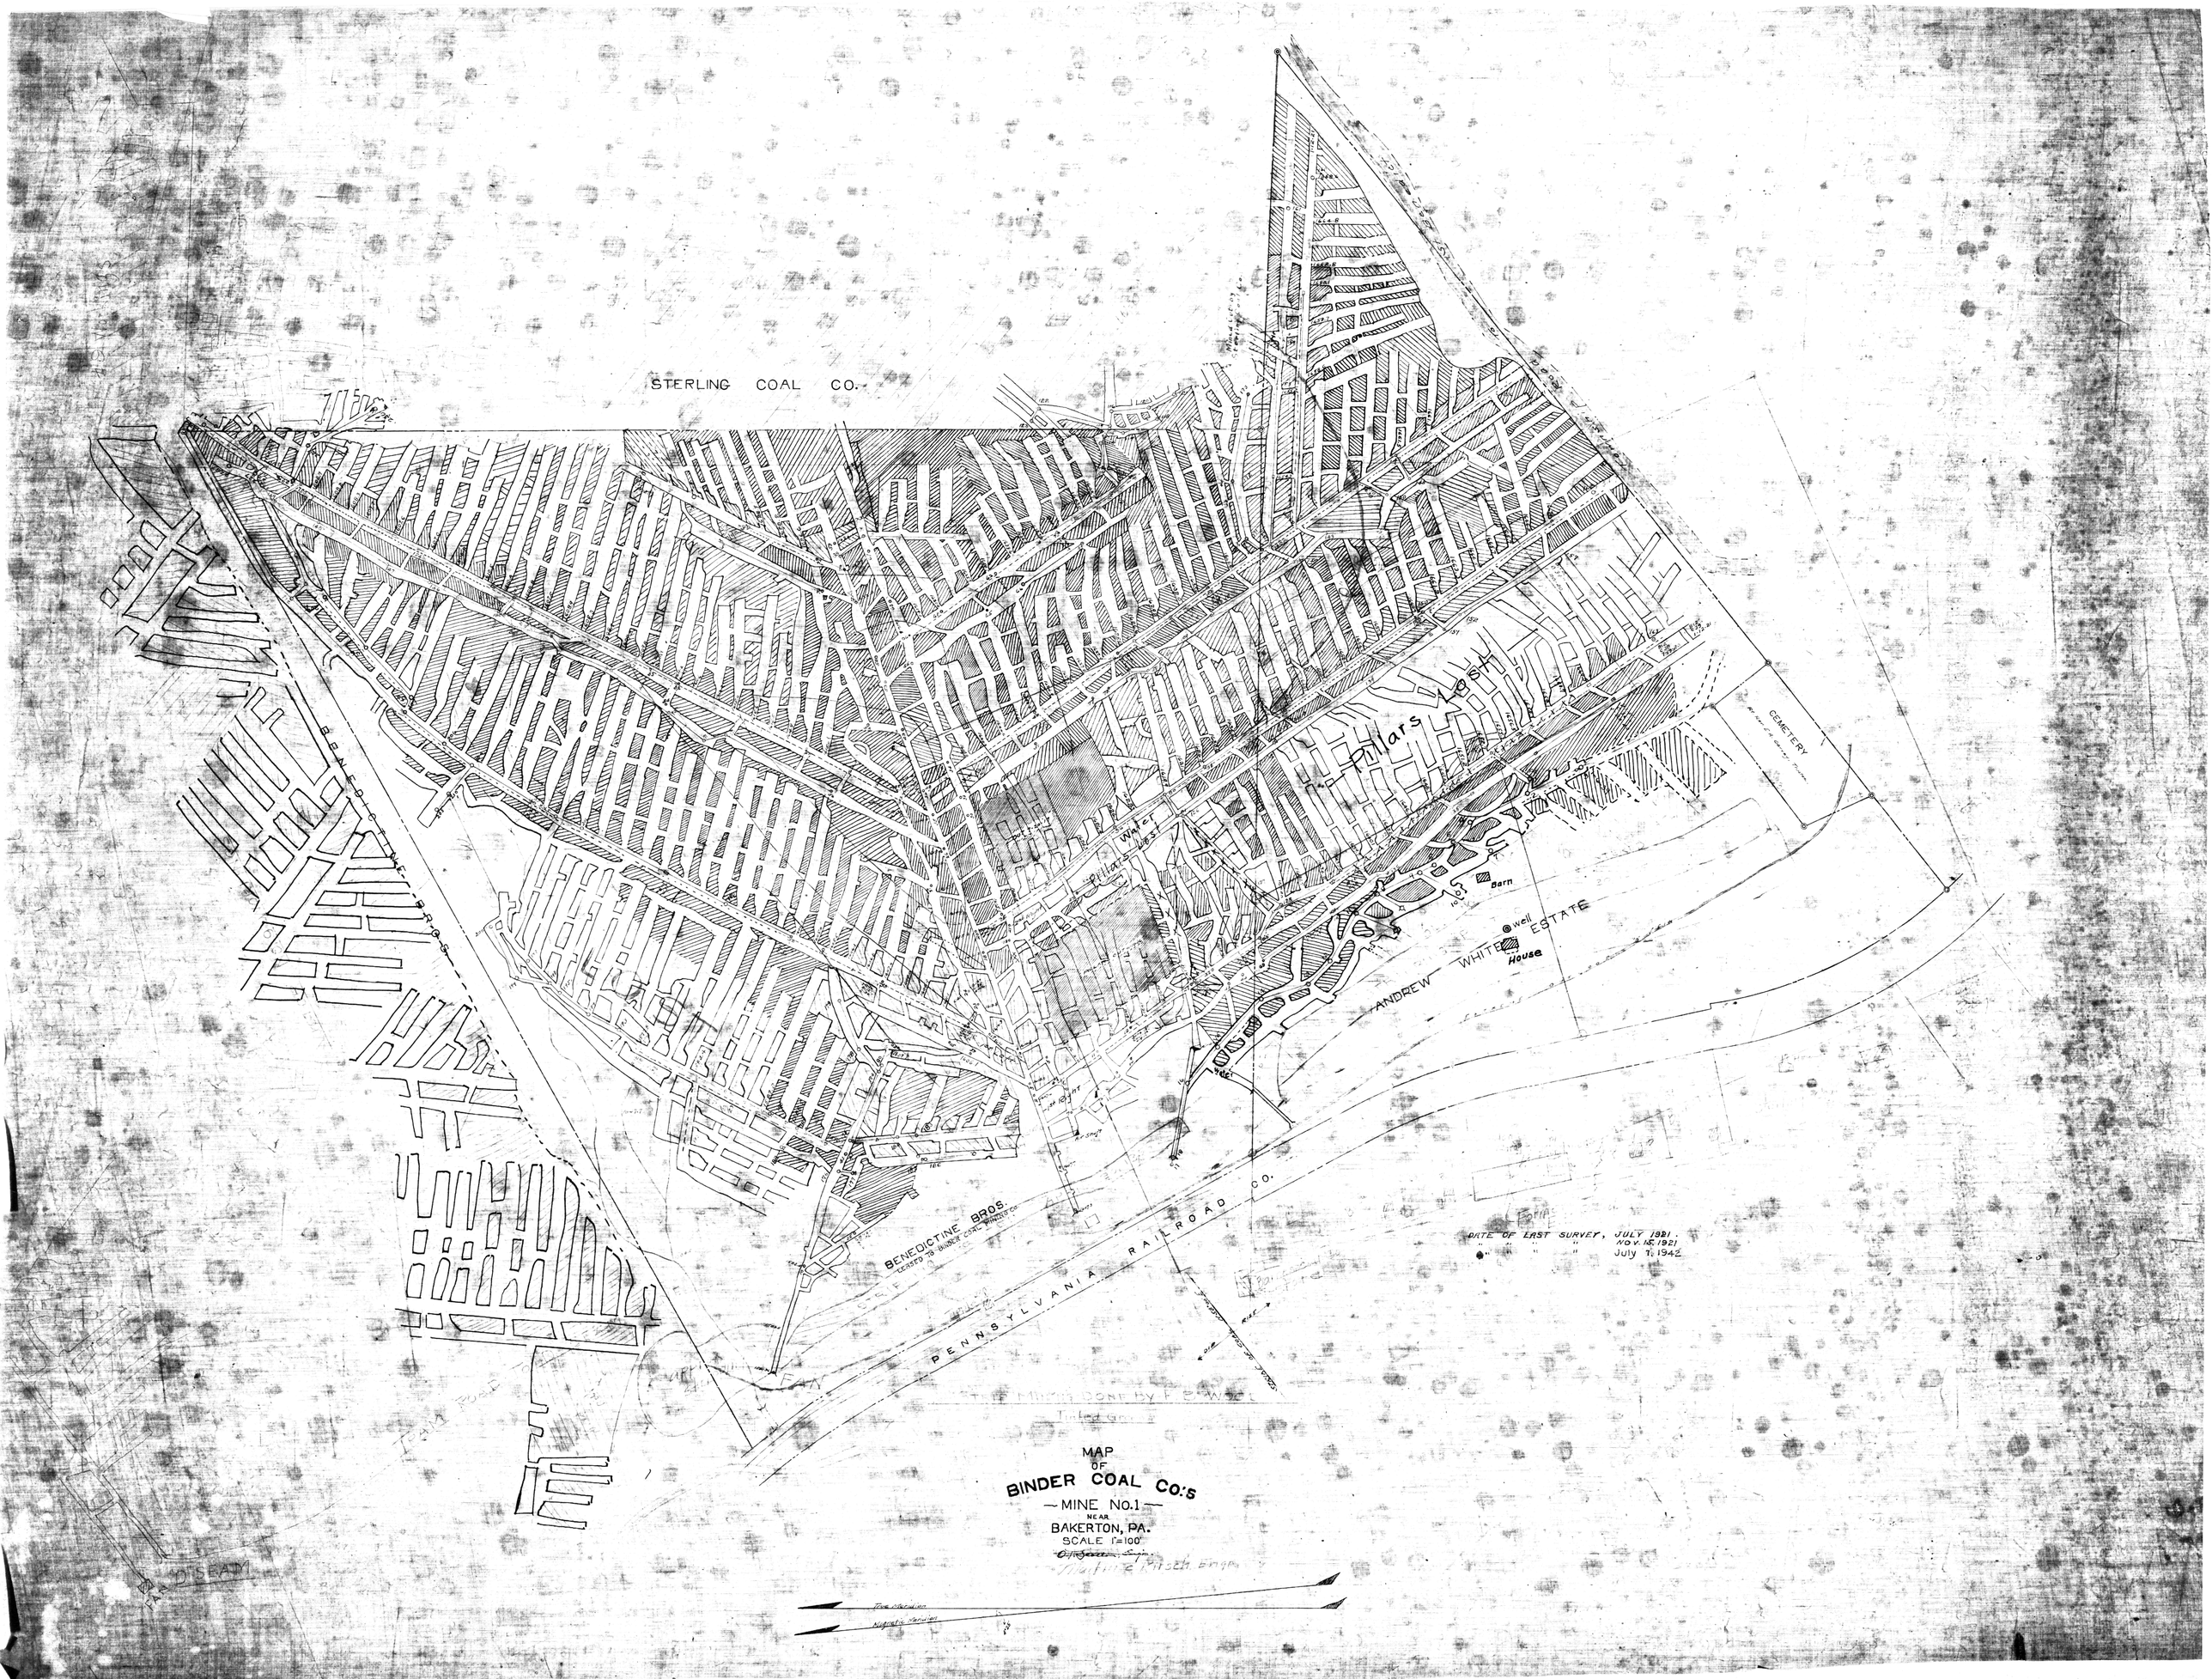
STERLING COAL CO.
Pillars Lost
CEMETERY
Barn
Well
House
ANDREW WHITE ESTATE
BENEDICTINE BROS.
PENNSYLVANIA RAILROAD CO.
DATE OF LAST SURVEY, JULY 1921.
" " " NOV. 15, 1921
" " " July 7, 1942
MAP
OF
BINDER COAL CO.'S
— MINE No. 1 —
NEAR
BAKERTON, PA.
SCALE 1"=100'
True Meridian
Magnetic Meridian