


FAULTY

P. L. EOK

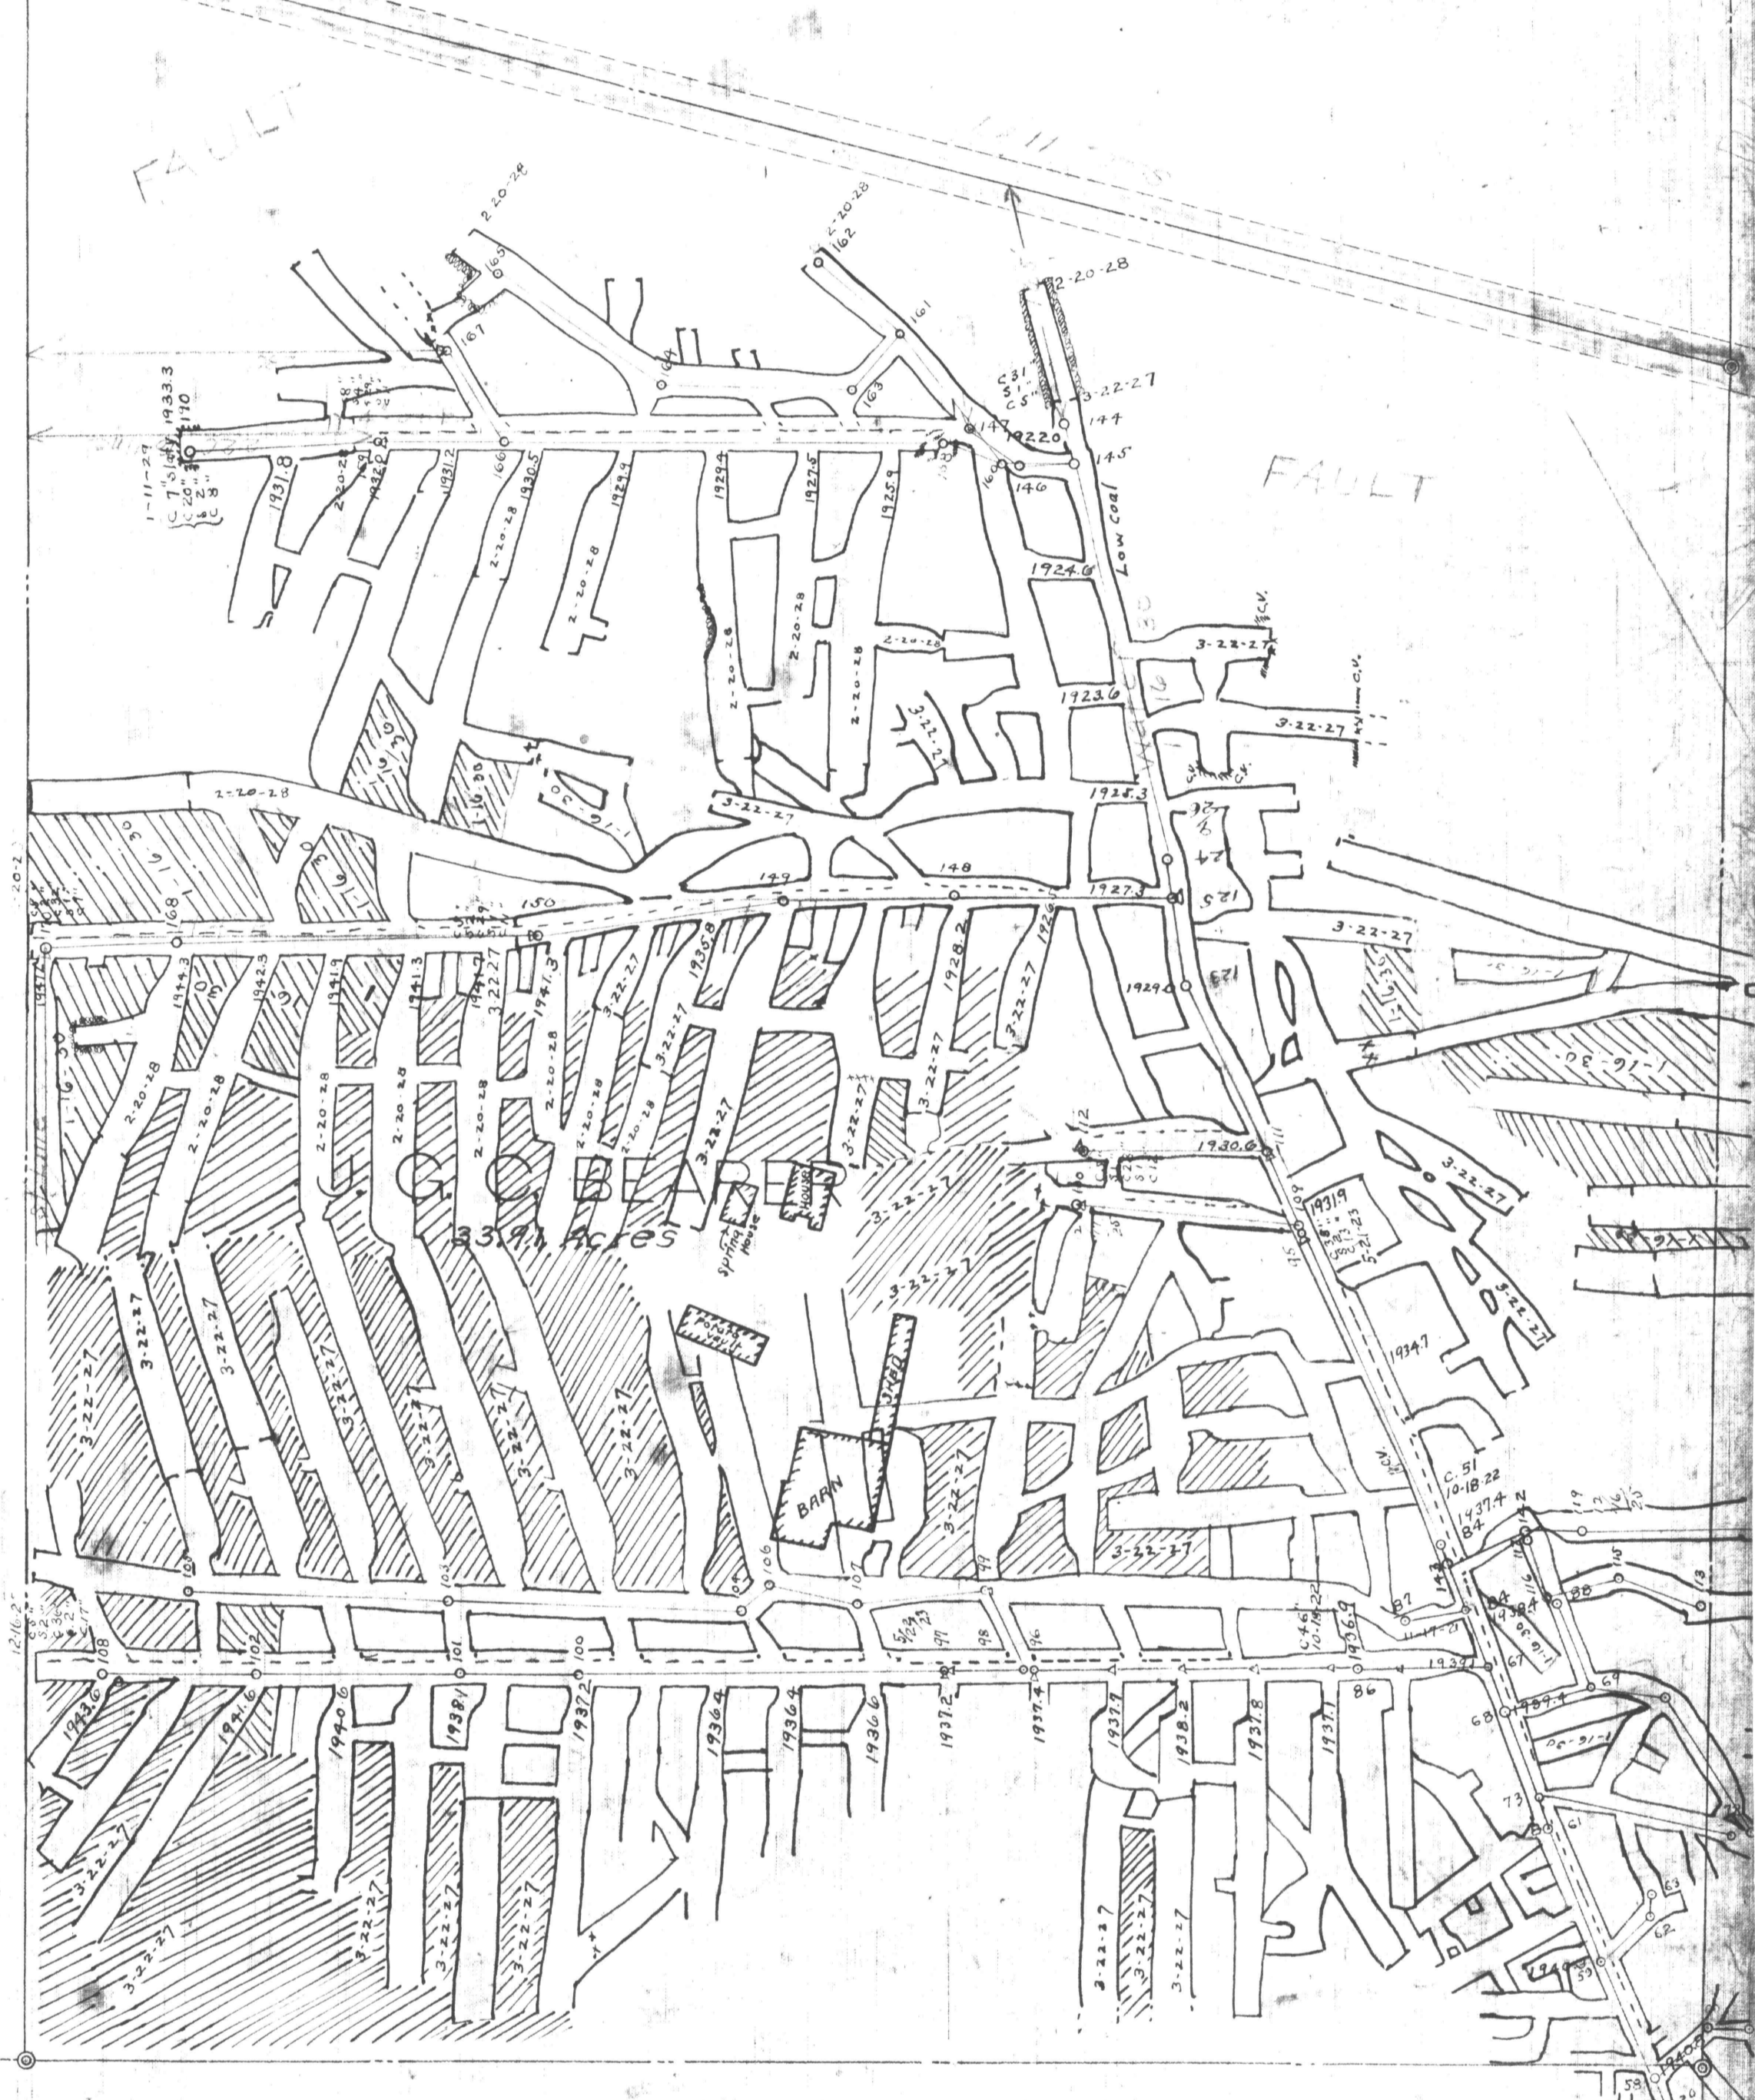

MARY THOMAS

MAP OF
BINDER NO. 2 MINE
"D" SEAM
BINDER COAL CO.—OPERATORS
Apr. 1918 Scale 1"=100'

