


Commonwealth of Pennsylvania
State Game Lands No 79

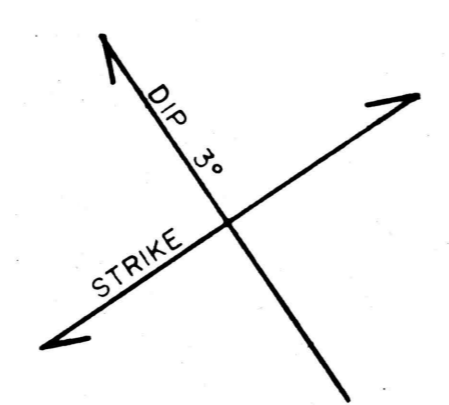


MAP SHOWING PROPOSED
SITES FOR
COMMERCIAL COAL COMPANY
BLACKLICK TWP., CAMBRIA CO., PA.
SCALE: 1" = 200'

Commercial Coal
Mining Company

- Existing Strip Mines
- Proposed Mining within Succeeding Six Months
- Completed Area

FROM ALL INDICATIONS AREA SURROUNDING PROPOSED PERMITTED AREA HAS BEEN ALL MINED OUT

- REVISED DEC. 9, 1966
- REVISED MAR. 1967
- REVISED NOV. 1967
- REVISED MAY, 1968
- REVISED NOV. 1968
- REVISED MAY 1969
- REVISED NOV. 1969
- REVISED MAY 1970

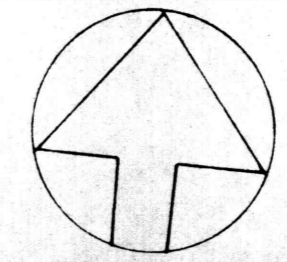

COMMERCIAL COAL COMPANY OF TWIN ROCKS

Blacklick Twp., Cambria Co., Pennsylvania
Scale: 1" = 200'
October, 1966

This map prepared by L. ROBERT KIMBALL, Consulting Engineers, Chambersburg, Pennsylvania, using an enlargement of U.S.G.S. Quadrangles and maps by others.