


MRS. SARAH M. TROXELL TRACT  
C PRIME COAL LEASED TO BLAND BROS. COAL CO.

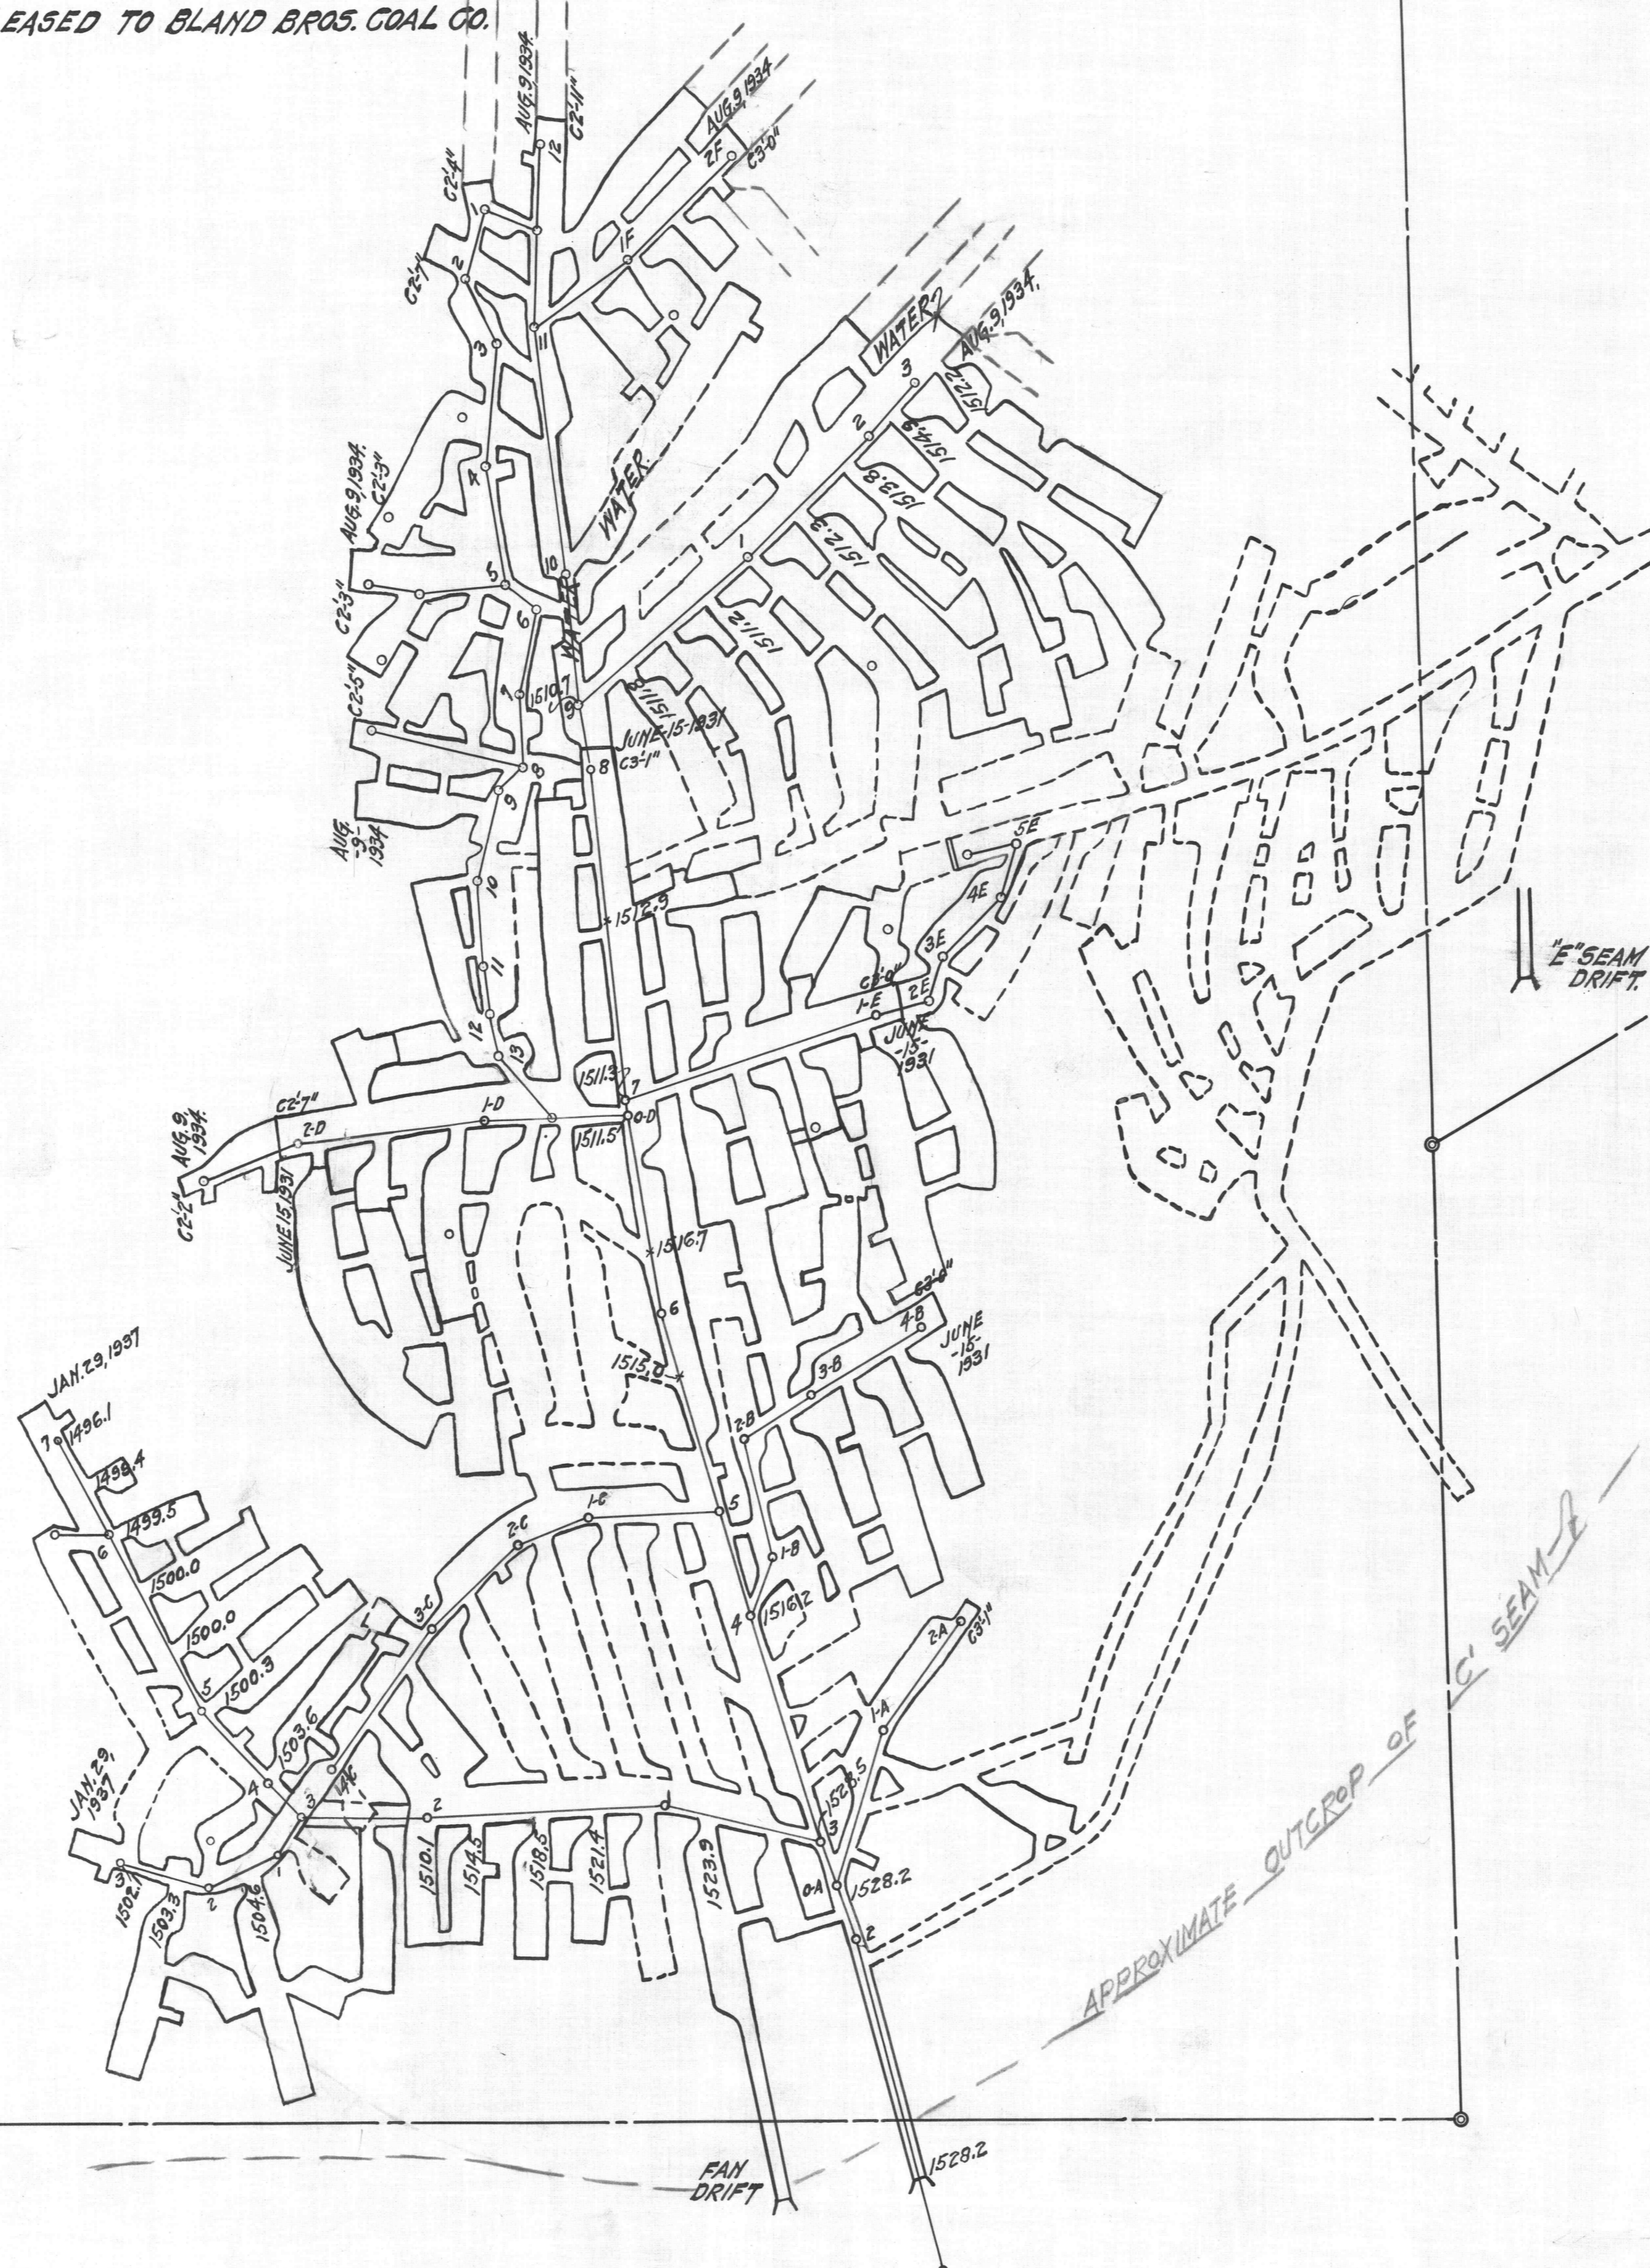

MAP SHOWING MINING OPERATIONS  
OF THE  
BLAND BROS. COAL CO.  
IN THE C PRIME SEAM.

READE TOWNSHIP, GAMBRIA COUNTY, PA.

SCALE :- 1"=100'

W.A. SILLIMAN  
MINING ENGR.  
ALTOONA, PA.

NOTE :- MINE WORKINGS SHOWN BY DASH LINES ARE INACCESSIBLE  
OR TRACED FROM EXISTING MAPS MADE BY OTHERS.

PROPERTY LINES SHOWN AS PER MAP BY J. LUDEN HENRY  
DATED SEPT. 4-5, 1903. - NOT SURVEYED BY US.

#286