

TO LEVONIA
C. & I. RR. OF DENNIS, P.D.
TO GREENSBORO


MAP SHOWING MINE WORKINGS OF THE **READE COAL CO.**

READE TOWNSHIP, GAMBRIA COUNTY, PA.

SCALE: 1"=100'

J.S. SILLIMAN & CO.
ENGINEERS
ALTOONA, PA.

C7A20-3

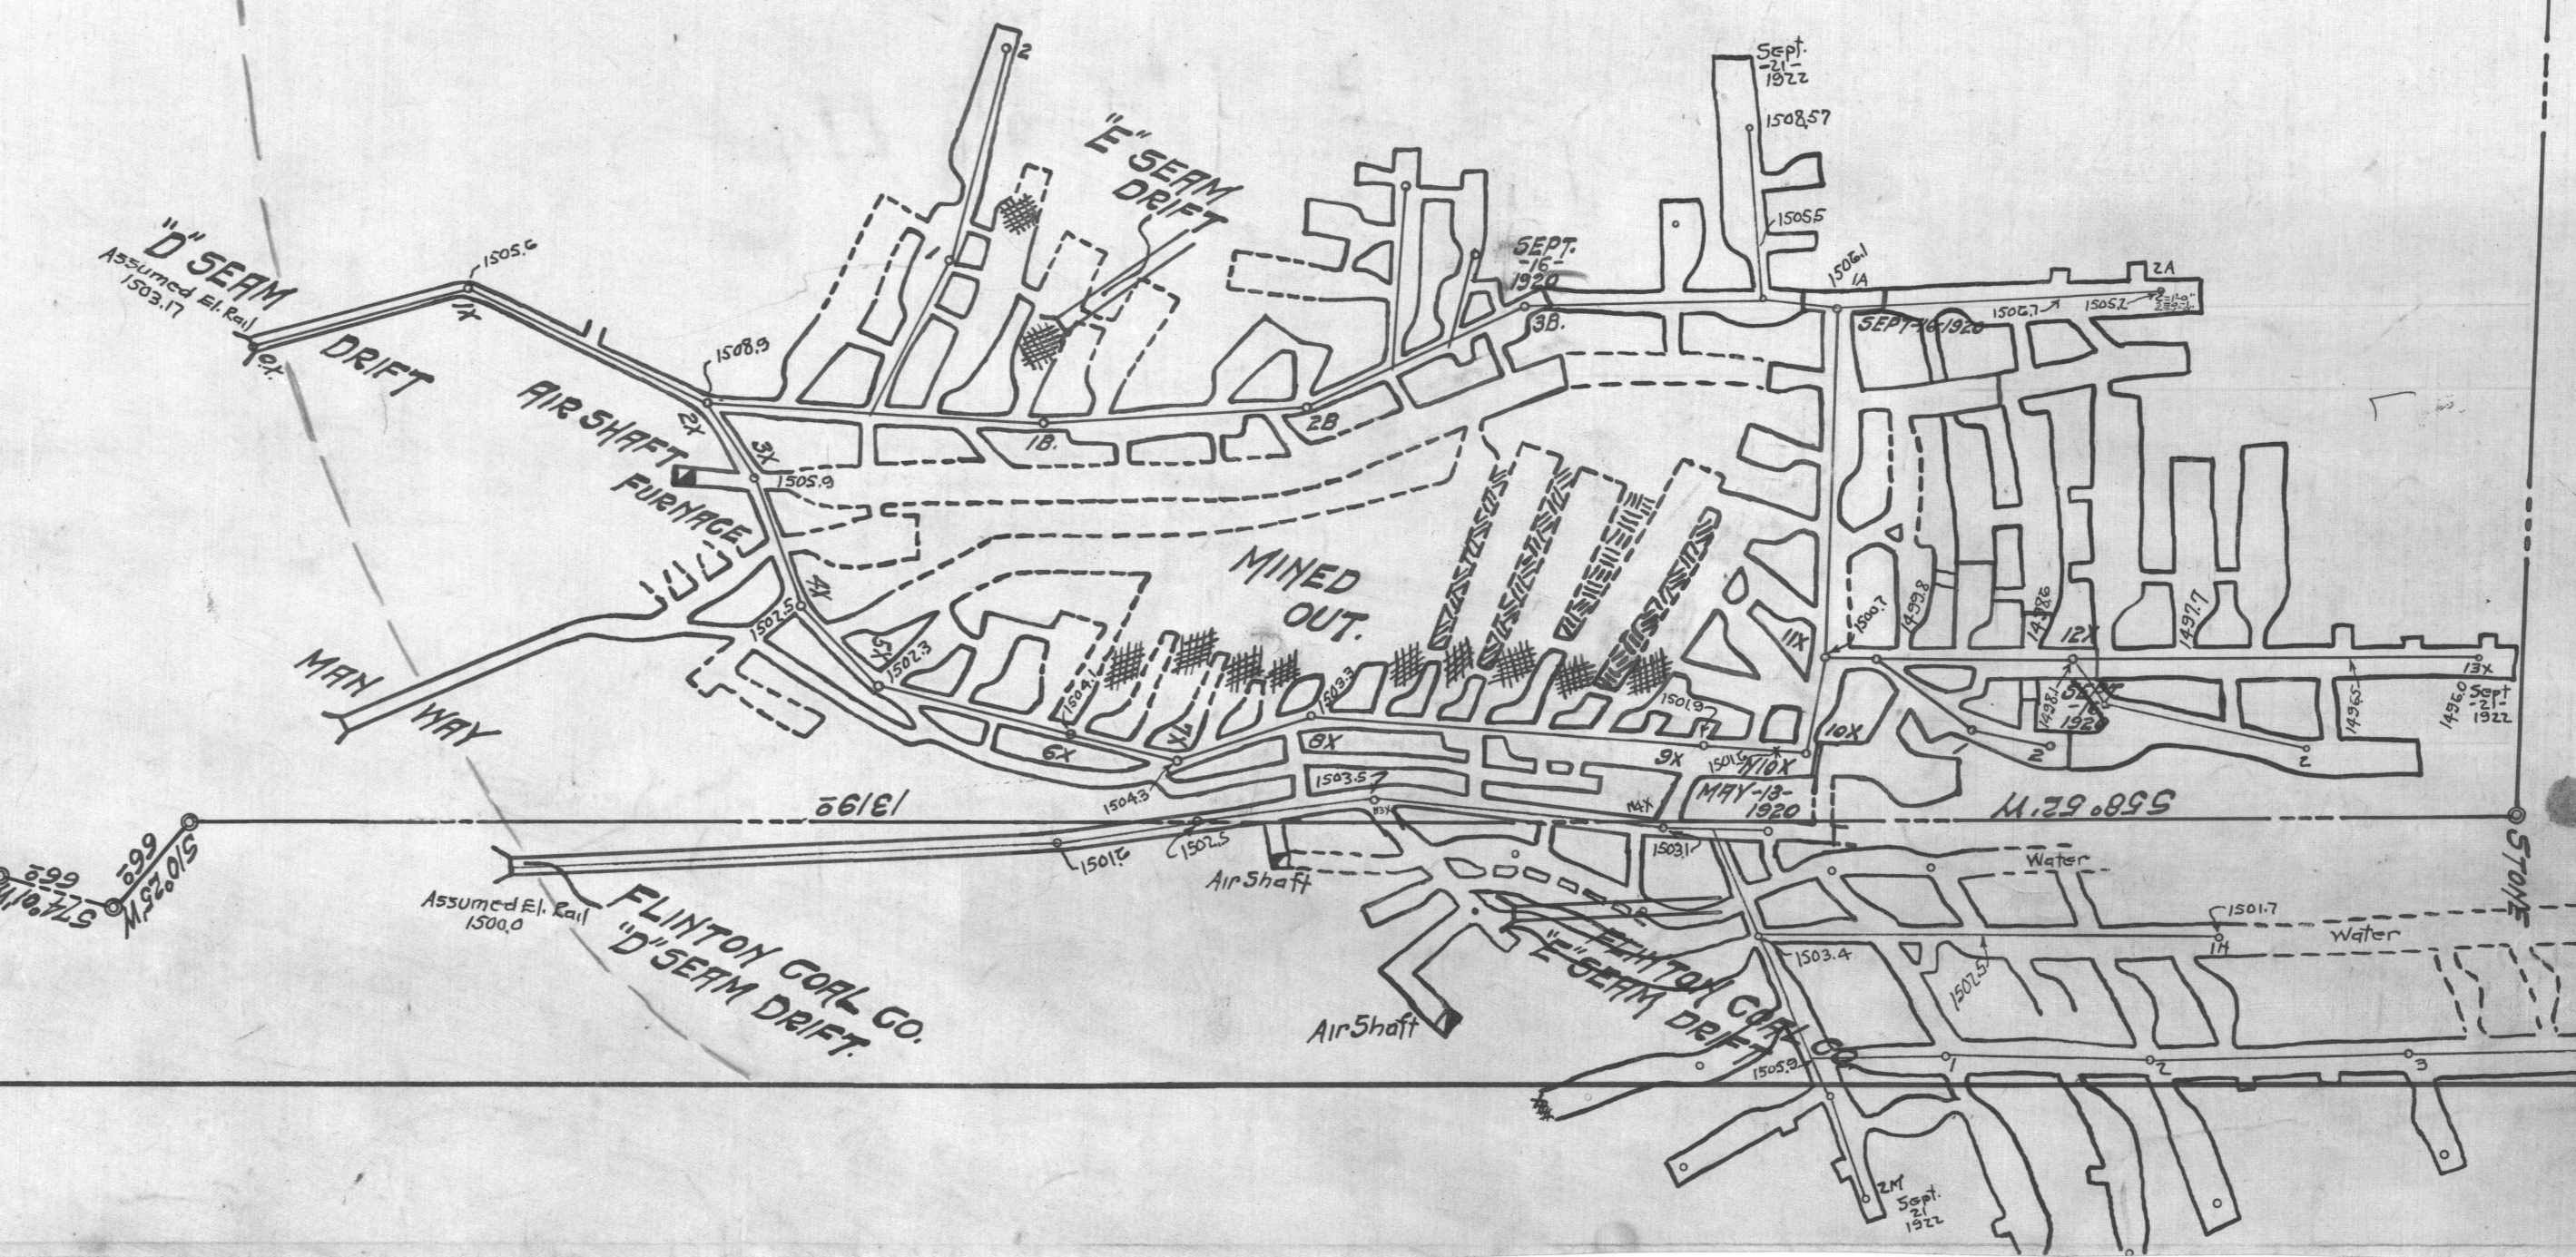

562° 39' E

FILE
N-3

Sept 1922

0722