




MAP OF GALLITZIN SHAFT

OPERATED BY
TAYLOR & McCOY C. & C. Co.
 GALLITZIN, CAMBRIA Co., PA.
 ALTOONA PA. J.S. SILLYMAN & Co.

SCALE: - 1 IN. = 100 FT.

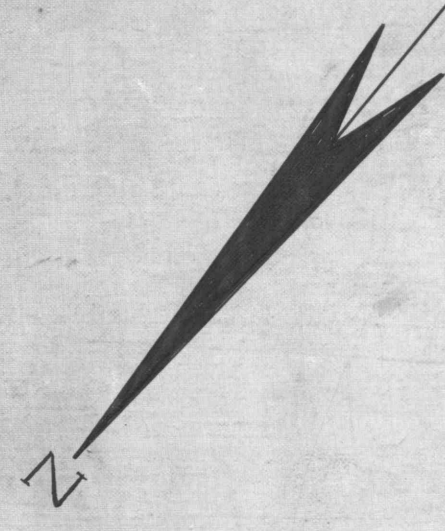

MES McCLOSKEY
 FLOOR & McCOY SURFACE

PENNA. COAL & COKE Co

LA-3