E-C-1
CA-68

C7B3-2

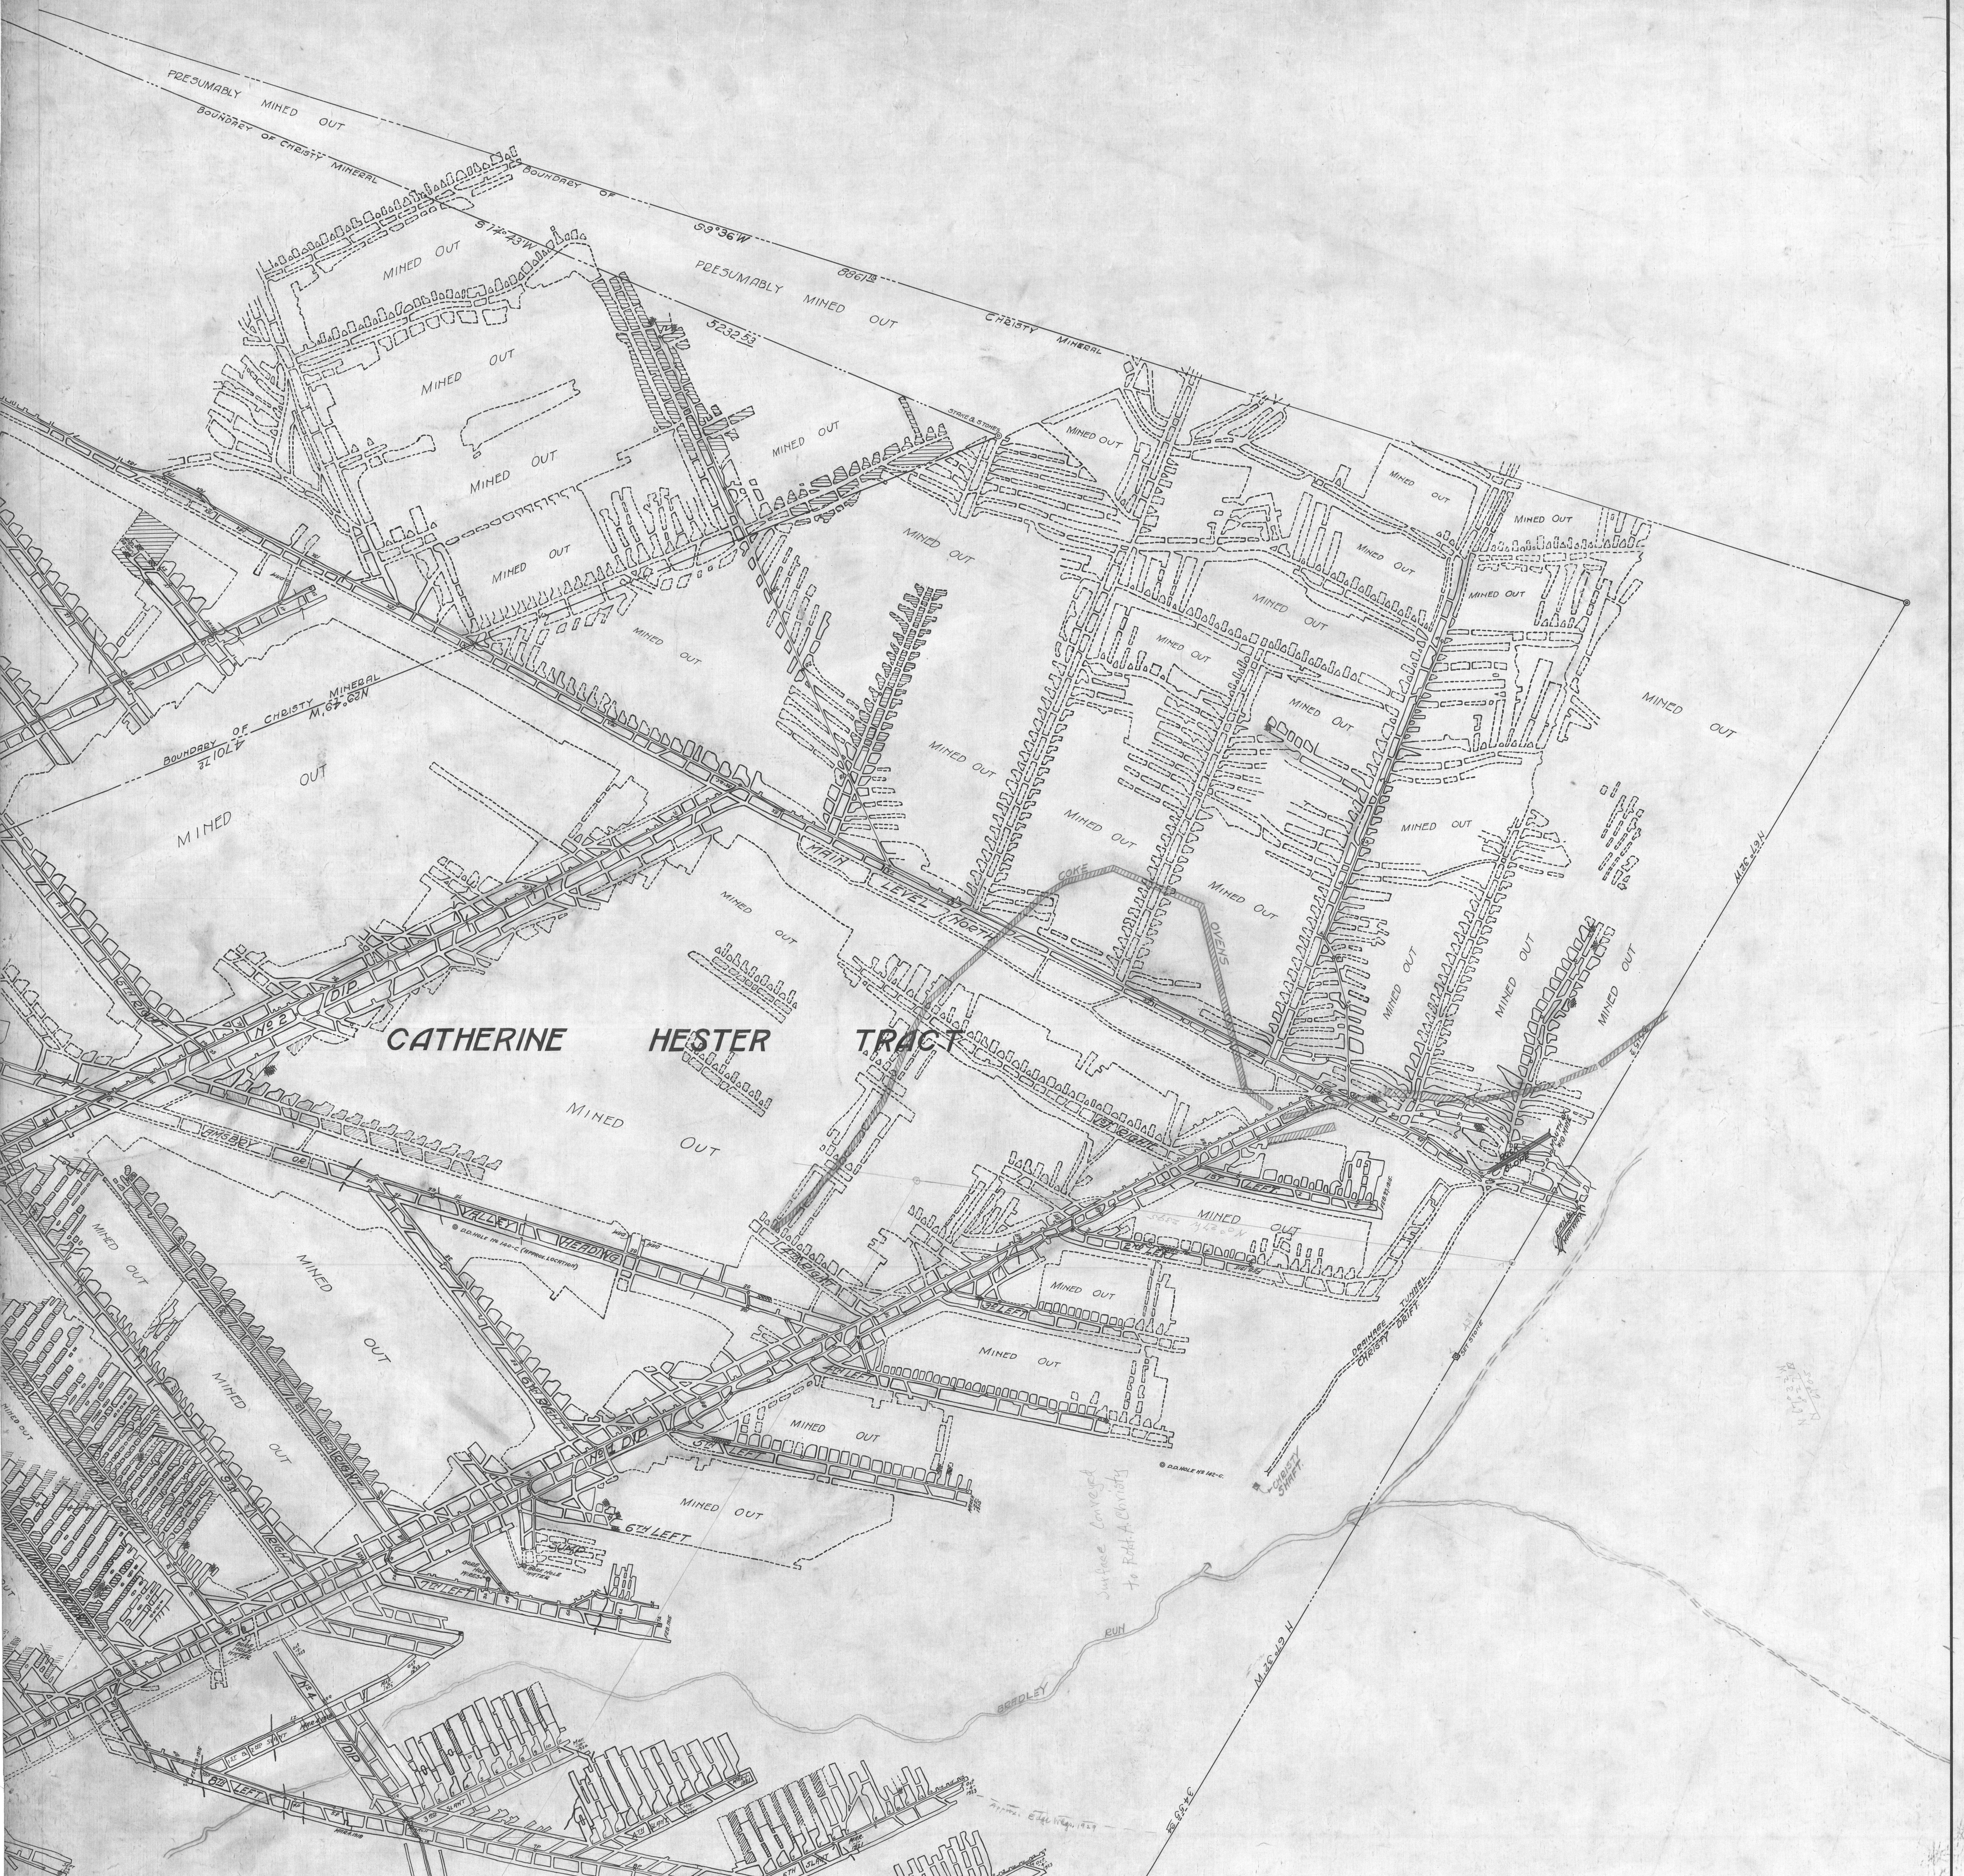
PRESUMABLY MINED OUT
BOUNDARY OF CHRISTY MINERAL
BOUNDARY OF CHRISTY MINERAL
S 9°36' W
8861.9
S 14°43' W
5232.53
PRESUMABLY MINED OUT
MINED OUT
STAKE & STONES
BOUNDARY OF CHRISTY MINERAL
N 67°62' W
4701.2
MINED OUT
MAIN LEVEL NORTH
COKE OVENS
CATHERINE HESTER TRACT
No 2 DIP
5TH RIGHT
ANSBRY DR
VALLEY HEADING
D.D. HOLE No 140-C (APPROX. LOCATION)
4TH RIGHT
6TH RIGHT
7TH RIGHT
8TH RIGHT
9TH RIGHT
10TH RIGHT
1ST RIGHT
1ST LEFT
FEB. 27, 1915
2ND LEFT
3RD LEFT
4TH LEFT
5TH LEFT
6TH LEFT
7TH LEFT
8TH LEFT
No 1 DIP
No 4 DIP
SUMP
BORE HOLE WIRES
BORE HOLE WATER
MAR. 22, 1915
FEB. 1915
FEB. 23, 1915
MAR. 4, 1918
1ST & 2ND SLANT
3RD SLANT
4TH SLANT
5TH SLANT
6TH SLANT
MAR. 1, 1921
MAR. 10, 1920
OCT. 5, 1923
OCT. 19, 1923
1ST LEFT
2ND LEFT
3RD SLANT
M.G.N
BIRCH SNAG
N 67°37' W
3455.4
SET STONE
DRAINAGE TUNNEL
CHRISTY DRIFT
CHRISTY SHAFT
D.D. HOLE No 142-C
MOUTH OF NO MINE
BOX SLOPE
FAN & MANWAY
BRADLEY RUN
N 67°37' W
E 5109
N 60°27' W 2295
Approx. Edge Wkgs. 1929
Surface Conveyed to Robt. A. Christy
N 67°37' W
2002

GWIN ENGINEERS INC.
1200 12th AVENUE
ALTOONA, PENNSYLVANA 16601
26

E-C-1