


JA-17

MAP OF MAPLE RIDGE COLLIERY
BENS CREEK COAL MINING CO. LESSEE.
ON PROPERTY OF CAMBRIA MINING & MFG. CO.
BENS CREEK PA.

Scale: 1"=100'

Jos. Silliman & Co.
Engineers.

"B" SEAMS WORKINGS IN FAINT LINES.

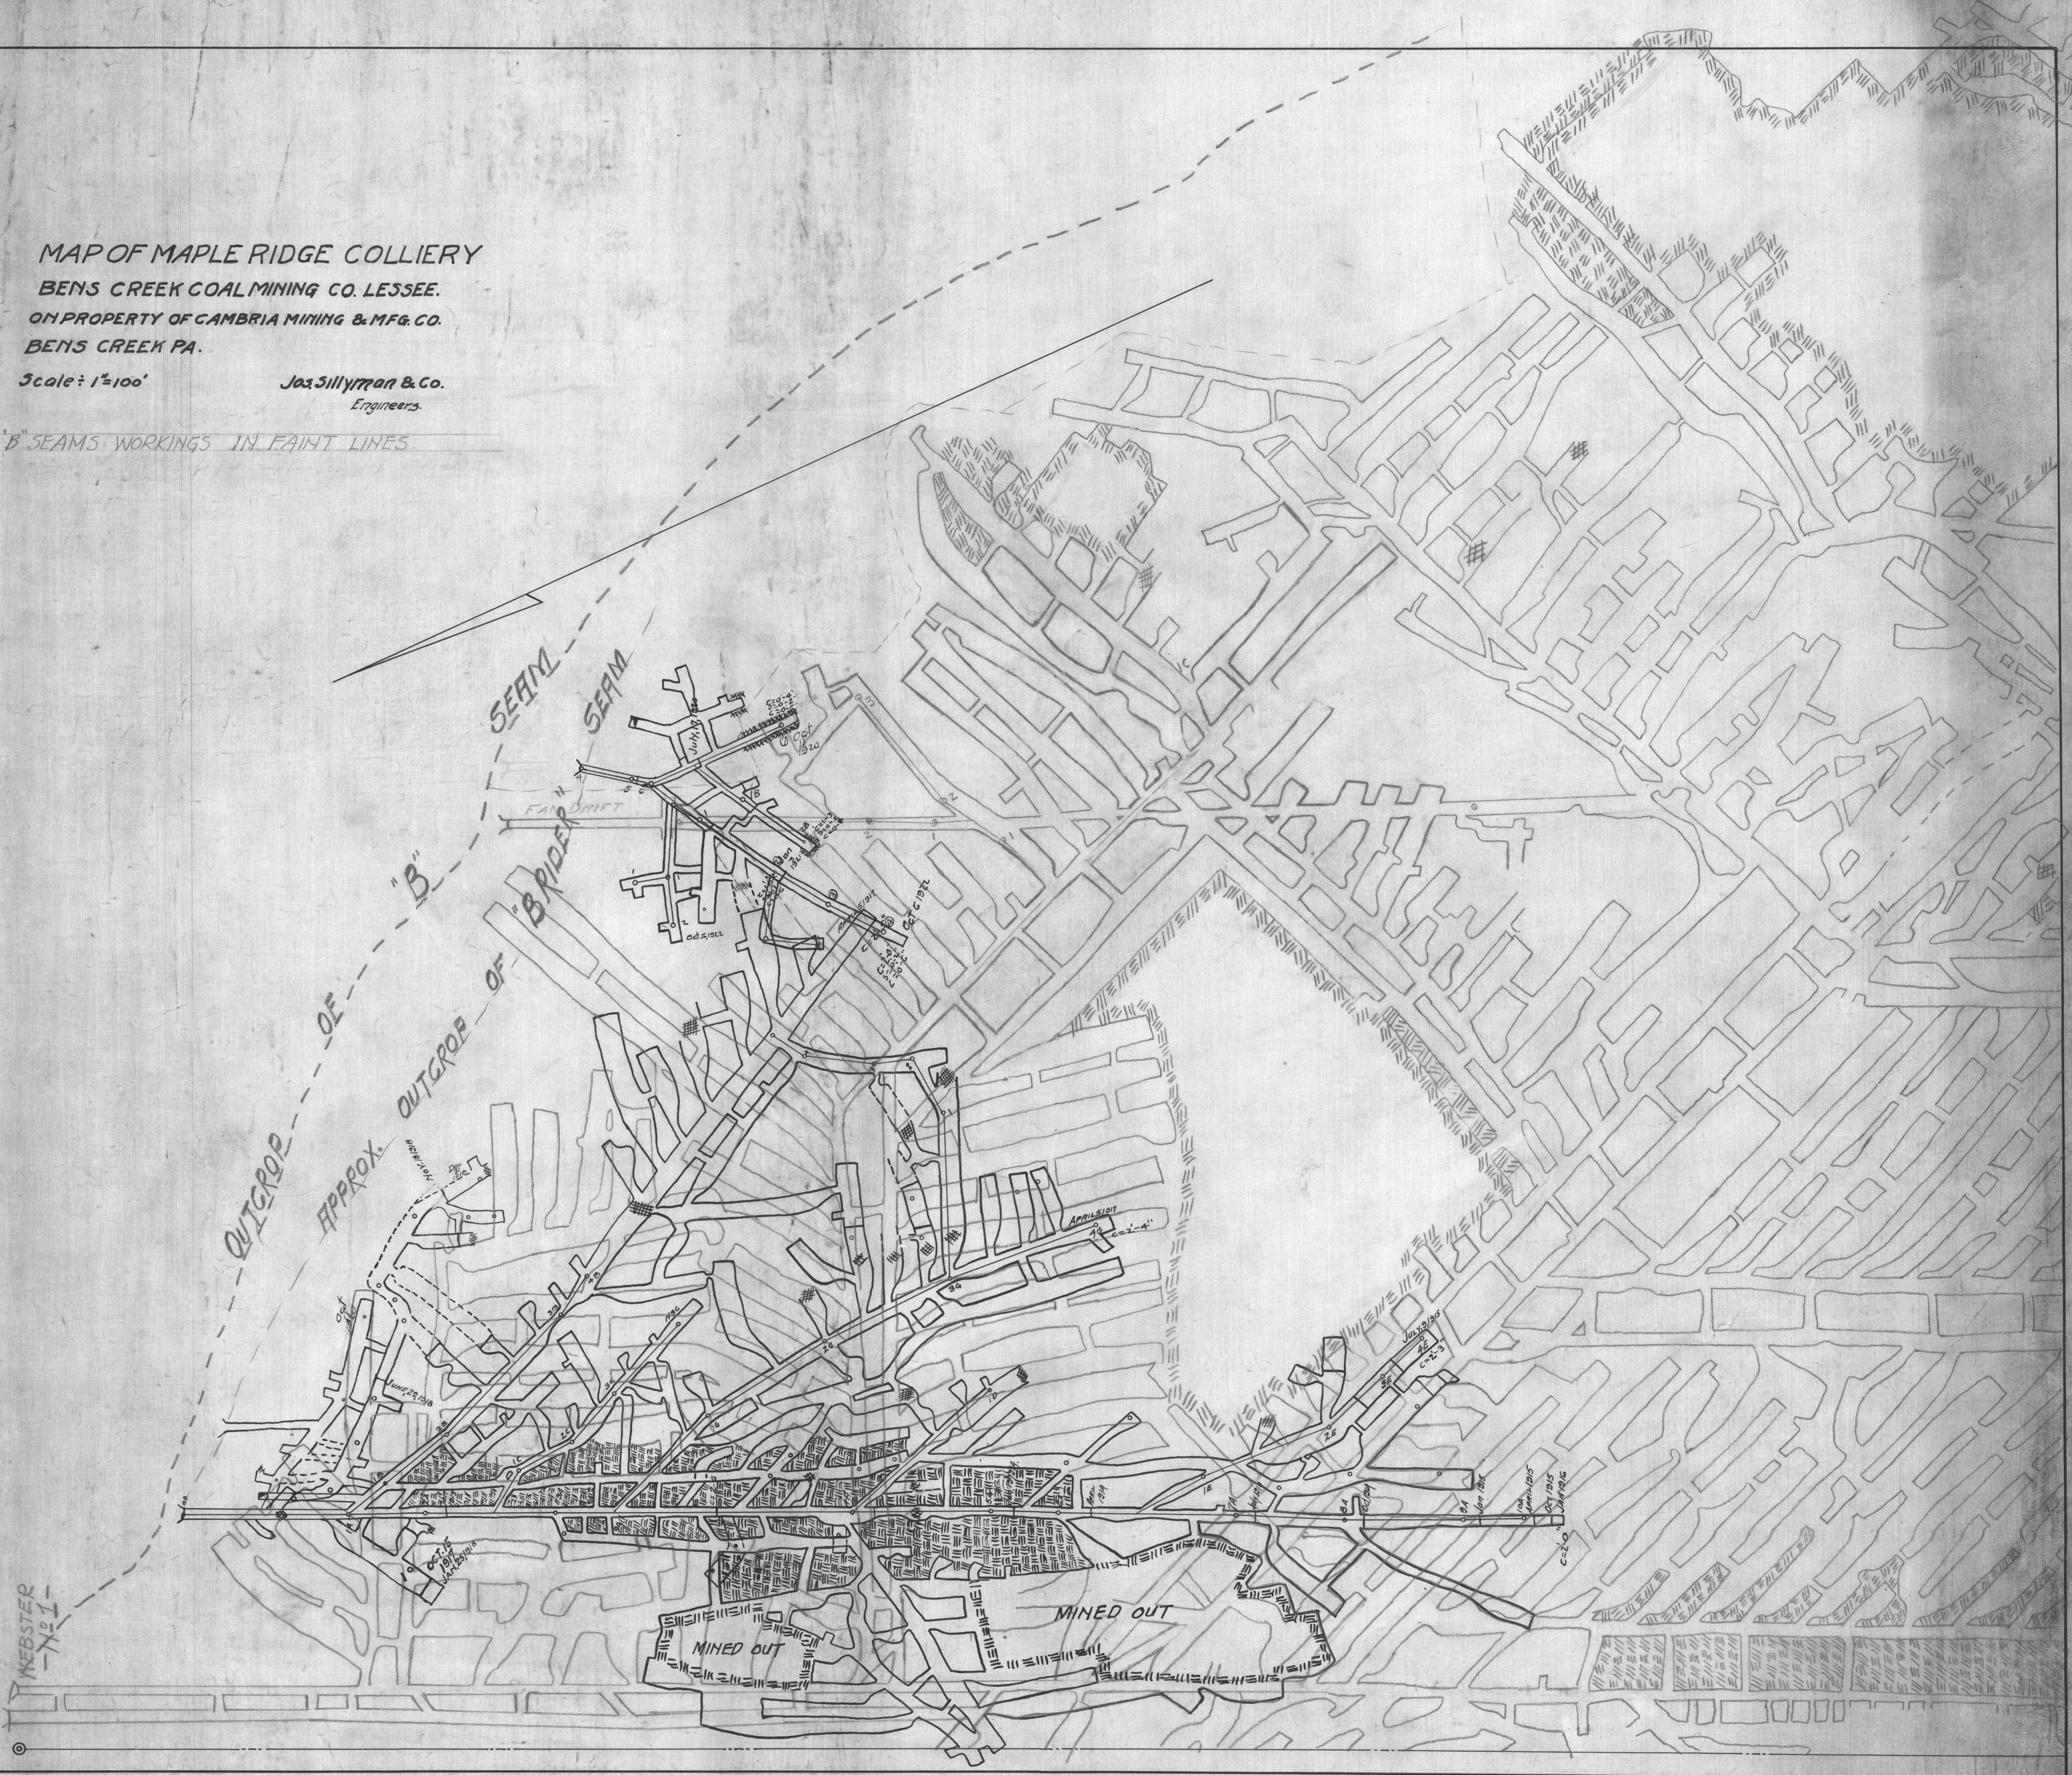

WEBSTER
-T-N-

JA-17

C7B10-4