


 

**MAP
OF
PROPERTY**


OF
Cambria Mining and Manufacturing Co.
Situated in Portage Township, Cambria County, Penna.

SCALE 1"=400'

1917

Jos S. SILLYMAN & Co.
Engineers
Altoona, Pa.

SHOWING B SEAM ONLY

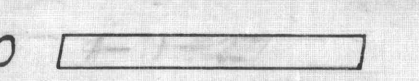WORKINGS SHOWN TO  C1B9-1