


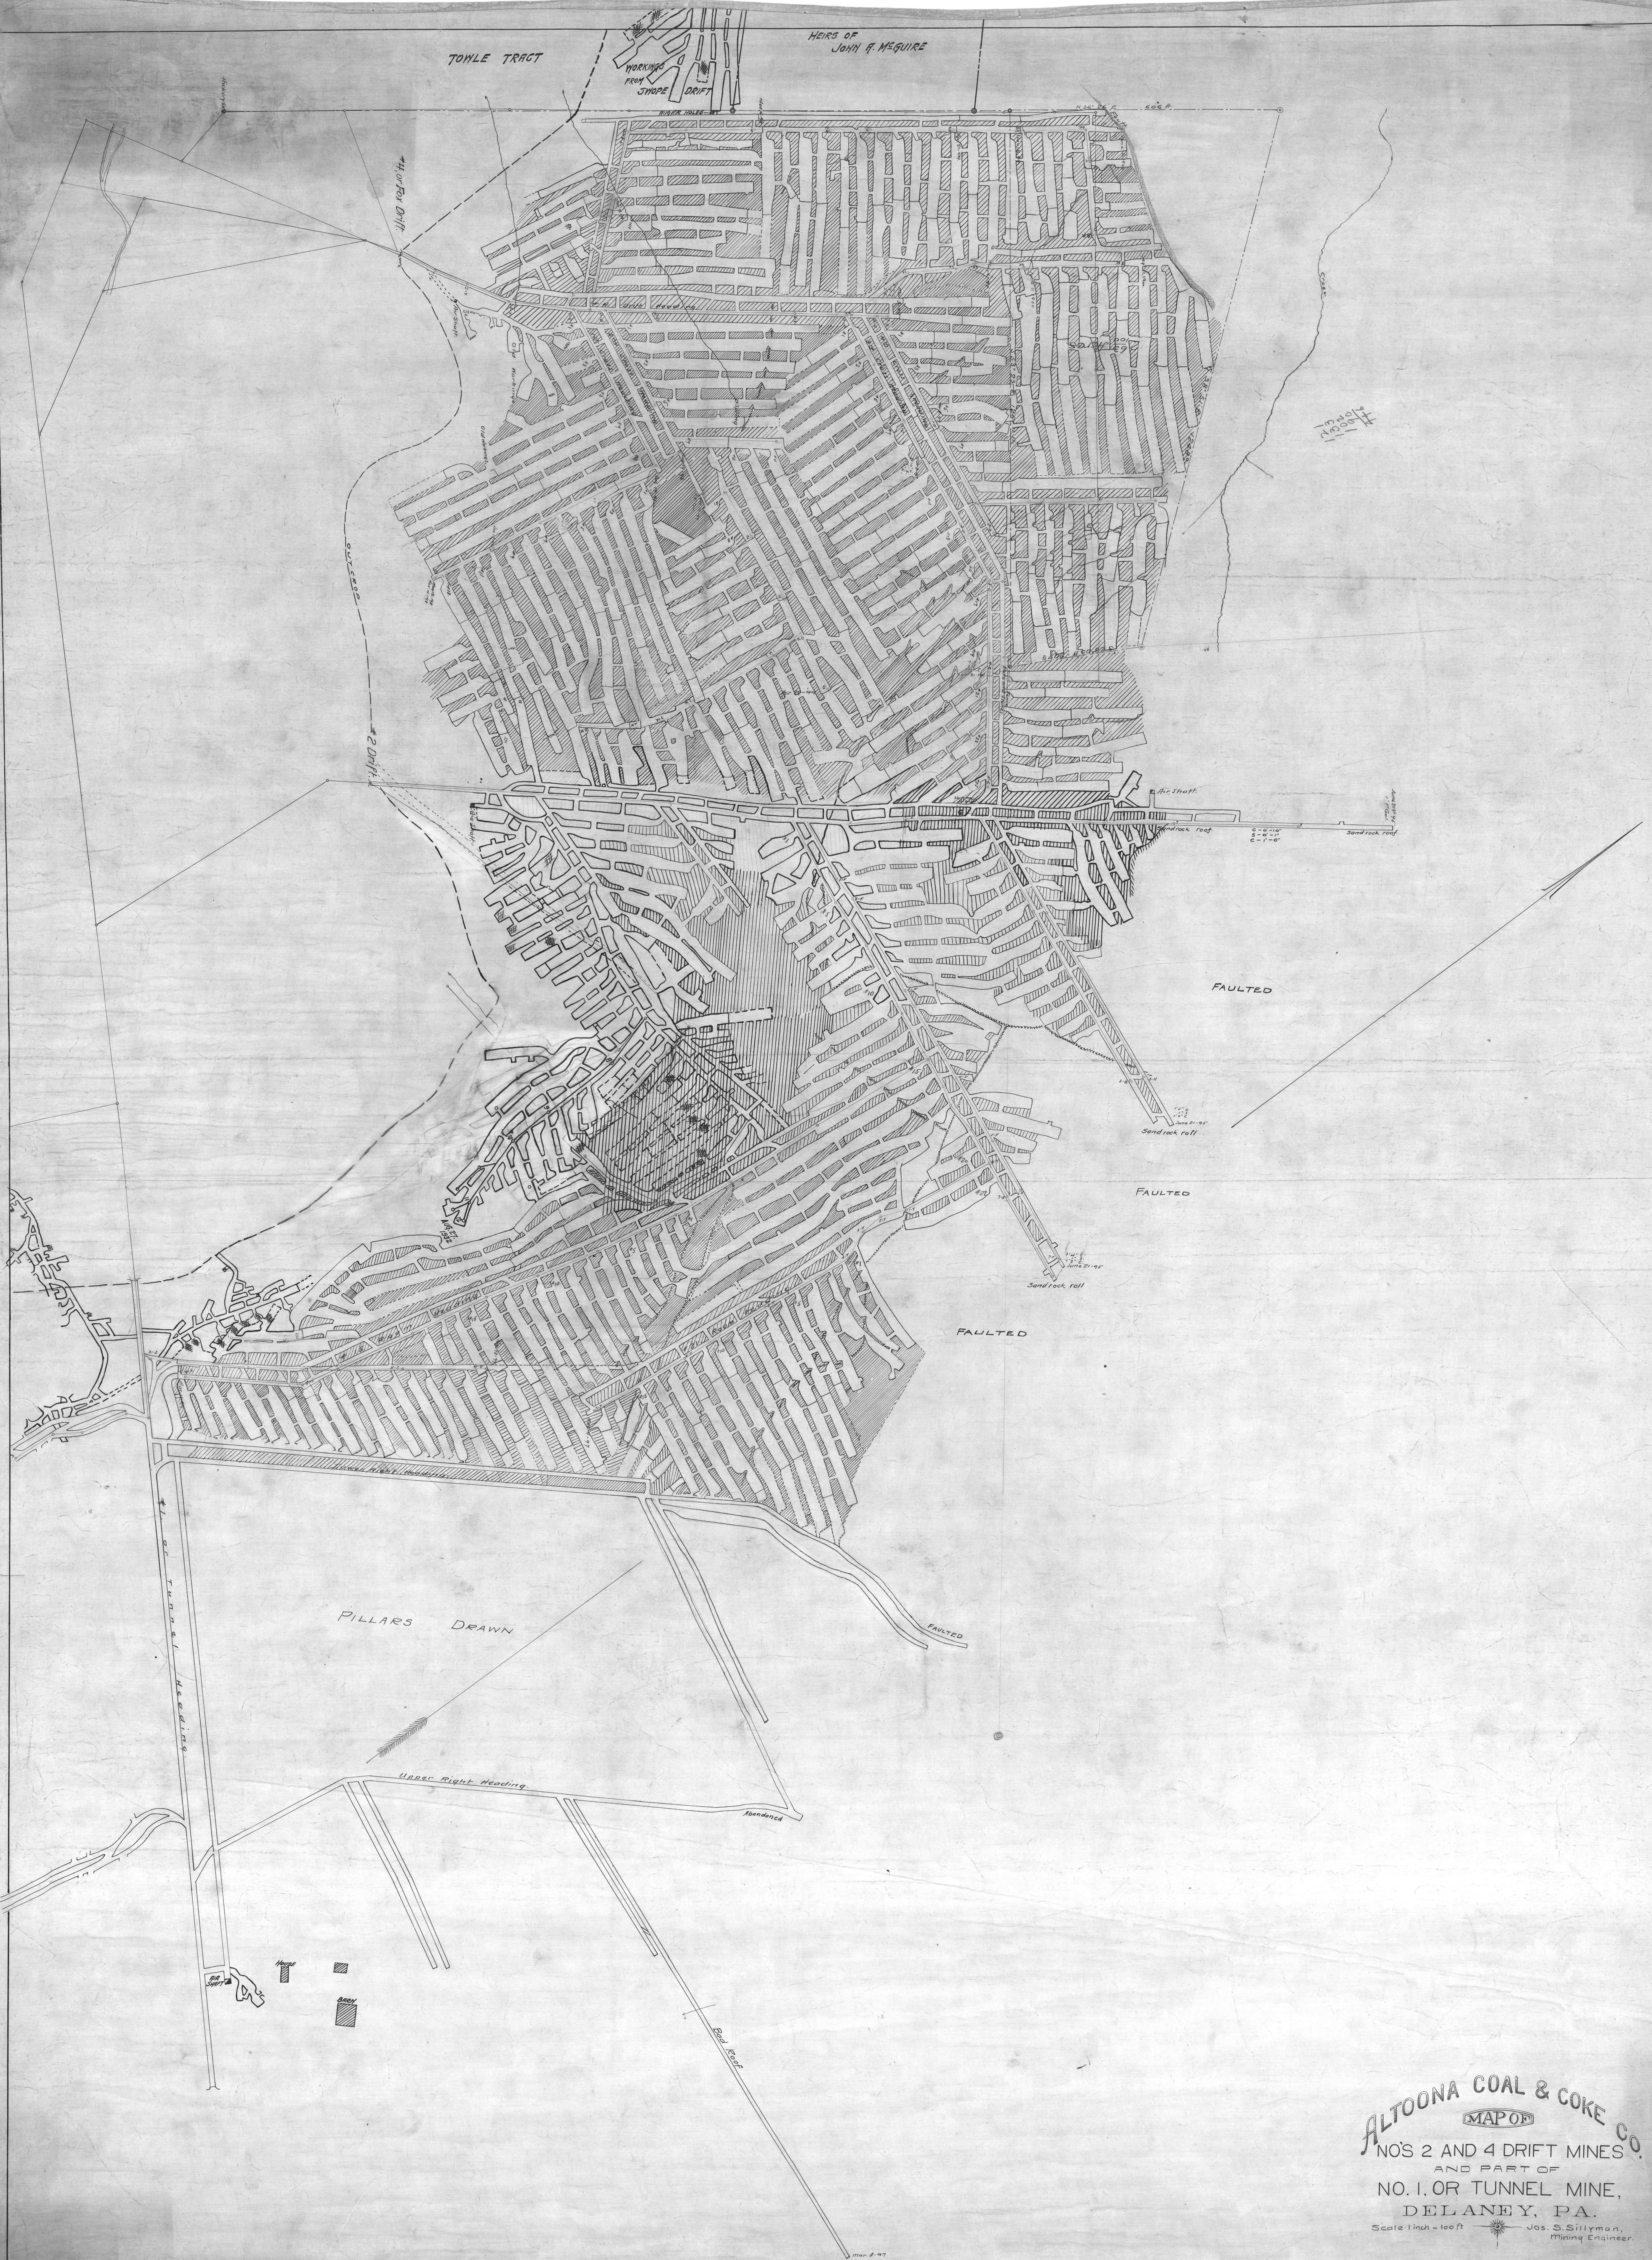

ALTOONA COAL & COKE CO.
MAP OF
NO'S 2 AND 4 DRIFT MINES,
AND PART OF
NO. 1, OR TUNNEL MINE,
DELANEY, PA.
Scale 1 inch = 100 ft. Jos. S. Sillyman,
Mining Engineer.