


SAMUEL KELLY  
(B. MYERS)

H. C. KENNER  
(ALTOONA COAL & COKE CO.)

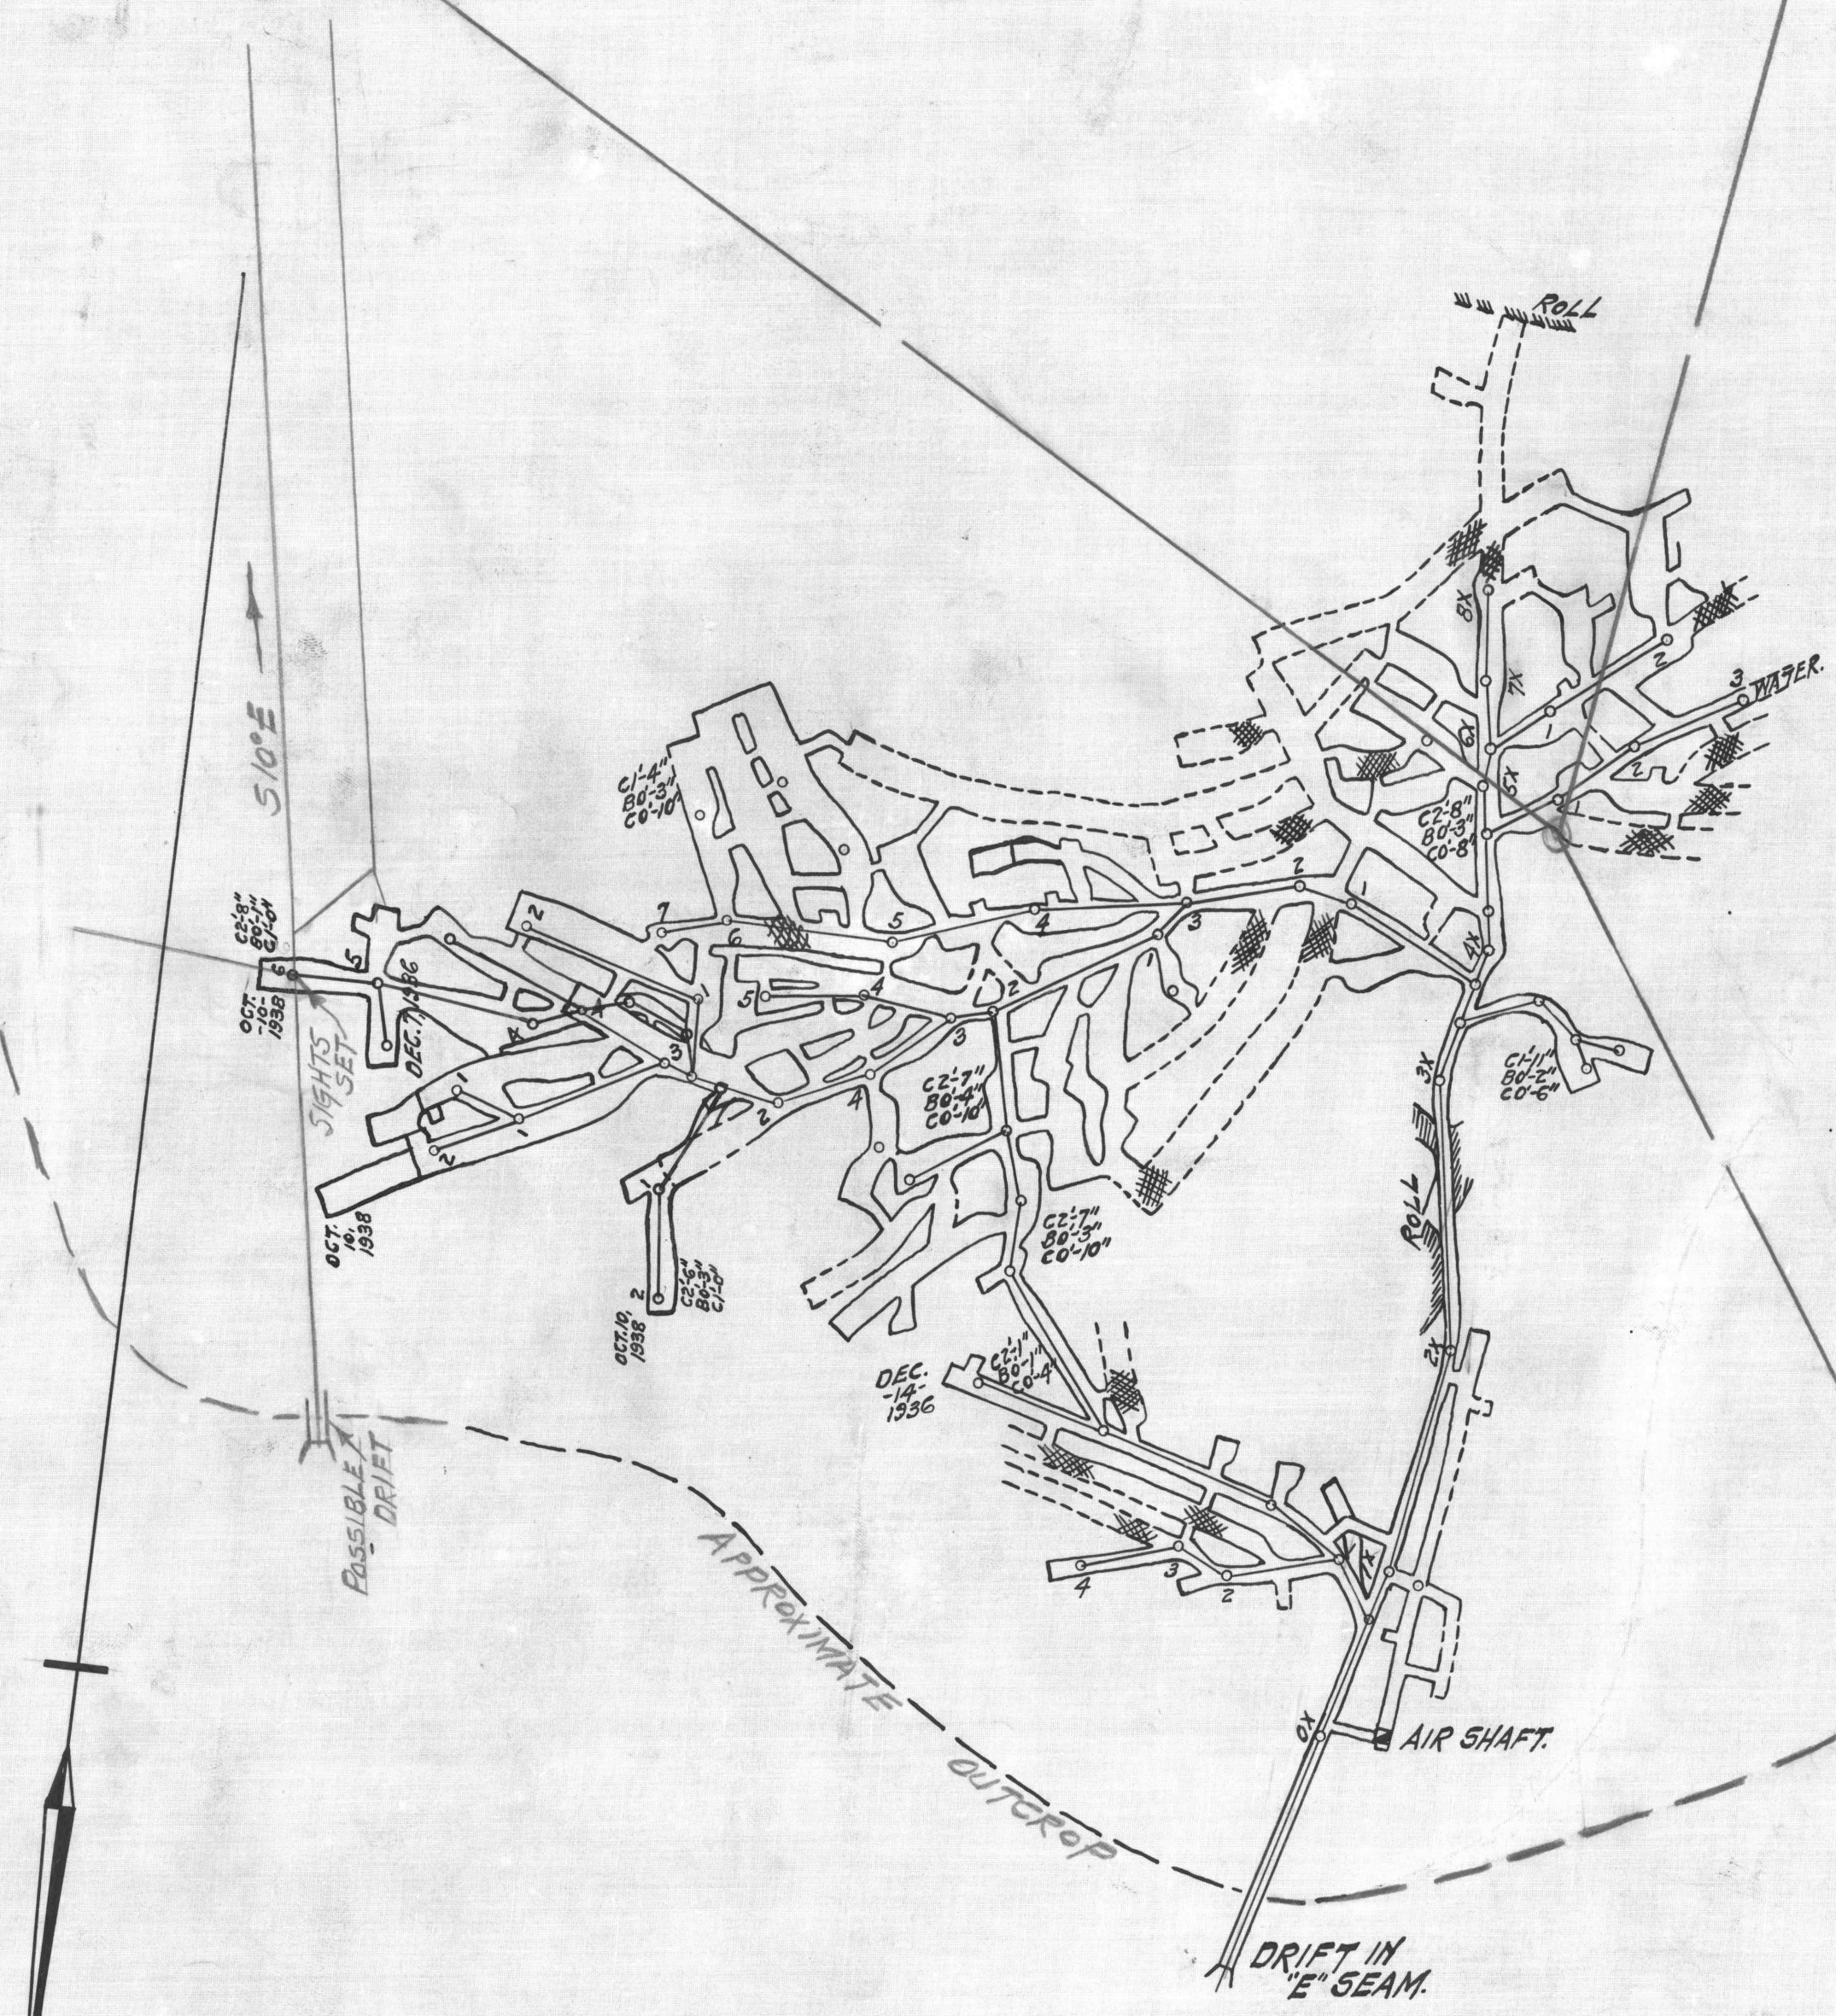

D. TREXLER ESTATE

MAP OF SHAVER MINE  
OPERATED BY  
G. F. EICHENLAUB COAL CO.  
NEAR ASHVILLE, CAMBRIA COUNTY, PA.  
SCALE: - 1" = 100'

W. A. SILLIMAN  
MINING ENGR.  
ALTOONA, PA.