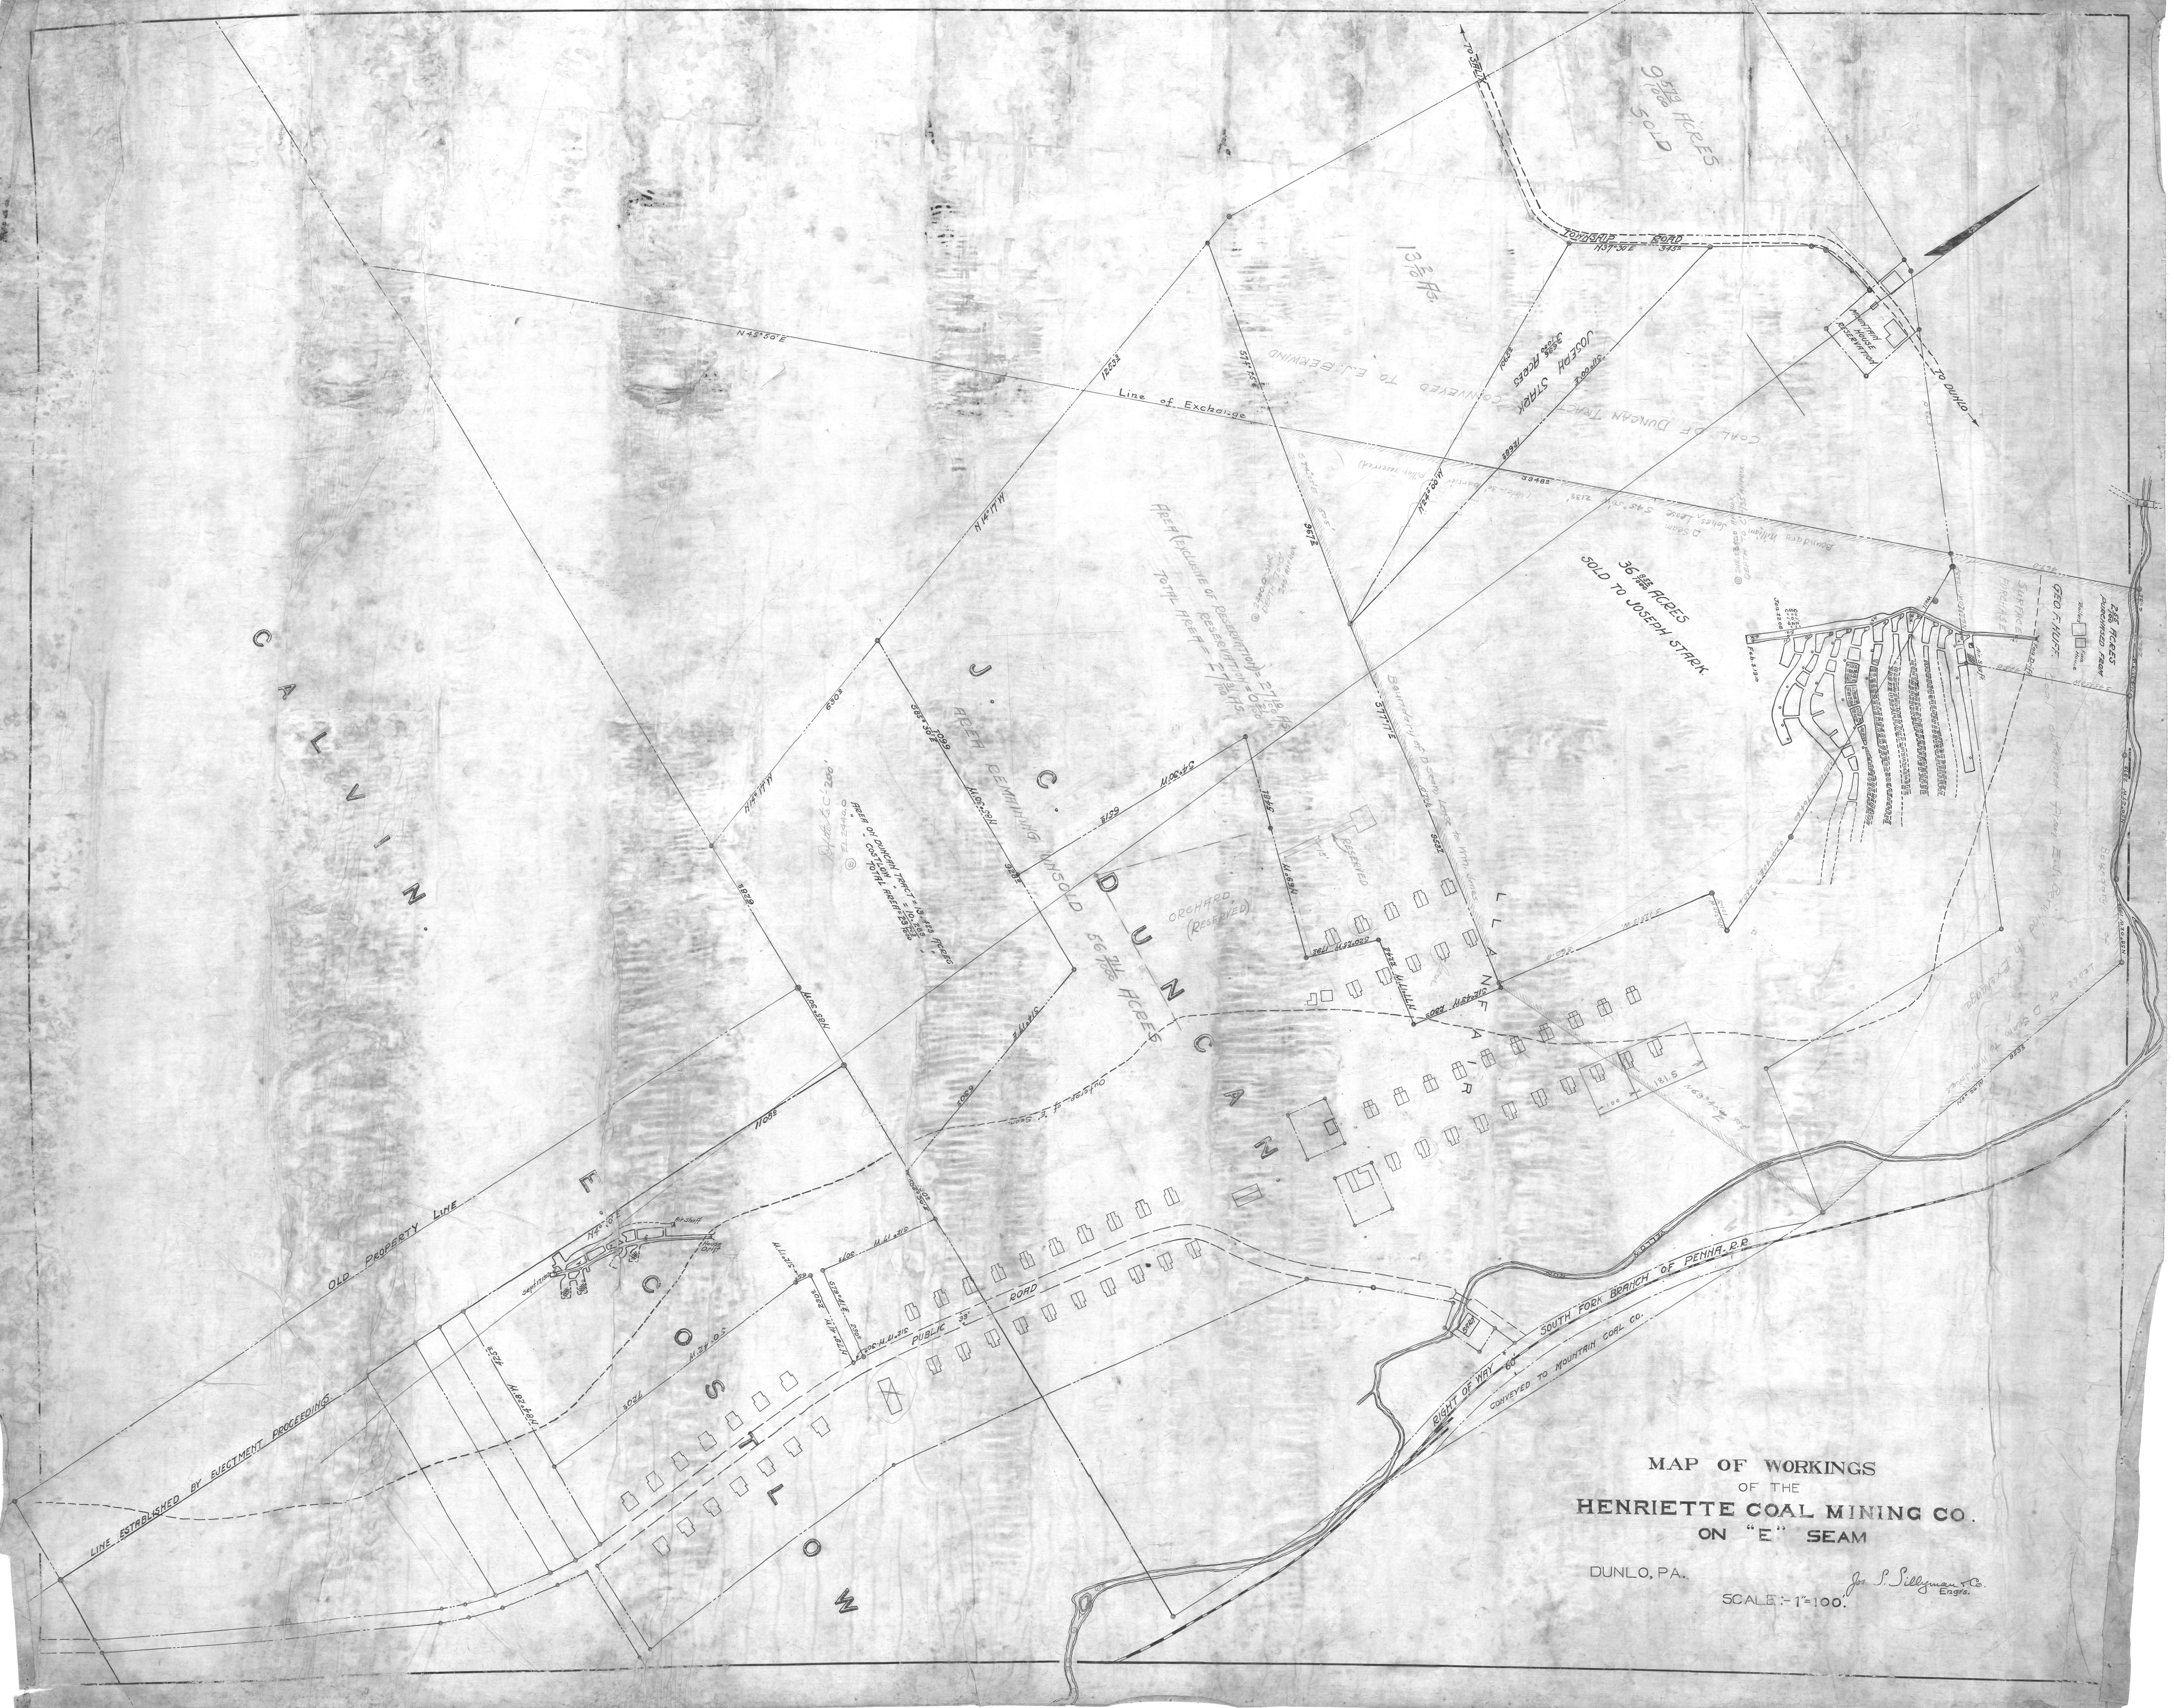
CALVIN.
J. C. DUNCAN
COSTLOW
FAIRALL
Line of Exchange
N45°50'E
OLD PROPERTY LINE
LINE ESTABLISHED BY EJECTMENT PROCEEDINGS
TO SALIX
TOWNSHIP ROAD
N37°30'E 345.0
TO DUNLO
MOUNTAIN HOUSE RESERVATION
9 579/1000 ACRES SOLD
13 2/10 As.
JOSEPH STARK 3 695/1000 ACRES
COAL OF DUNCAN TRACT CONVEYED TO E.J. BERWIND
36 852/1000 ACRES SOLD TO JOSEPH STARK
2 55/100 ACRES PURCHASED FROM GEO. F. HUFF
SURFACE PURCHASE
Boundary of Coal obtained from E.J. Berwind
Boundary of D Seam Lease to Wm. Jones
Boundary William Jones Lease D Seam
Lease of D Seam to Wm. Jones in Exchange
AREA (EXCLUSIVE OF RESERVATION) = 27 10/100 As
RESERVATION = 0 21/100
TOTAL AREA = 27 31/100 As
AREA REMAINING UNSOLD 56 711/1000 ACRES
AREA ON DUNCAN TRACT = 13.423 ACRES
" " COSTLOW " = 10.288 "
TOTAL AREA = 23 703/1000
ORCHARD (RESERVED)
RESERVED
Outcrop of "E" Seam
PUBLIC 33' ROAD
Air Shaft
House Drift
Sept. 17, 1912
Feb. 3, 1910
Jan. 22, '08
Fan Drift
Air Shaft
Well
BARN
RIGHT OF WAY 60' SOUTH FORK BRANCH OF PENNA. R.R.
CONVEYED TO MOUNTAIN COAL CO.
MAP OF WORKINGS
OF THE
HENRIETTE COAL MINING CO.
ON "E" SEAM
DUNLO, PA.
SCALE:- 1"=100'.
Jos. S. Sillyman & Co.
Engrs.