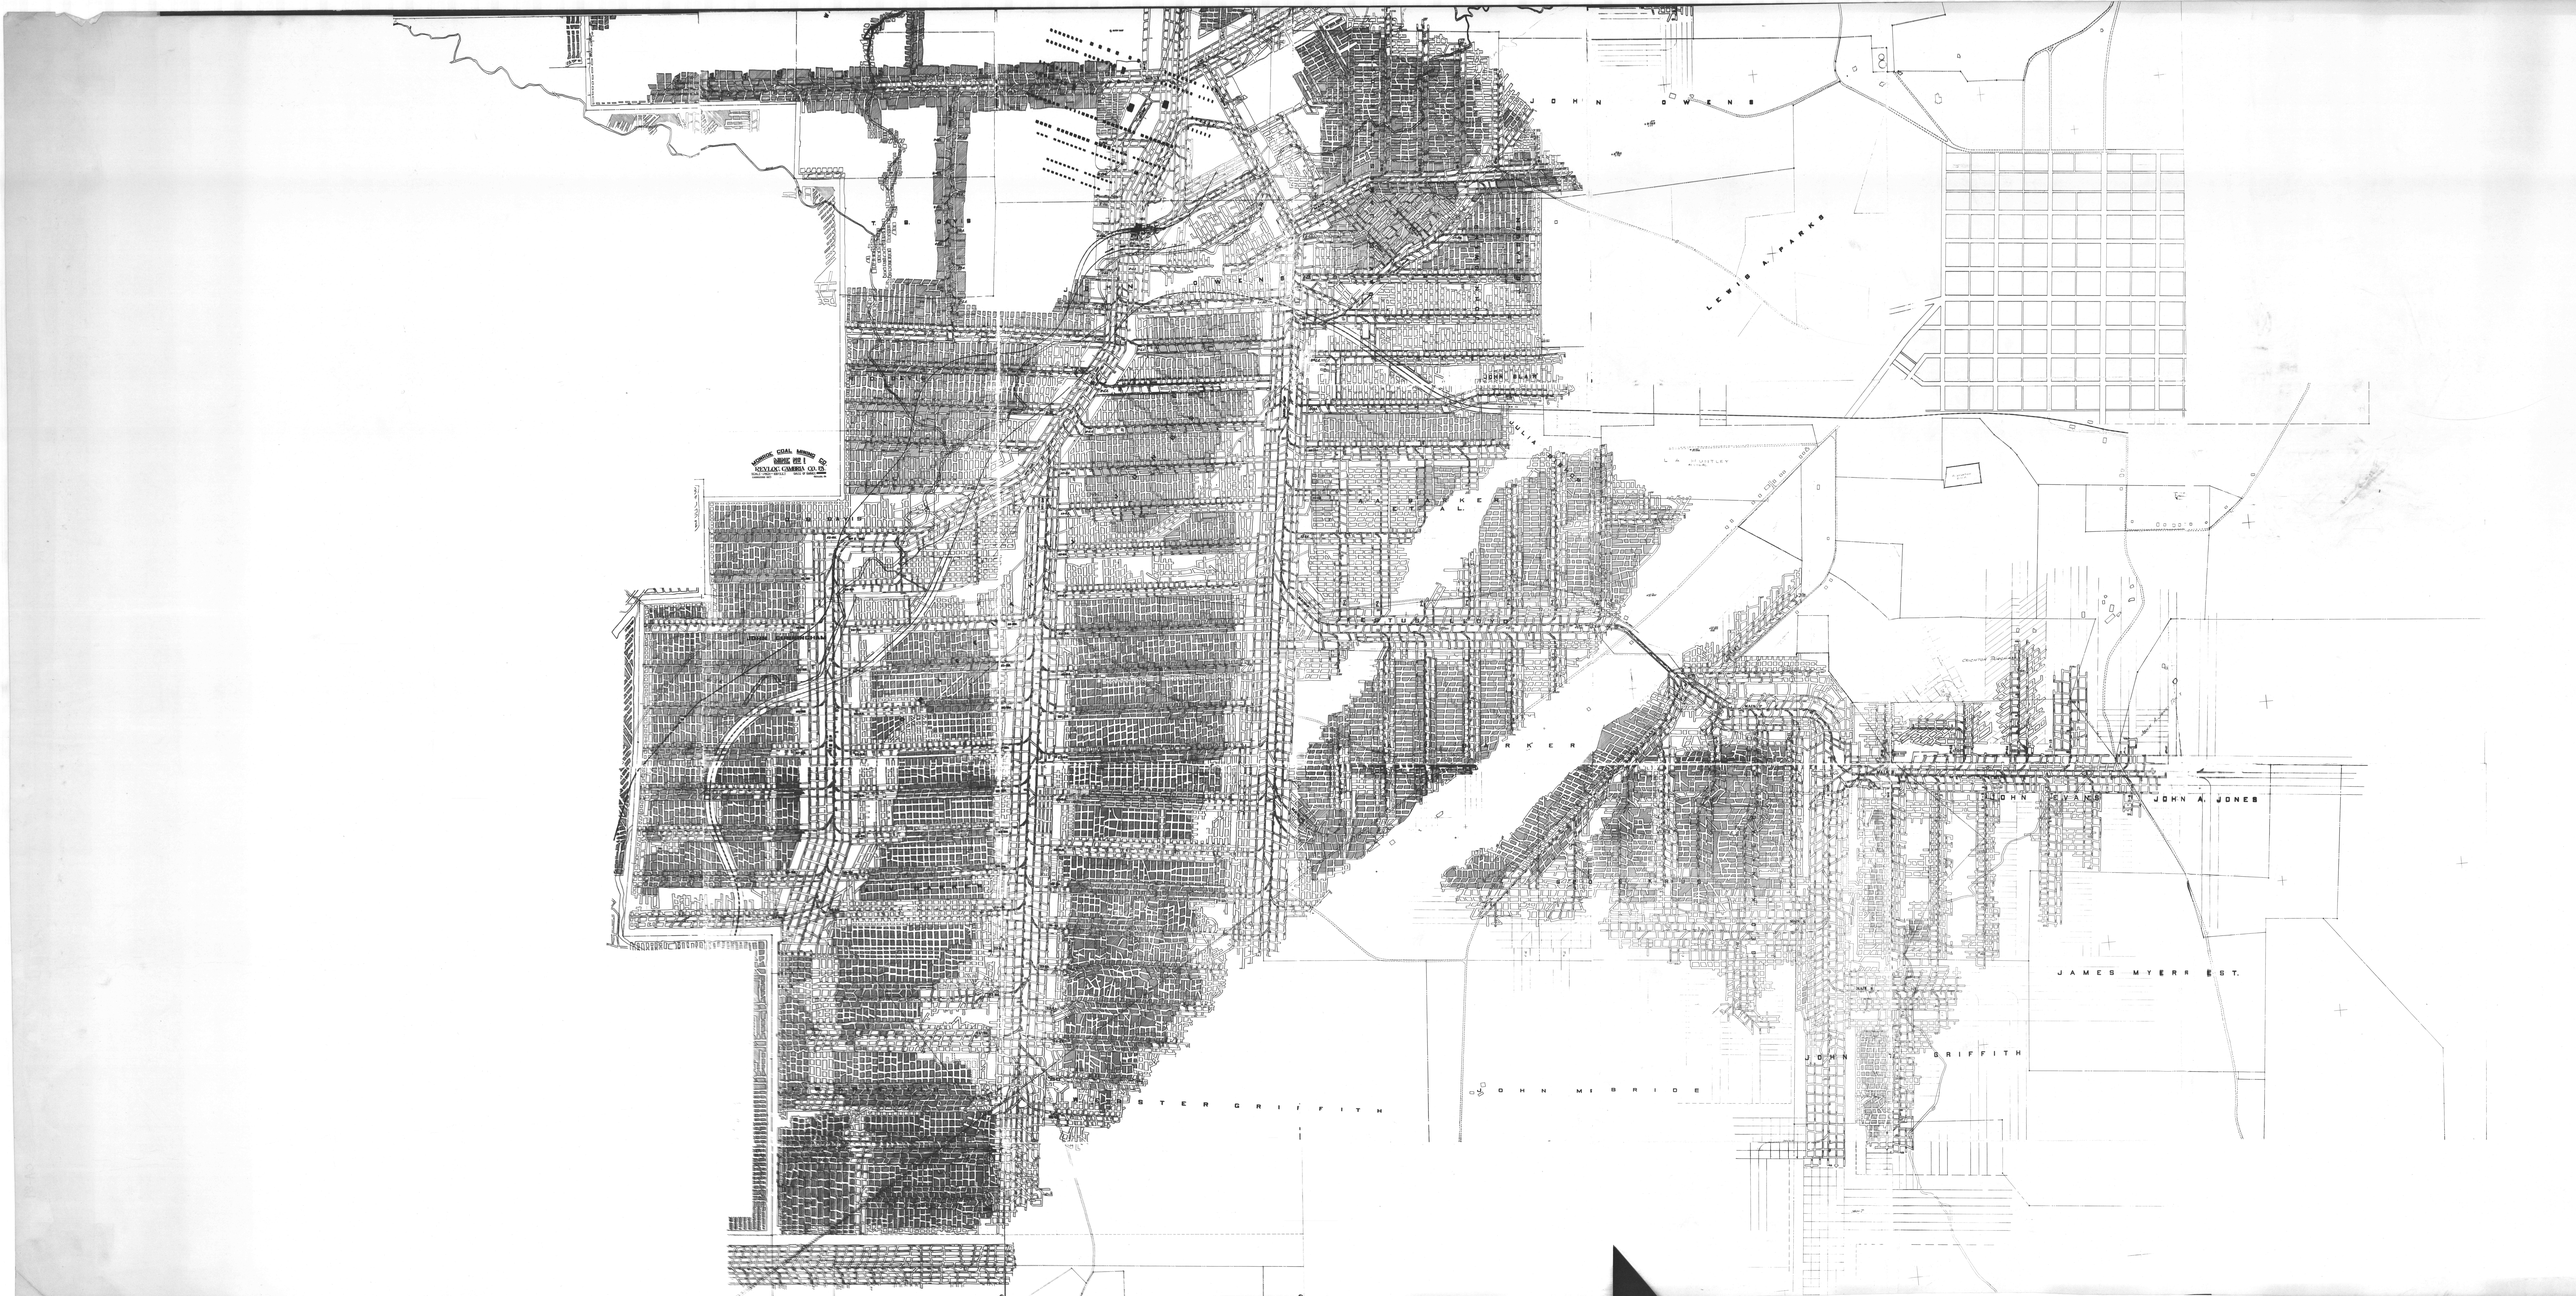
JOHN OWENS
LEWIS A. PARKS
JOHN MAIN
JULIA
JOHN A. JONES
JAMES MYERR EST.
JOHN GRIFFITH
JOHN McBRIDE
STER GRIFFITH