


F-C-4
CRESSON & CLEARFIELD C. & C.

PLACK

DOUGHERTY

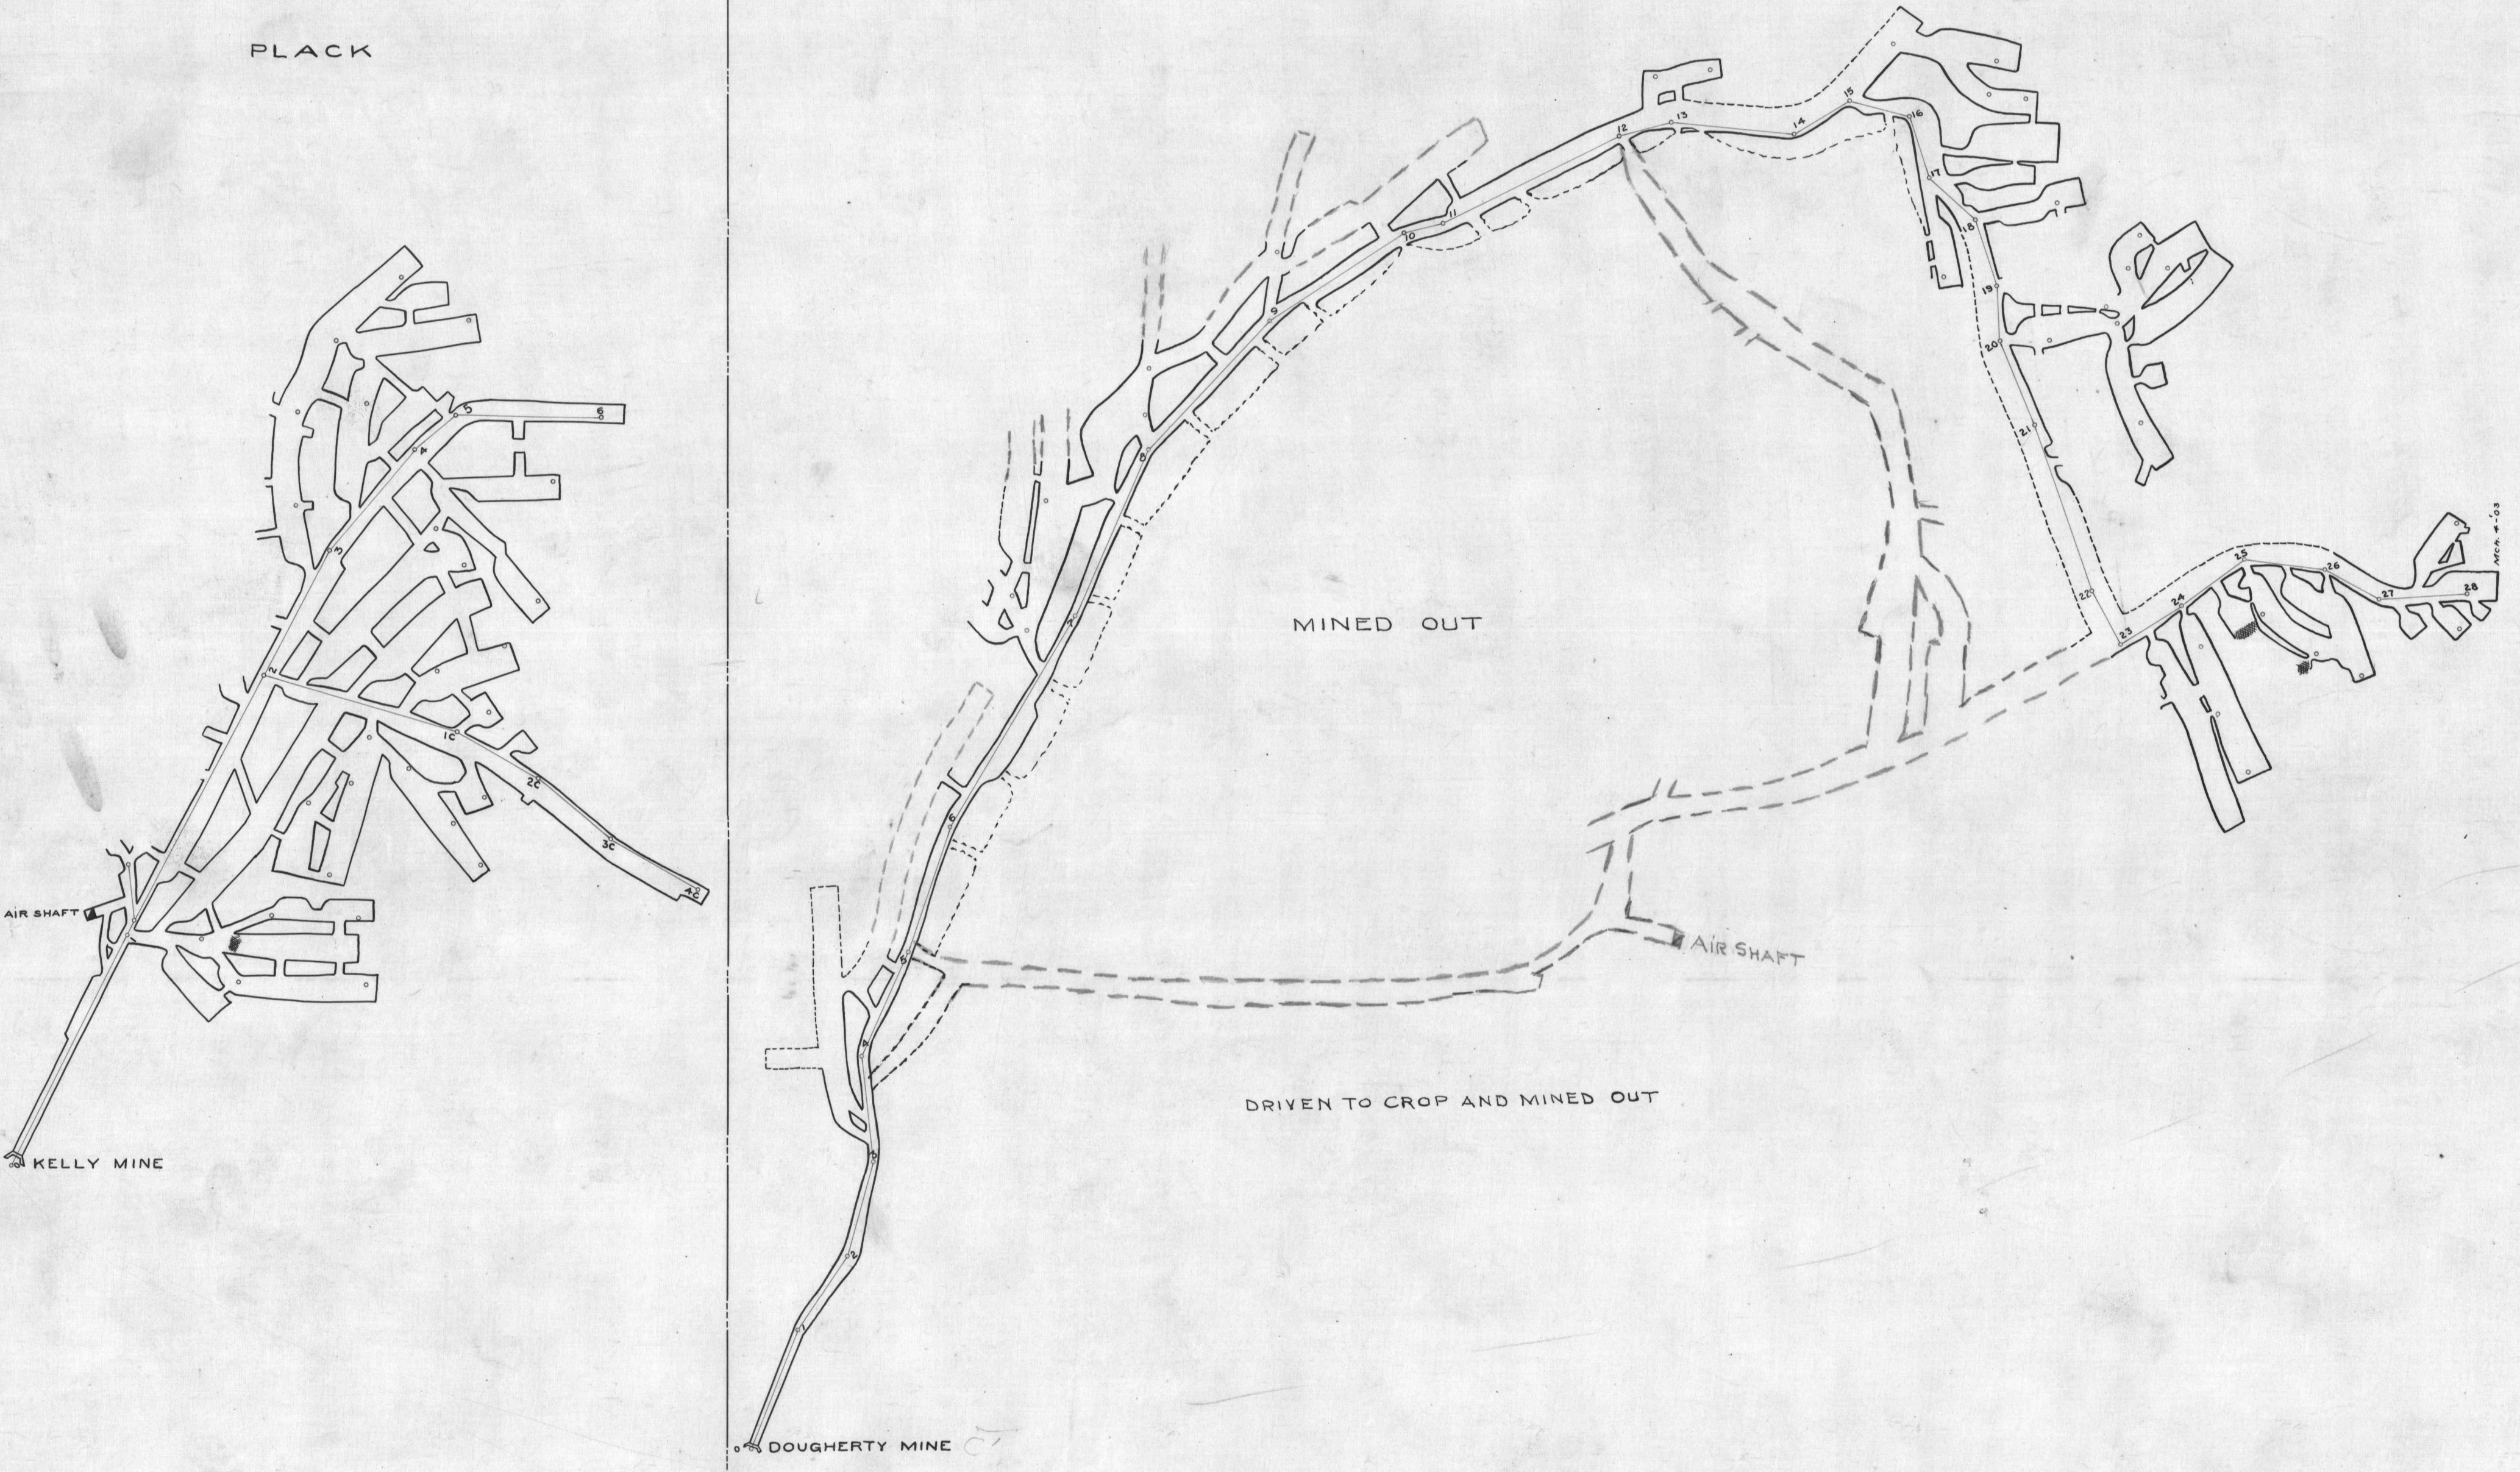

DOUGHERTY MINE

READE TOWNSHIP, CAMBRIA CO., PA.

Scale: 100' = 1".

Jos. S. SILLYMAN & Co.
ENGINEERS.

SHELLENBERGER & LOUDON, MINE

MORTON, BLISS & CO.

C7025-F

CV-05

F-C-4