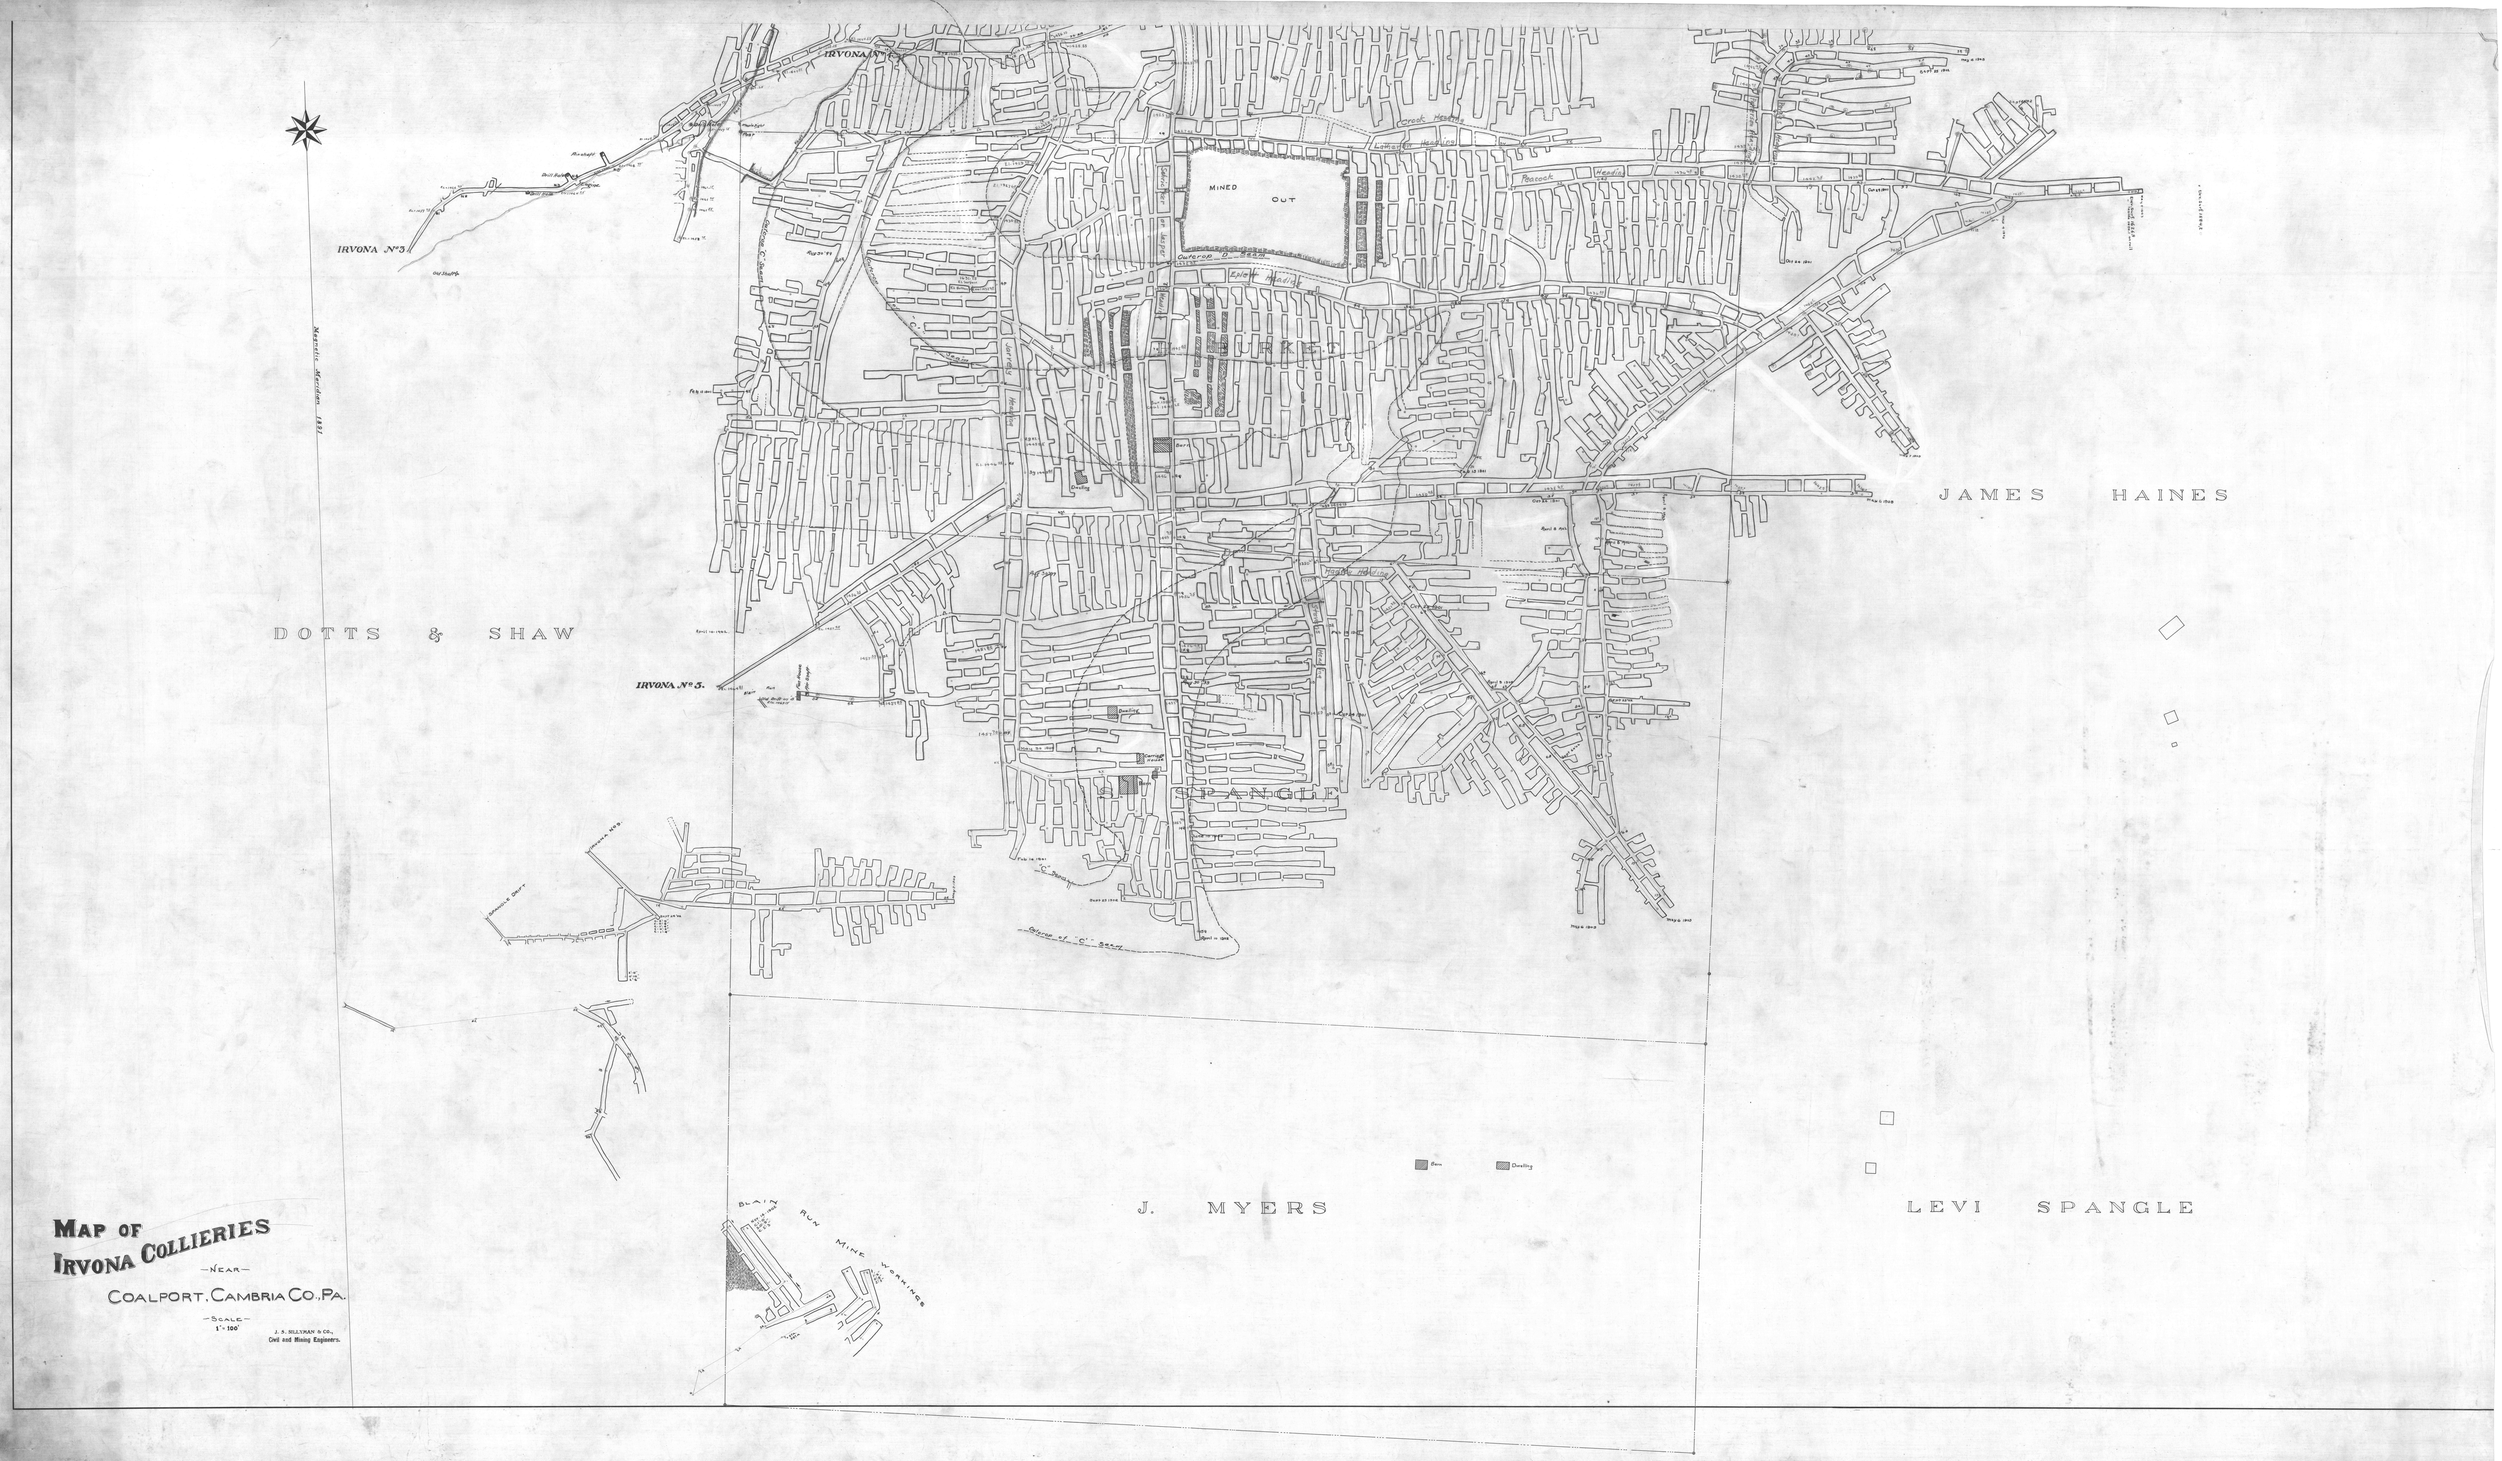

IRVONA No 3
IRVONA No 5.
MINED OUT
Peacock Heading
Outcrop D Seam
Eplett Heading
Jarrett Heading
Jarrett Heading
Crook Heading
Lamadeau Heading
Magnetic Meridian 1891
DOTTS & SHAW
JAMES HAINES
J. MYERS
LEVI SPANGLE
BLAIN RUN MINE WORKINGS
Dwelling
Barn
Map of
Irvona Collieries
—Near—
Coalport, Cambria Co., Pa.
—Scale—
1" = 100'
J. S. Sillyman & Co.,
Civil and Mining Engineers.