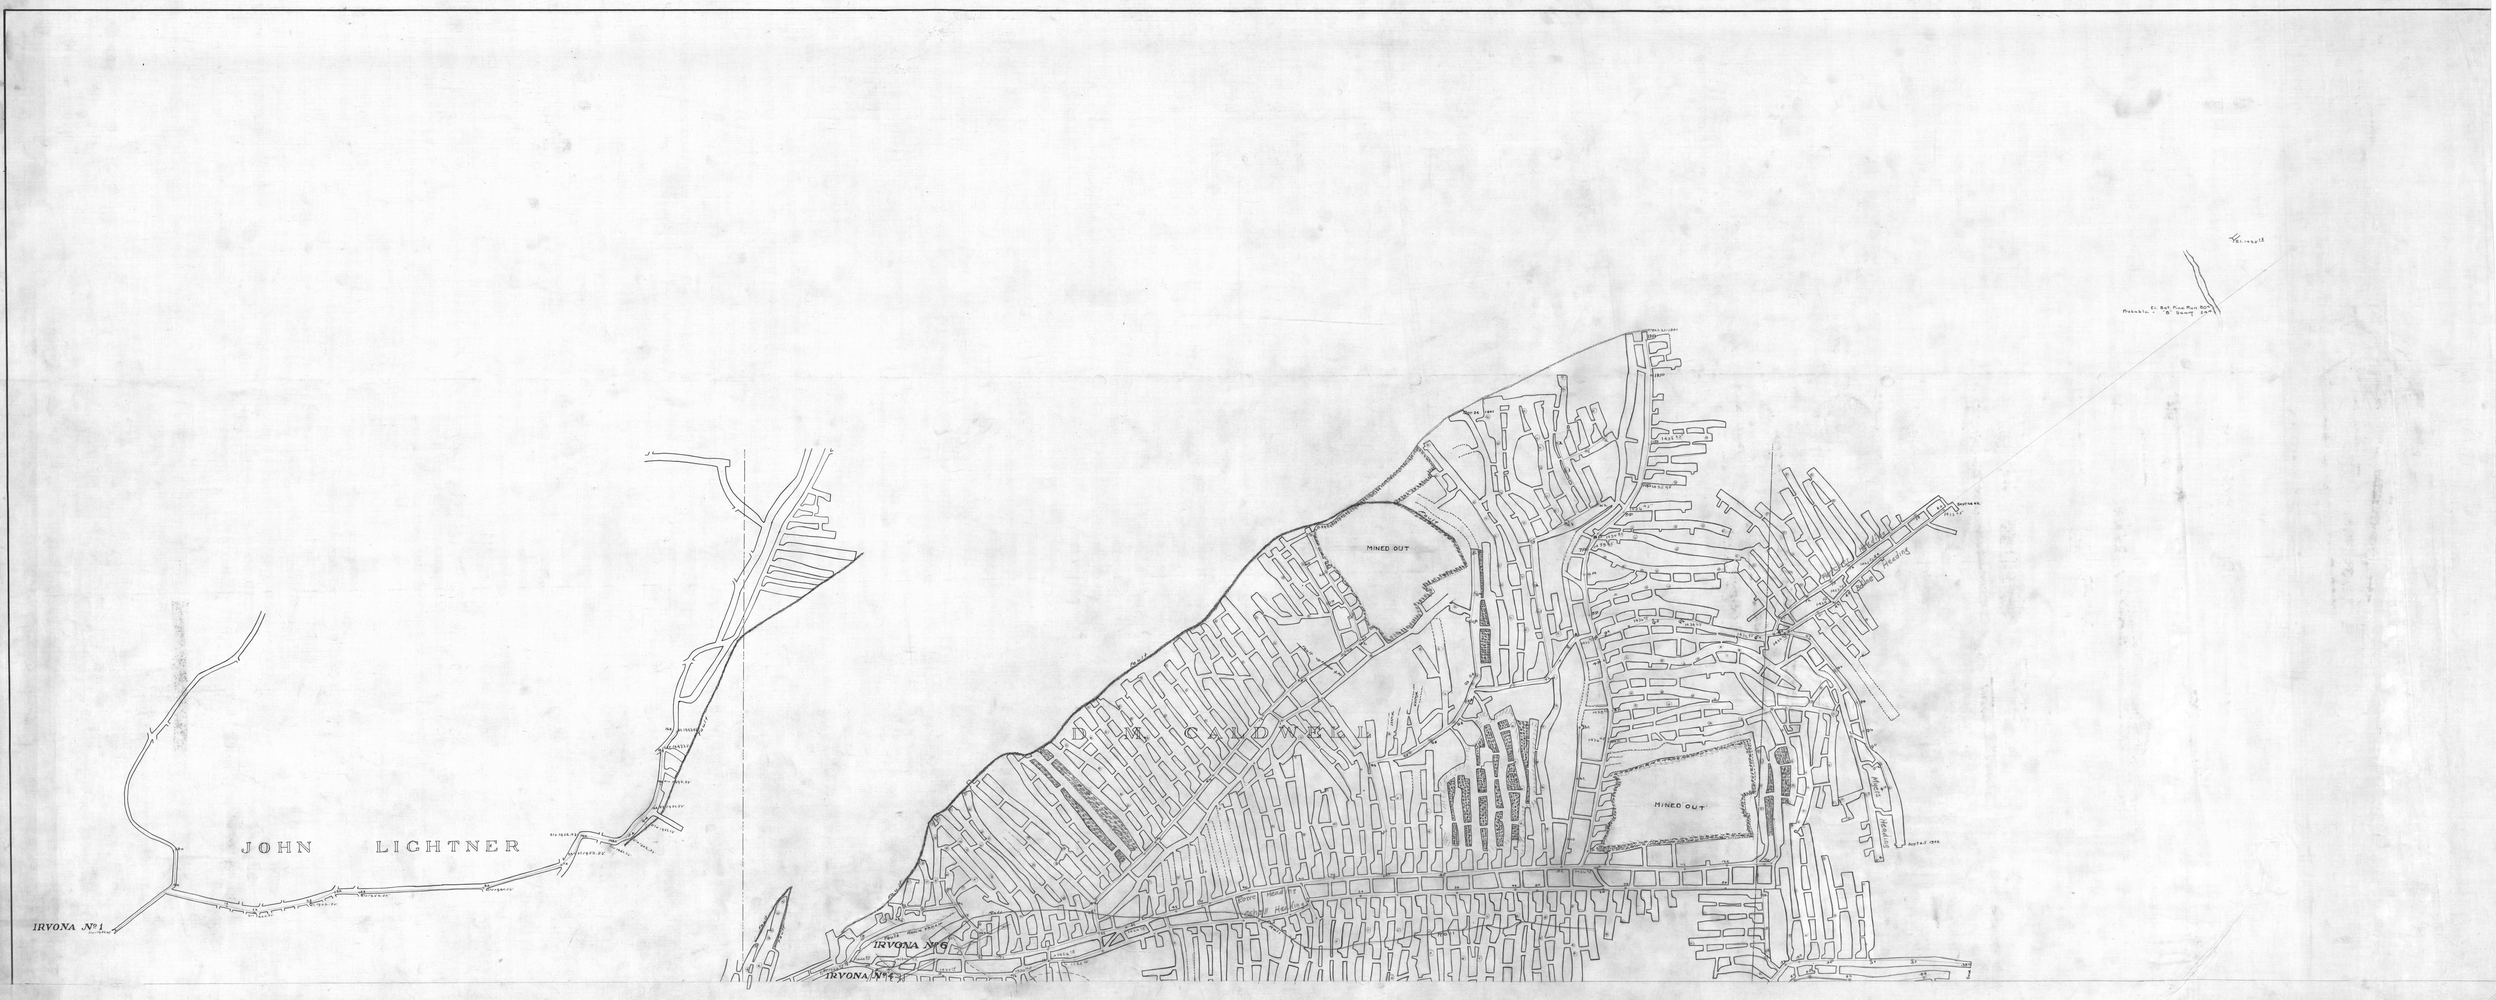
JOHN LICHTNER
D. M. CALDWELL
MINED OUT
MINED OUT
IRVONA No 1
IRVONA No 6
IRVONA No 3