


709-3

MAP OF
STRAYER BROTHERS COAL CO.
MINE ON "D" SEAM
NEAR FLINTON, CAMBRIA CO., PA.
J.S. Silliman & Co. Engrs. Altoona, Pa.
Scale: 1"=100'

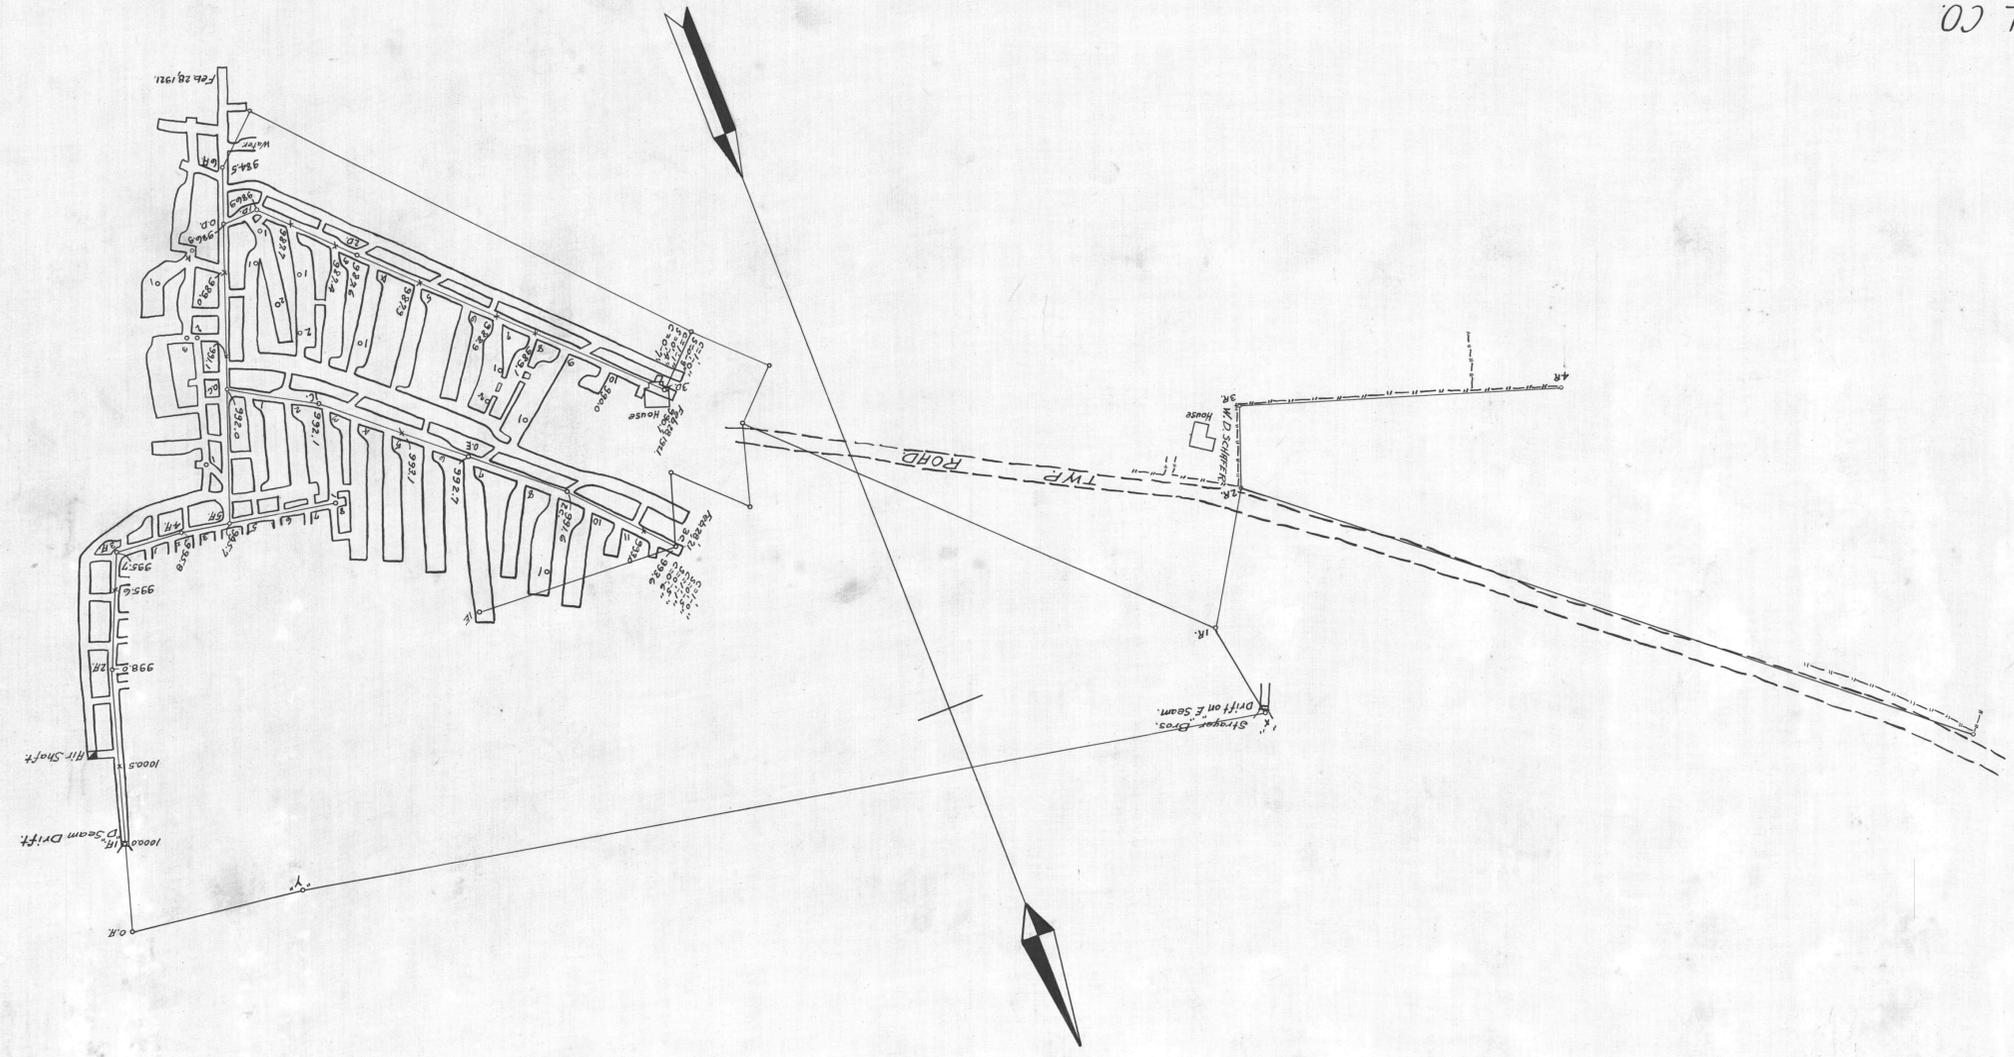

M-1

M-1