


MAP OF WORKINGS IN "B RIDER" SEAM  
OPERATED BY  
**JUNIATA COAL COMPANY**

ON LANDS OF  
**GAMBRIA MINING & MFG CO.**  
PORTAGE TOWNSHIP, GAMBRIA COUNTY, PA.

Geo. S. Robinson & Co.  
ENGINEERS.

SCALE: 1"=100'

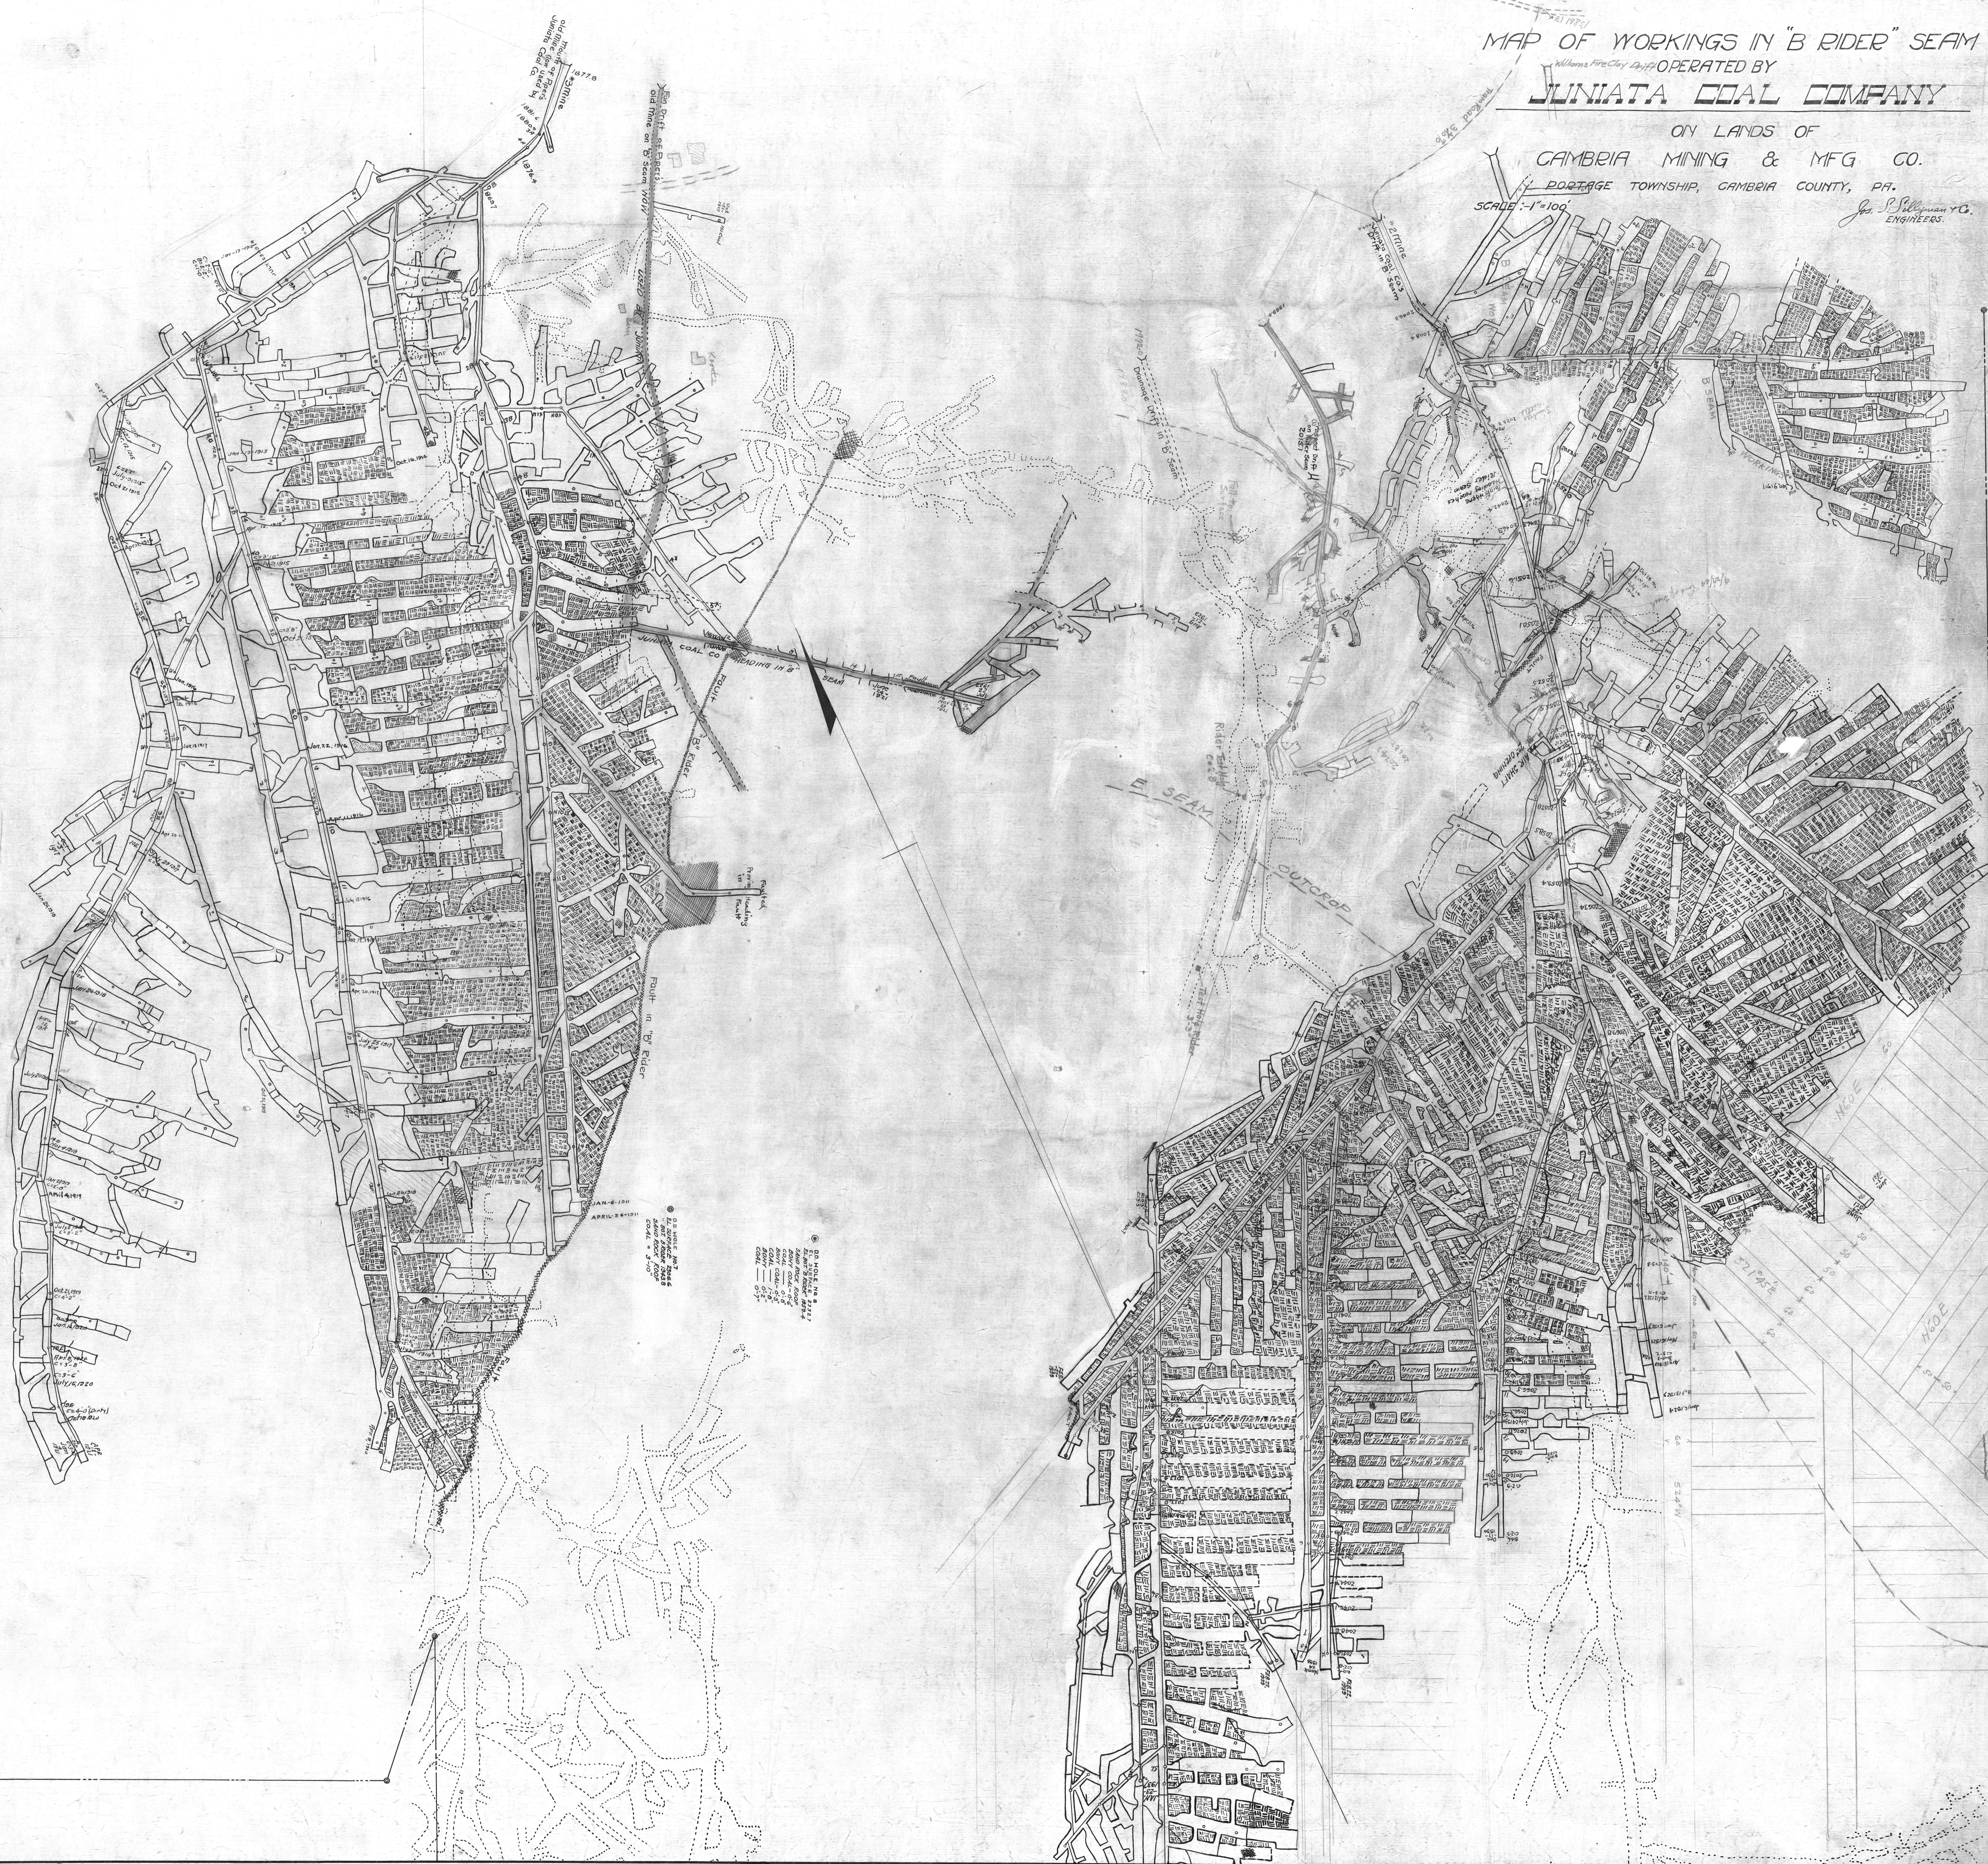


APRIL 24 1911

LEASE LINE

LEASE LINE