I-C-3

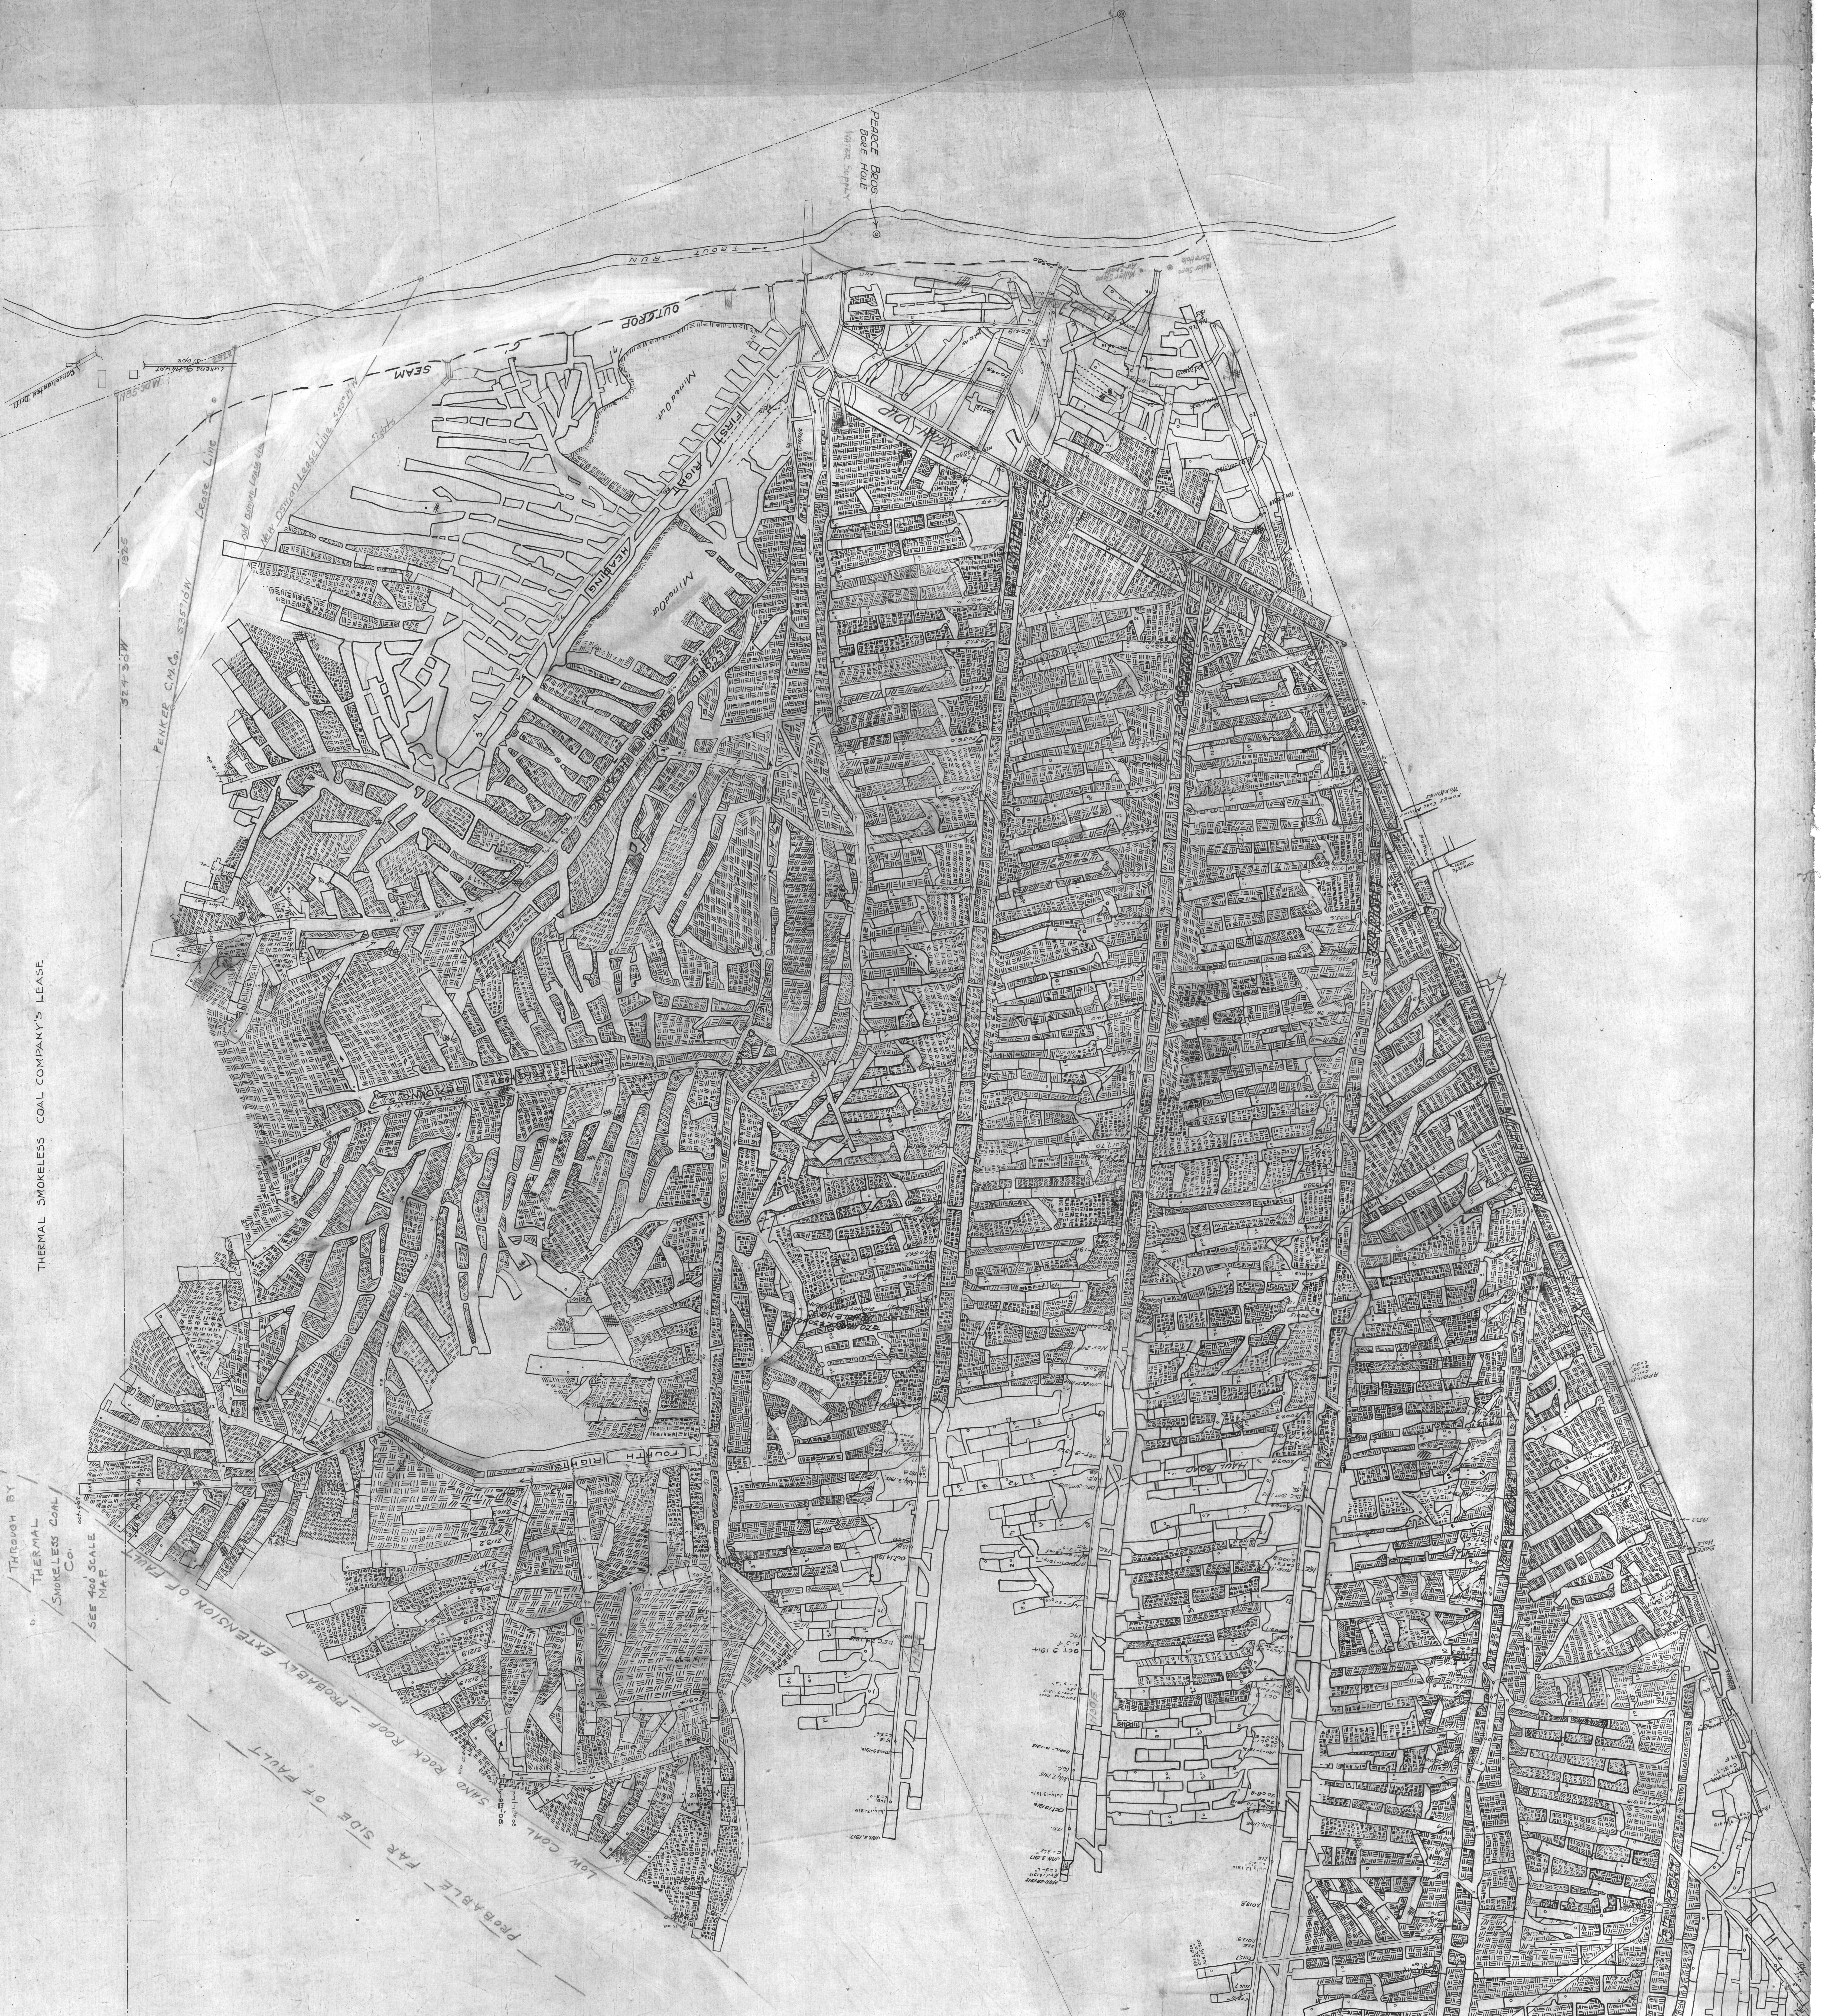
PEARCE BROS. BORE HOLE WATER SUPPLY
TROUT RUN
OUTCROP
SEAM
Consolidated Drift
Lukens & Haupt Slope
N 85° 30' W
1325
S 24° 30' W
Penker C.M.Co. S 35° 10' W Lease Line
Old Osman Lease Line
New Osman Lease Line S 55° W
Sights
Mined Out
Mined Out
FIRST RIGHT
HEADING
SECOND RIGHT
MAIN DIP
Miller Slope Air Shaft
Miller Slope Bore Hole
Force Coal Mining Co. Workings
Brattice
Concrete dam
THIRD RIGHT HEADING
FOURTH RIGHT
HAUL ROAD
THERMAL SMOKELESS COAL COMPANY'S LEASE
FAULT CUT THROUGH BY THERMAL SMOKELESS COAL CO. SEE 400' SCALE MAP.
LOW COAL SAND ROCK ROOF - PROBABLY EXTENSION OF FAULT
PROBABLE FAR SIDE OF FAULT
Sand Rock Roof
DIAMOND DRILL HOLE NO.4 ELEV. SURFACE 2331.2 " Bot. "E" COAL 2228.4 " "C" " 2102.2 - 3'-0" thick
DIAMOND DRILL HOLE NO.5 ELEV. SURFACE 2278.0 " Bot. "E" COAL 2165.3 " "C" " 2058.3 - 2'-11" thick
DIAMOND DRILL HOLE NO.6 ELEV. SURFACE 2329.7 " Bot. "E" COAL 2213.7 " "C" " 2104.1 - 3'-0" thick
D.D. HOLE #4 GEO. PEARCE & SON INC. ELEV. SUR. 2164.6
D.D. HOLE #3 GEO. PEARCE & SON. INC. ELEV. SUR. 2168.1 Not down to C seam

Map of "C" Prime Coal Lease of George Pearce & Sons

ON LANDS OF THE

CAMBRIA MINING & MAN'F'G CO.,

CAMBRIA COUNTY, PA.

Scale 1" = 100'. J. S. Sillyman & Co.

1906.

I-C-3