


BURD COAL AND IRON CO.

LEHIGH VALLEY COAL CO.

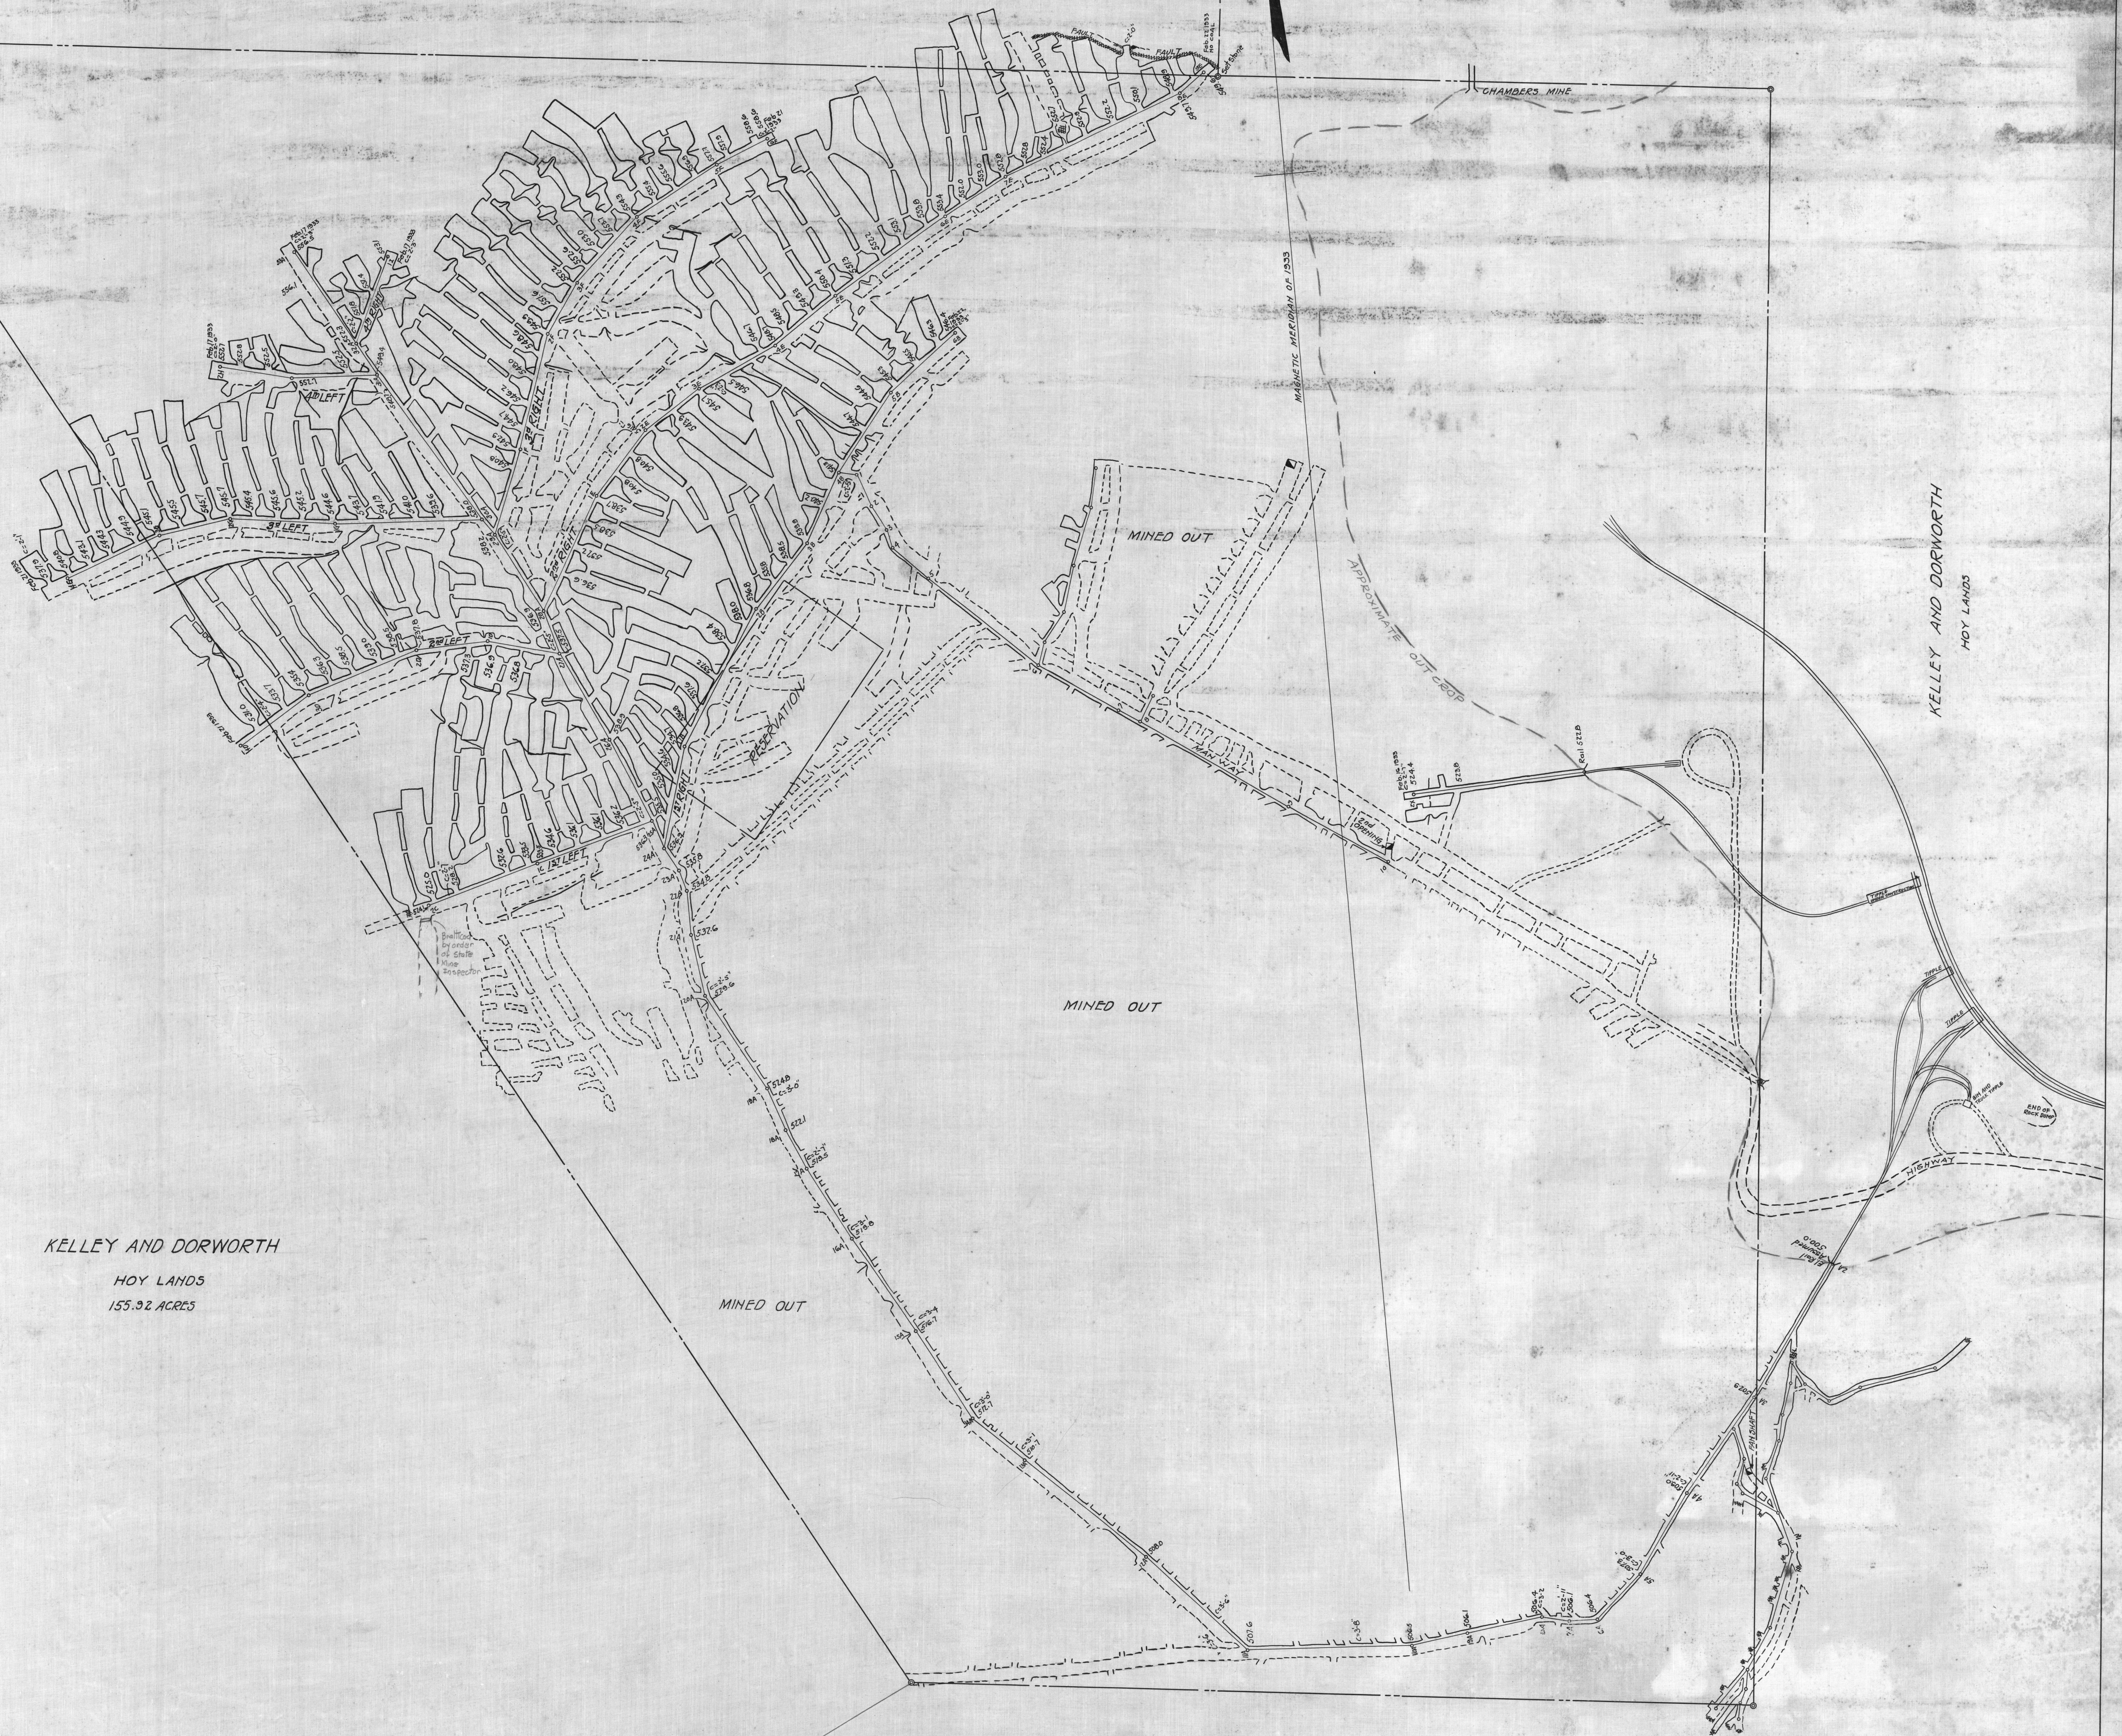

KELLEY AND DORWORTH  
HOY LANDS  
155.92 ACRES

LEHIGH VALLEY COAL CO.  
MCCLELLAN TRACT

MAP OF  
WM HOLT ESTATE TRACT AND HOY LANDS  
IN SNOWSHOE AND BURNSIDE TOWNSHIPS, CENTER COUNTY, PA.  
SHOWING MINING WORKINGS OF  
SNOWSHOE COAL CO.  
FORMERLY CHERRY RUN NO. 2 MINE,  
IN 'A' SEAM OF COAL.  
SCALE 1"=100' MARCH 1933. W.A. SULLIVAN,  
ENGINEER, ALTOONA, PA.

NOTE:  
ELEVATIONS SHOWN ON THIS MAP  
ASSUMED TO BE MEAN SEA LEVEL.