


SECTION THROUGH ENGINE SHAFT

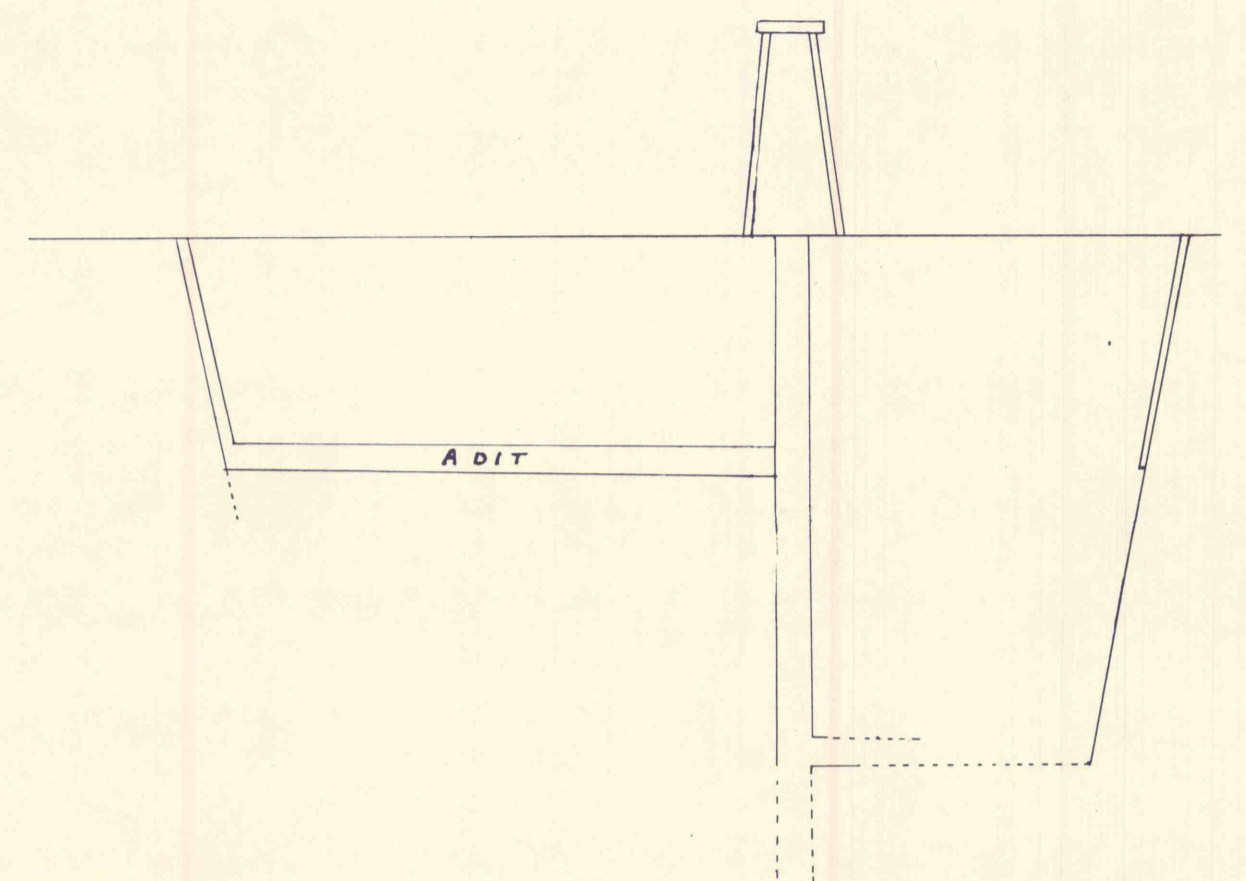


PLAN OF UNDER-GROUND WORK.

ADIT LEVEL

CHESTER COUNTY MINING COMPANY.

1851

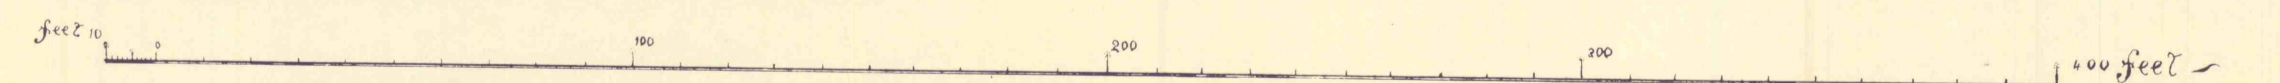

SCALE