PROPERTY MAP

SHOWING 1144 ACRE TRACT OF THE

CLEARFIELD & CAMBRIA C.&C.Co's PROPERTY

LOCATED EAST OF MAHAFFEY

Scale: One Inch = 1000 Feet

DRIFT "B" BED
Sh.
Coal 1'-0"
Slate 0'-1½"
Coal 1'-6"
El. 1301

"D" Drift
El. 1482.09
Coal 0'-4"
Binder 0'-0½"
Coal 0'-2"
Binder 0'-0½"
Coal 1'-7½"
Binder 0'-1"
Coal 0'-9½"
Old Bore hole

Coal 2'-1"
Binder Coal 1½" 0'-8" El. 1321
Mahaffey Bros Coal Mine

West Branch of Susquehanna River
New York Central & Hudson River R.R.
N.Y.C. & H.R. R.R.
Pennsylvania R.R.
Chest Creek
Railroad
Snyder Run

D.H. "A"
D.H. "B"
MAHAFFEY
OSTEND

A. Campbell 83 Ac 82¾ P
J. Black 38 Ac. 129.9 P
S. Kauffman 106 Ac. 25⅝ P
J.A. Ellis 22 A 18 P
J. Kauffman 9 Ac.
D. Kauffman 12 Ac 108 P
J. McFadden 84 Ac. 11 Z P
J. M Smyer 50 Ac 23 P
Ellis 121 Ac 44 P
DDH No 4
Adam Coppler 105 Ac 11 Z P
J. DeHaven 20 A 3⅝ P
E. DeHaven 15 A 2¼ P
W. DeHaven 50 Ac 102 P
G. W. Byers
J. & A. Johnson 75 Ac 133¼ P
G.W. Byers 50 Ac 114⅔ P
Robert Mahaffey 89 A 124⅔ P
Irvin & Jose 209 Ac 39 P

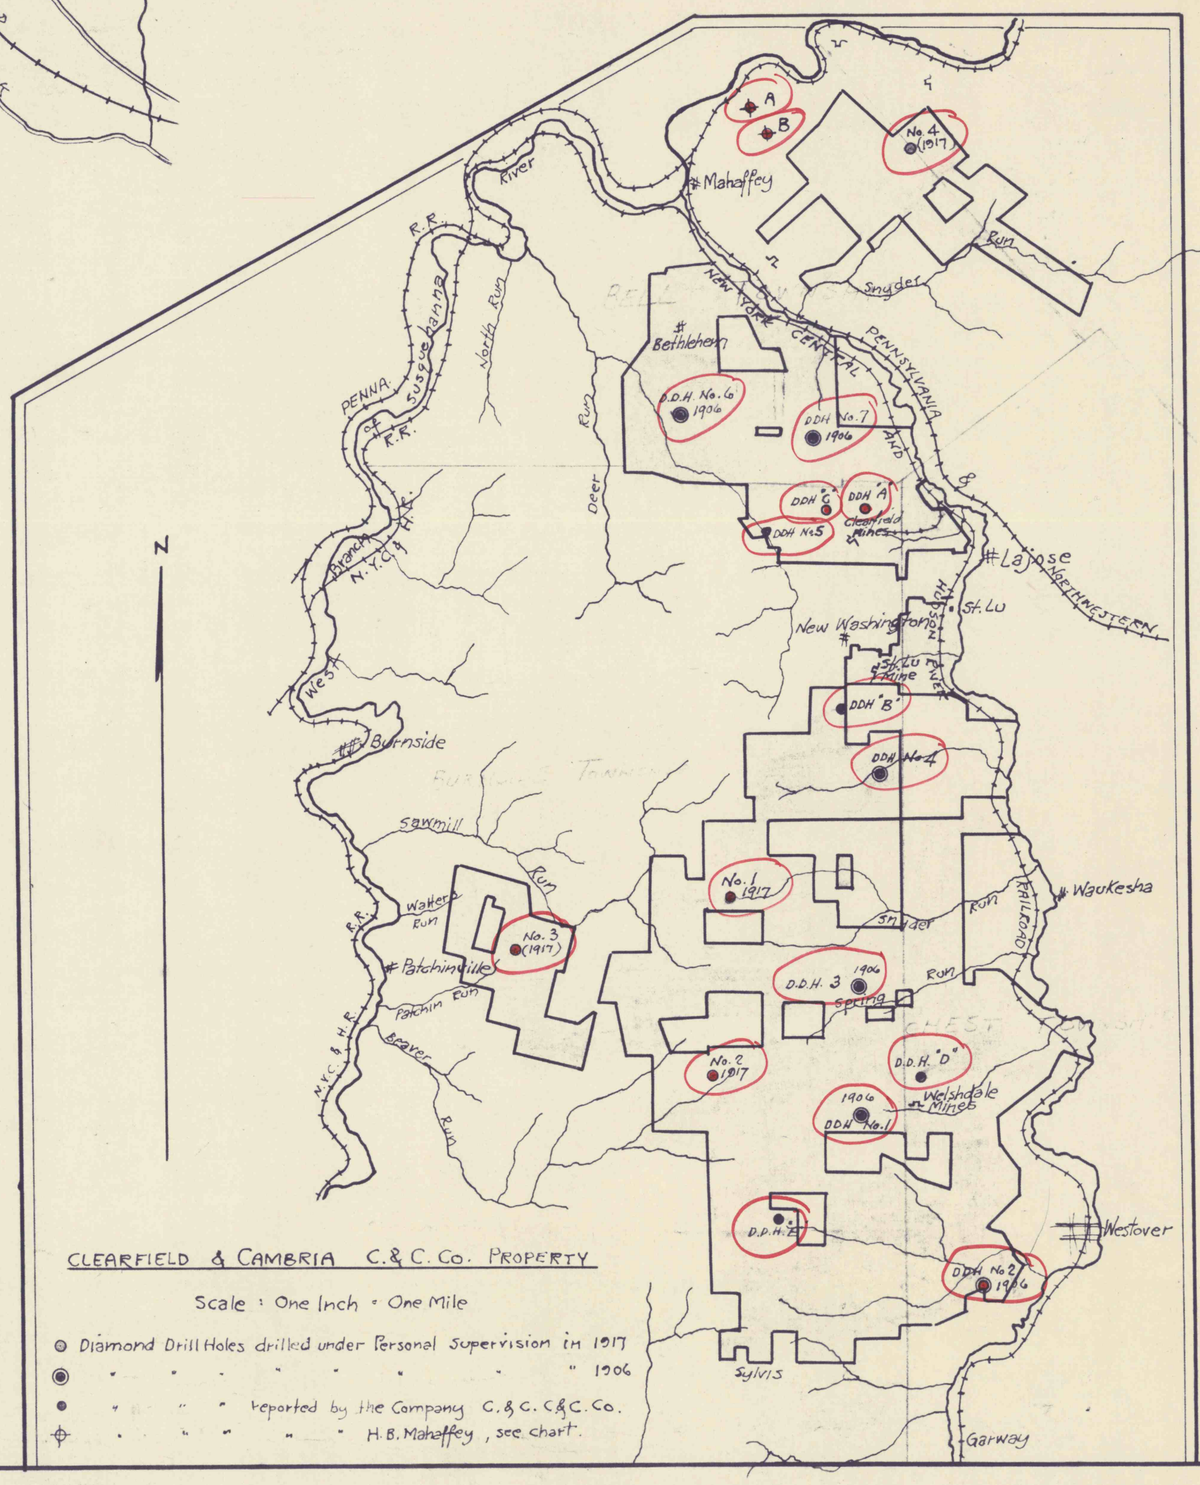

CLEARFIELD & CAMBRIA C.& C. Co. PROPERTY

Scale : One Inch = One Mile

- Diamond Drill Holes drilled under Personal Supervision in 1917
- " " " " " " 1906
- " " " reported by the Company C.& C. C&C. Co.
- " " " " H.B. Mahaffey, see chart.

D-346-2