

6000.0 North

5000.0 North

4000.0 North

3000.0 North

1000.0 East

2000.0 East


3000.0 East

4000.0 East

GRANT SHOWERS

BALDAUF COAL & COKE CO.

JOHN SHERRY

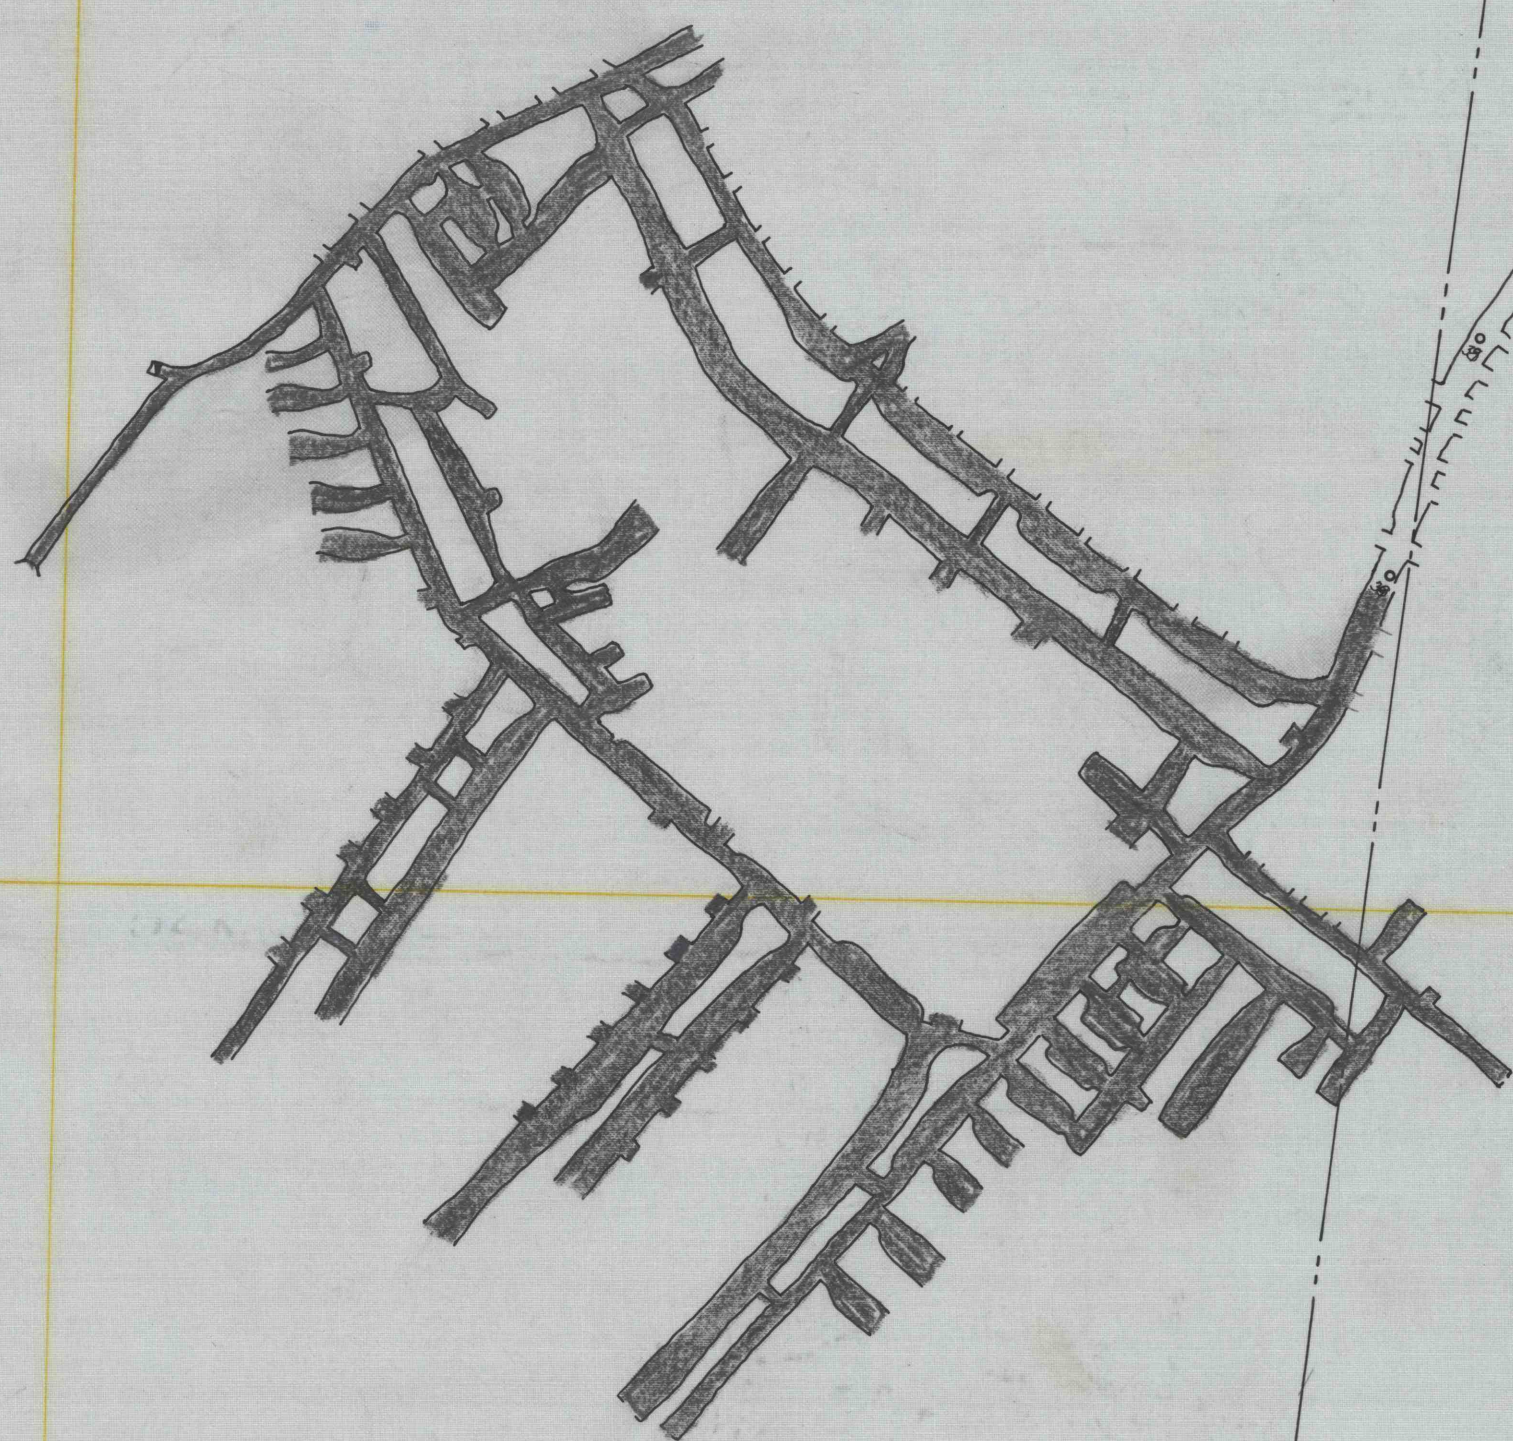


WORKED OUT & CAVED

WORKED OUT & CAVED

BALDAUF COAL & COKE CO.
 MINE NEAR MATTERSON CLARION Twp.
 CLARION Co., PENNA.

Scale 1 in. = 100 ft.
 June 27, 1921

H.M. Kanarr Engr.
 Punxsutanney Pa.

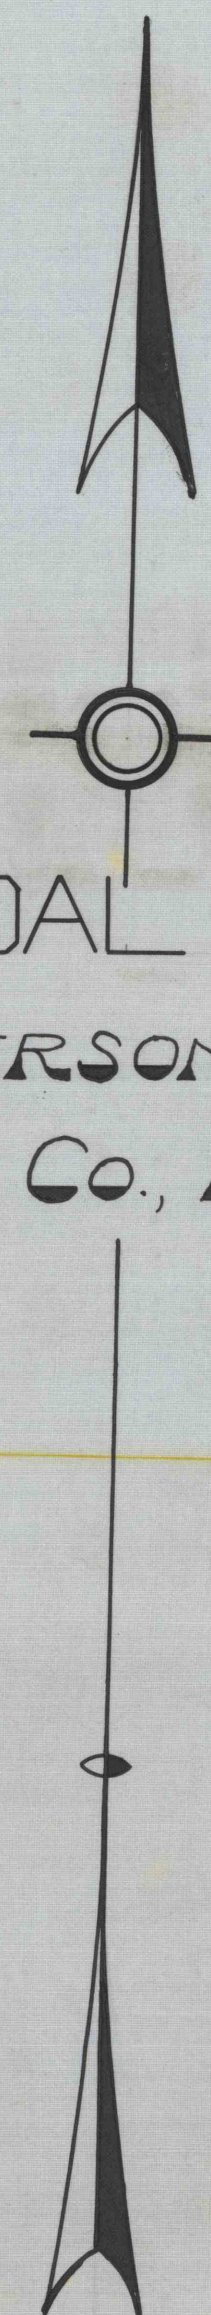

NOTE.
 Tinted portion not accessible, traced
 from blue print made by Harry T. Kissell
 Nov. 19, 1913.

Handwritten notes:
 Change the location of the
 shaft to the position
 shown on the map of the
 mine.

2-A-12