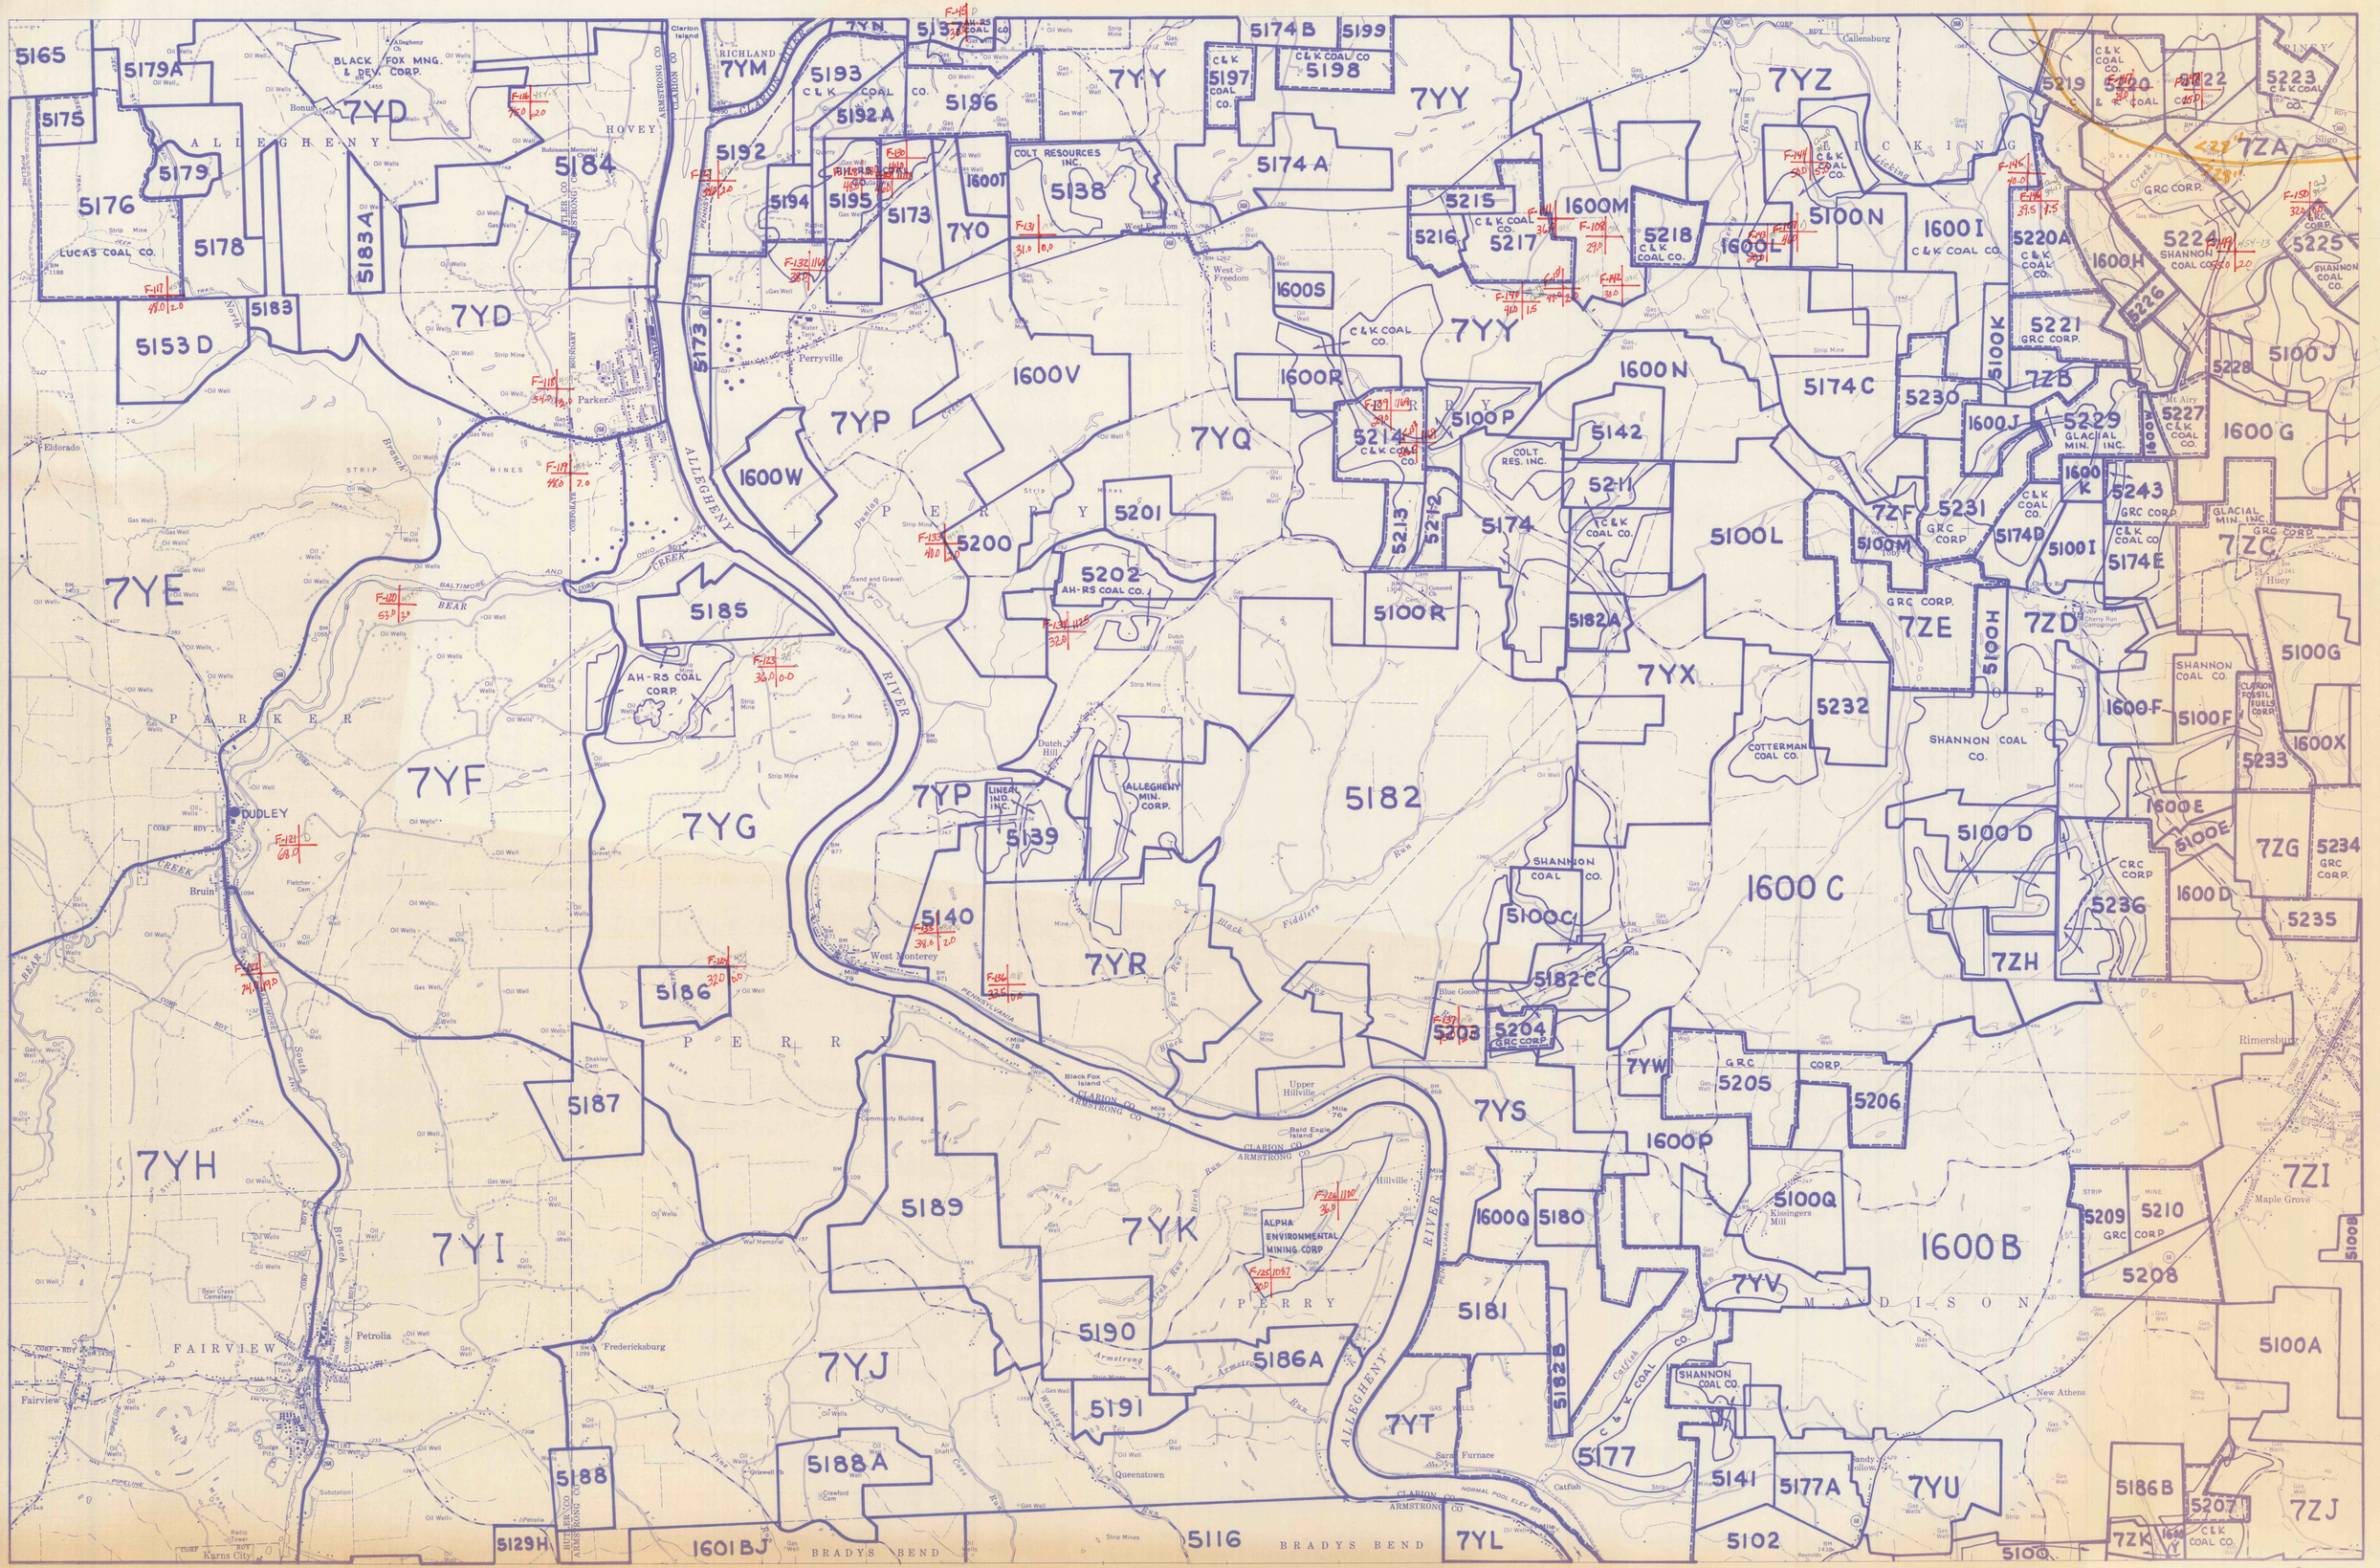
5165
5179A
5175
7YD
ALLEGHENY
5176
5179
5178
LUCAS COAL CO.
5183A
5184
HOVEY
5183
5153 D
7YD
7YE
7YF
7YG
7YH
7YI
7YJ
7YK
7YM
7YN
7YP
7YQ
7YR
7YS
7YT
7YU
7YV
7YW
7YX
7YY
7YZ
7ZA
7ZB
7ZC
7ZD
7ZE
7ZF
7ZG
7ZH
7ZI
7ZJ
7ZK
7YL
5193
5192A
5192
5194
5195
5196
5173
5174 B
5199
5198
5197
5174 A
5138
1600T
7YO
1600S
1600V
1600W
1600R
5200
5201
5202
5214
5213
5212
5215
5216
5217
1600M
5218
1600L
5100N
1600I
5219
5220
5222
5223
5224
5225
5226
5221
1600H
5220A
5100K
5230
1600J
5229
5227
5228
5100J
1600G
5174 C
5142
5211
5174
5100P
5100L
5100M
5231
5174D
5100I
5174E
5243
1600K
5100H
5100F
1600F
5100G
5233
1600X
5234
1600E
5100E
1600D
5235
5236
5100D
1600 C
5100C
5182C
5182A
5182
5232
5139
5140
5186
5187
5189
5190
5186A
5191
5188
5188A
5129H
1601BJ
5116
5180
5181
5182B
5177
5141
5177A
5102
5100Q
5205
5206
5204
5208
5209
5210
1600P
1600Q
1600B
5100Q
5100A
5186B
5207
5100Y
5100V
5100W
5100X
5100Y
5100Z
5100S
5100T
5100U