


Forest County  

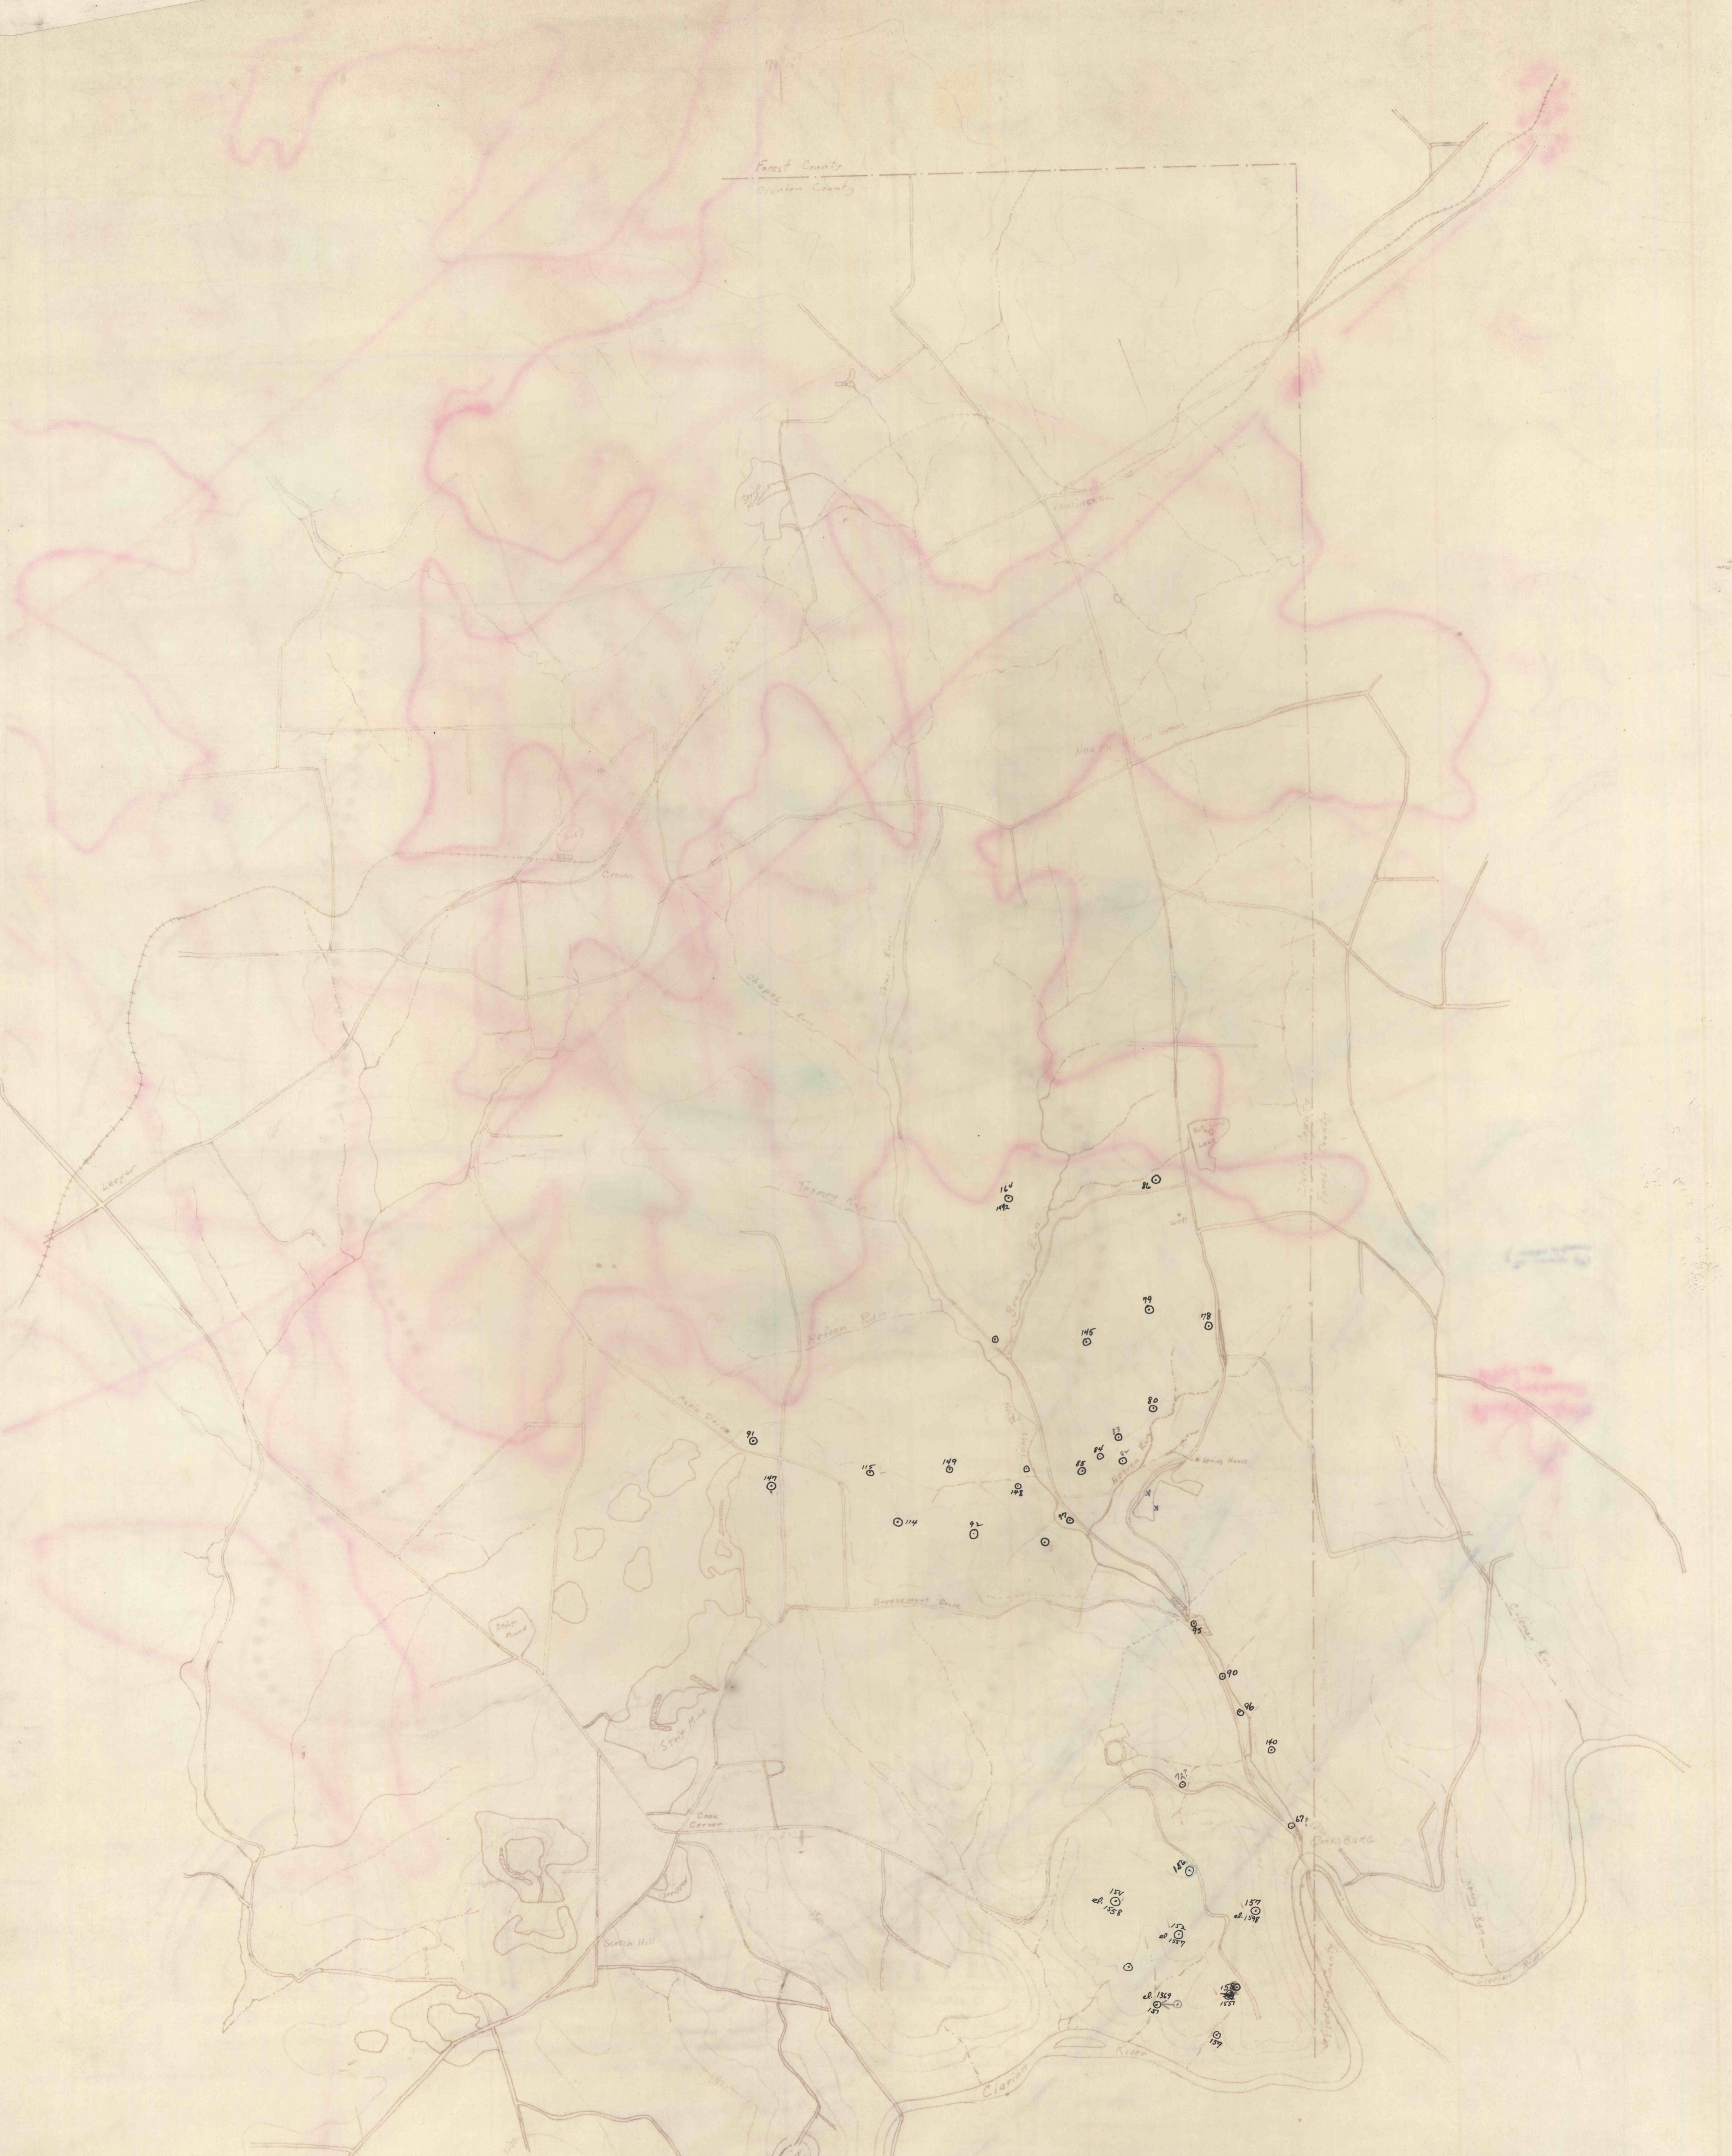

1:20,000  
Toms Run Watershed  
Coke Forest State Park  
Well Location