

28
26
24
22
18
16
14
12
10
8
6
4
2
PWMS 03044 86 34X 3
PWMS 03044 87 34X 316096
8
10
12
14
16
18
20
22
24
26
28
30

H.F.&C.F.STRATTAN.

STRATTAN HEIRS.


J.M.&C.M.BUZARD.

W.H.YOUNG.

J.M.OWENS.

E.J.JONES.

H.S.
CORBETT.

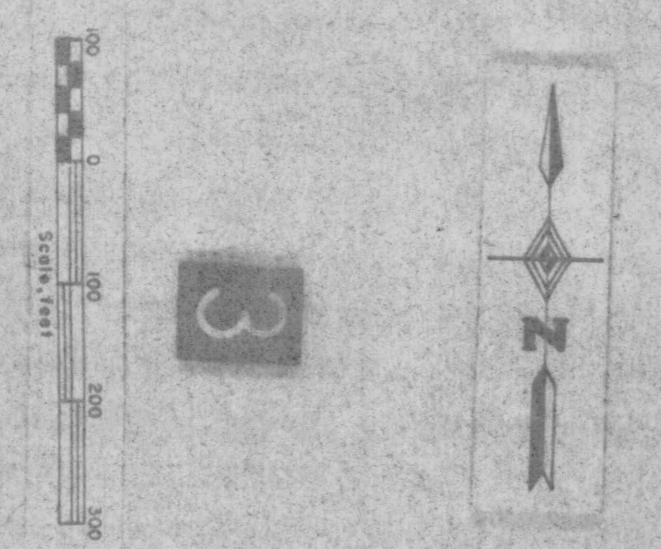

3


PENNSY COAL CO.

GORDON No.3 Mine

J.SMATHERS

U.C.JONES.

S.A.WILSON.

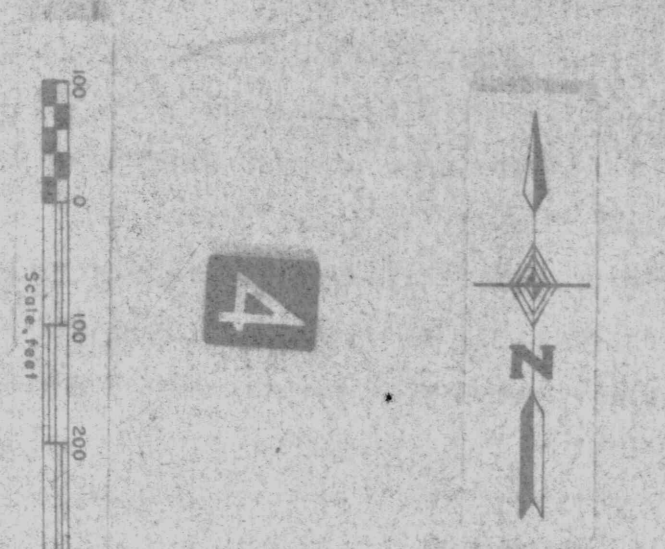

4

D.H.ROGERS.

LEGEND:
Property Lines
Railroads
Public Roads
Gas Wells
Shell Holes
Coal Outcrops
Educated Coal Areas
Country Docks



2

PENNSY COAL CO.
MAP
GORDON No.3 MINE
Scale 1/2" = 500 feet Nov 1930
Charles A. Bond Co.
Pittsburgh Pa.

I hereby certify that this is a true and correct copy of the original map as it was completed and correct and true copy of all the alterations made to the above map since its making by me and my assistants.