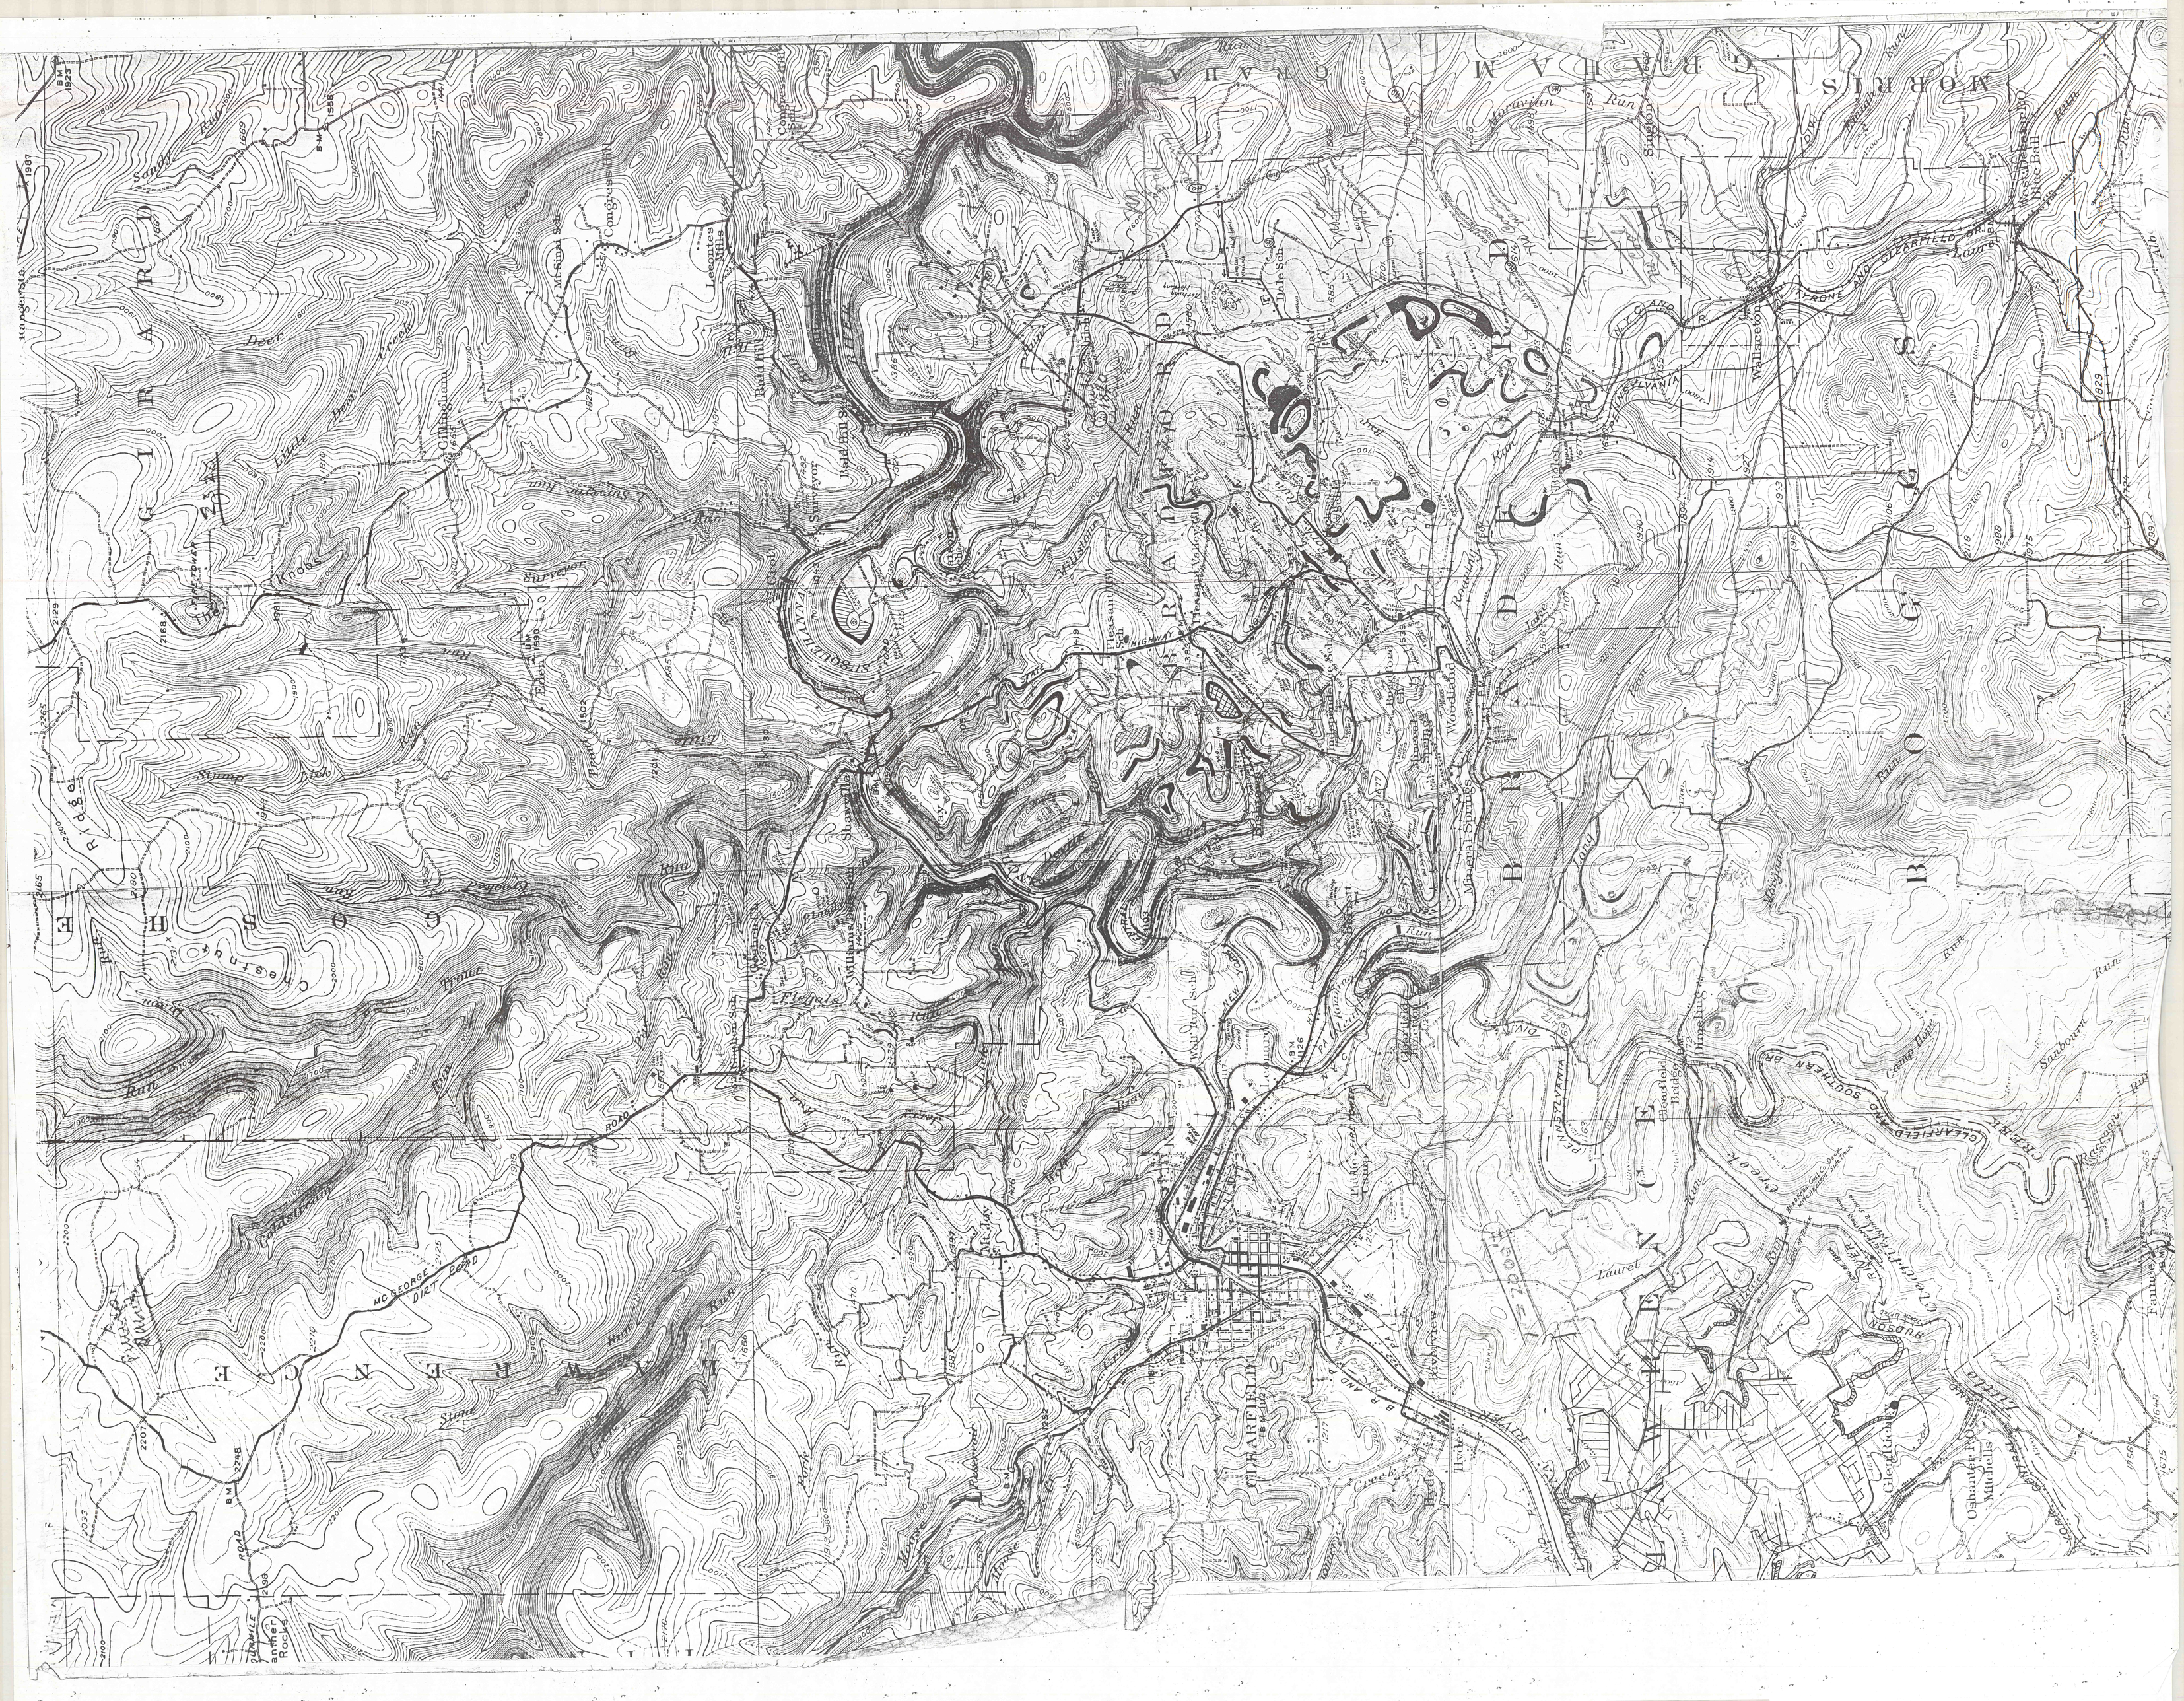

G I R A R D
G O S H E N
L A W R E N C E
B R A D F O R D
B O G G S
M O R R I S
G R A H A M
CLEARFIELD
(B M 1112)
Panther Rocks
FOURMILE ROAD
BM 2248
2198
2207
2033
2234
Pine Run
Pine Ridge
Chestnut Ridge
Dixon Run
Trout Run
Crooked Run
Stone Run
Lick Run
Fork Run
Moose Run
Moose Cr
Reservoir
MC GEORGE DIRT ROAD
ROAD
1939
1593
Goshen Sch
Goshen Ch
Williams Dale Sch
Shawville
Gray
Mt Joy
Kerr
Wolf Run
Wolf Run Sch
Leonard
Barrett
Public Camp
FIRE TOWER
Clearfield Junction
Hyde
Riverview
Mineral Springs
Woodland
Bradford Ch
Independence Sch
Jackson Sch
Pleasant Hill Sch
Pleasant Valley Ch
Bigler
Dale Sch
Dale Ch
Shiloh
Watson Sch
Croft
Surveyor
Surveyor Run
Little Surveyor Run
Bald Hill
Bald Hill Sta
Bald Hill Run
Lecontes Mills
Congress Hill
Congress Hill Sch
Mt Sinai Sch
Gillingham
Eden
BM 1590
The Knobs
FIRE TOWER
2322
Little Deer Creek
Deer Creek
Sandy Run
Ranger Sta
BM 1923
BM 1558
SUSQUEHANNA RIVER
FORD
Millstone Run
Roaring Run
Torrey Run
Valley Fork
Lake Run
Long Run
Morgan Run
Laurel Run
Wallace Run
Moravian Run
Emigh Run
Alder Run
Camp Hope Run
Sanbourn Run
Raccoon Run
Clearfield Creek
Little Clearfield Creek
Clearfield Bridge
Dimeling
Glen Richey
Oshanter P.O.
Mitchells
Faunce
Wallaceton
Singion
West Decatur P.O.
Blue Ball
Summit Hill Ch
Center Hill Ch
NEW YORK CENTRAL
PENNSYLVANIA
N.Y.C. AND R.R.
B R AND P
NYC AND HUDSON RIVER
CLEARFIELD AND SOUTHERN BR.
TYRONE AND CLEARFIELD BR.
PA DIV.
U.S. 322
PA HY
STATE HIGHWAY
GRAY HAMPTON ROAD
OLD MILESBURG PIKE
DIRT ROAD
1"=2000'
No Coal
No Coal Measures
1820
Woolridge Strip
Carson Active Strip
John Graham
Em Brown Tipple
Ryan Bros Tipple
Walker Tipple
Bradford Coal Co Dock
Mitchells Side Track
End of Track
Track Lifted
Outdoor Theatre
Cemetery
John English
John Gearhart
Mrs Clark Gearhart
Harry Gearhart
D. English
E. Mains
Hoover
Kline
Houser
Theodore Wallace
Jury Tract
Kesh Shirey
Graffius
Sam Lansbery
Fred Dixon
Rod Johnson
Glascow Tract
Croft Mine
Cook Mine
Lester Owens
J. Dixon
Luzier
Kolbe