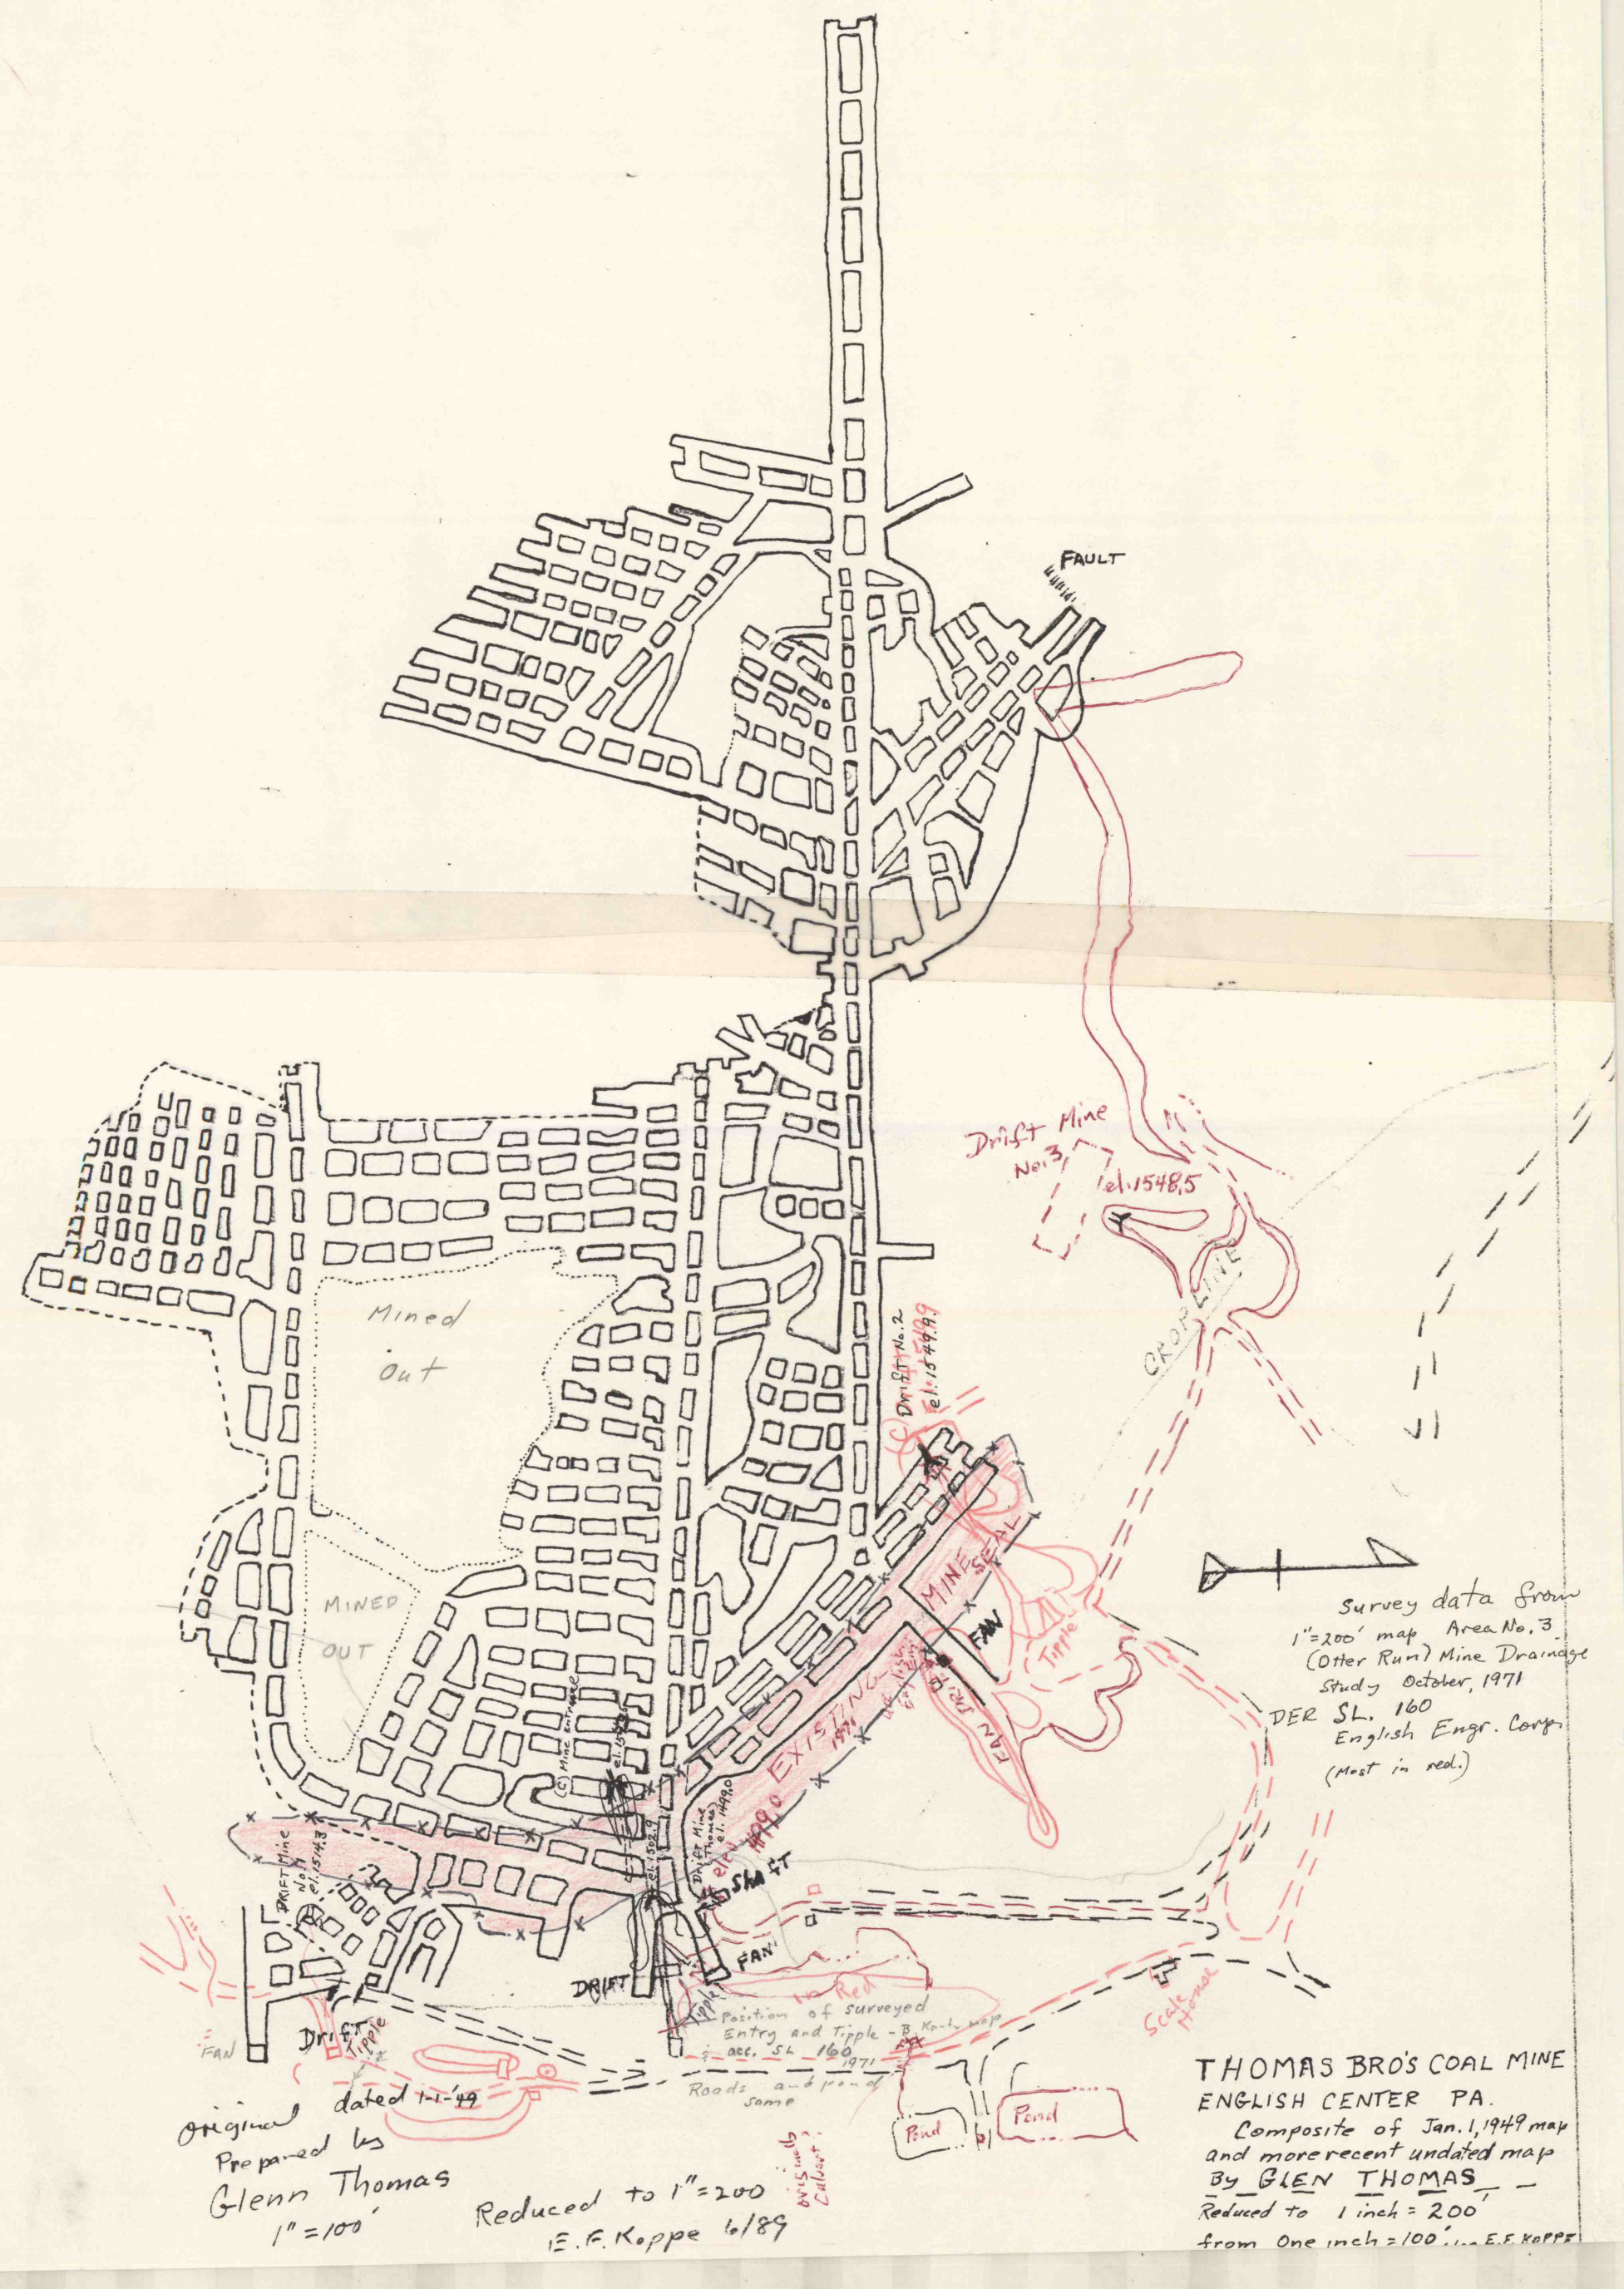
FAULT
Drift Mine No. 3
el. 1548.5
CROP LINE
Mined Out
MINED OUT
Drift No. 2
el. 1549.9
MINE SEAL
FAN
Tipple
EXISTING
SHAFT
FAN
DRIFT
Drift Mine No. 1 el. 1514.3
Drift Mine (Thomas) el. 1499.0
Position of surveyed Entry and Tipple - B. Kantz map & acc. SL 160 1971
Roads and pond same
Pond
Pond
Scale House
Survey data from 1"=200' map Area No. 3 (Otter Run) Mine Drainage Study October, 1971
DER SL. 160
English Engr. Corp.
(Most in red.)
original dated 1-1-'49
Prepared by
Glenn Thomas
1"=100'
Reduced to 1"=200
E.F. Koppe 6/89
originally Calvert?
THOMAS BRO'S COAL MINE
ENGLISH CENTER PA.
Composite of Jan. 1, 1949 map and more recent undated map
By GLEN THOMAS
Reduced to 1 inch = 200'
from One inch = 100' ... E.F. KOPPE