


9183
37.9

9183
37.9

Water depth	TD
1-1 34.5'	65'
1-2 58.8'	65'
1-3 30.5'	49'
0-1 N.D.	99'
0-2 ND	98'
0-3 ND	92'
0-4 ND	90'
0-5 174'	99.5'
0-6 101' - noted 102-108' TD	
0-7 60' - 106'	
0-8 45' - 84.5'	
0-9 (81' dry) * drilled 94'	
0-10 (80' dry) * drilled 90'	

Location
Circle

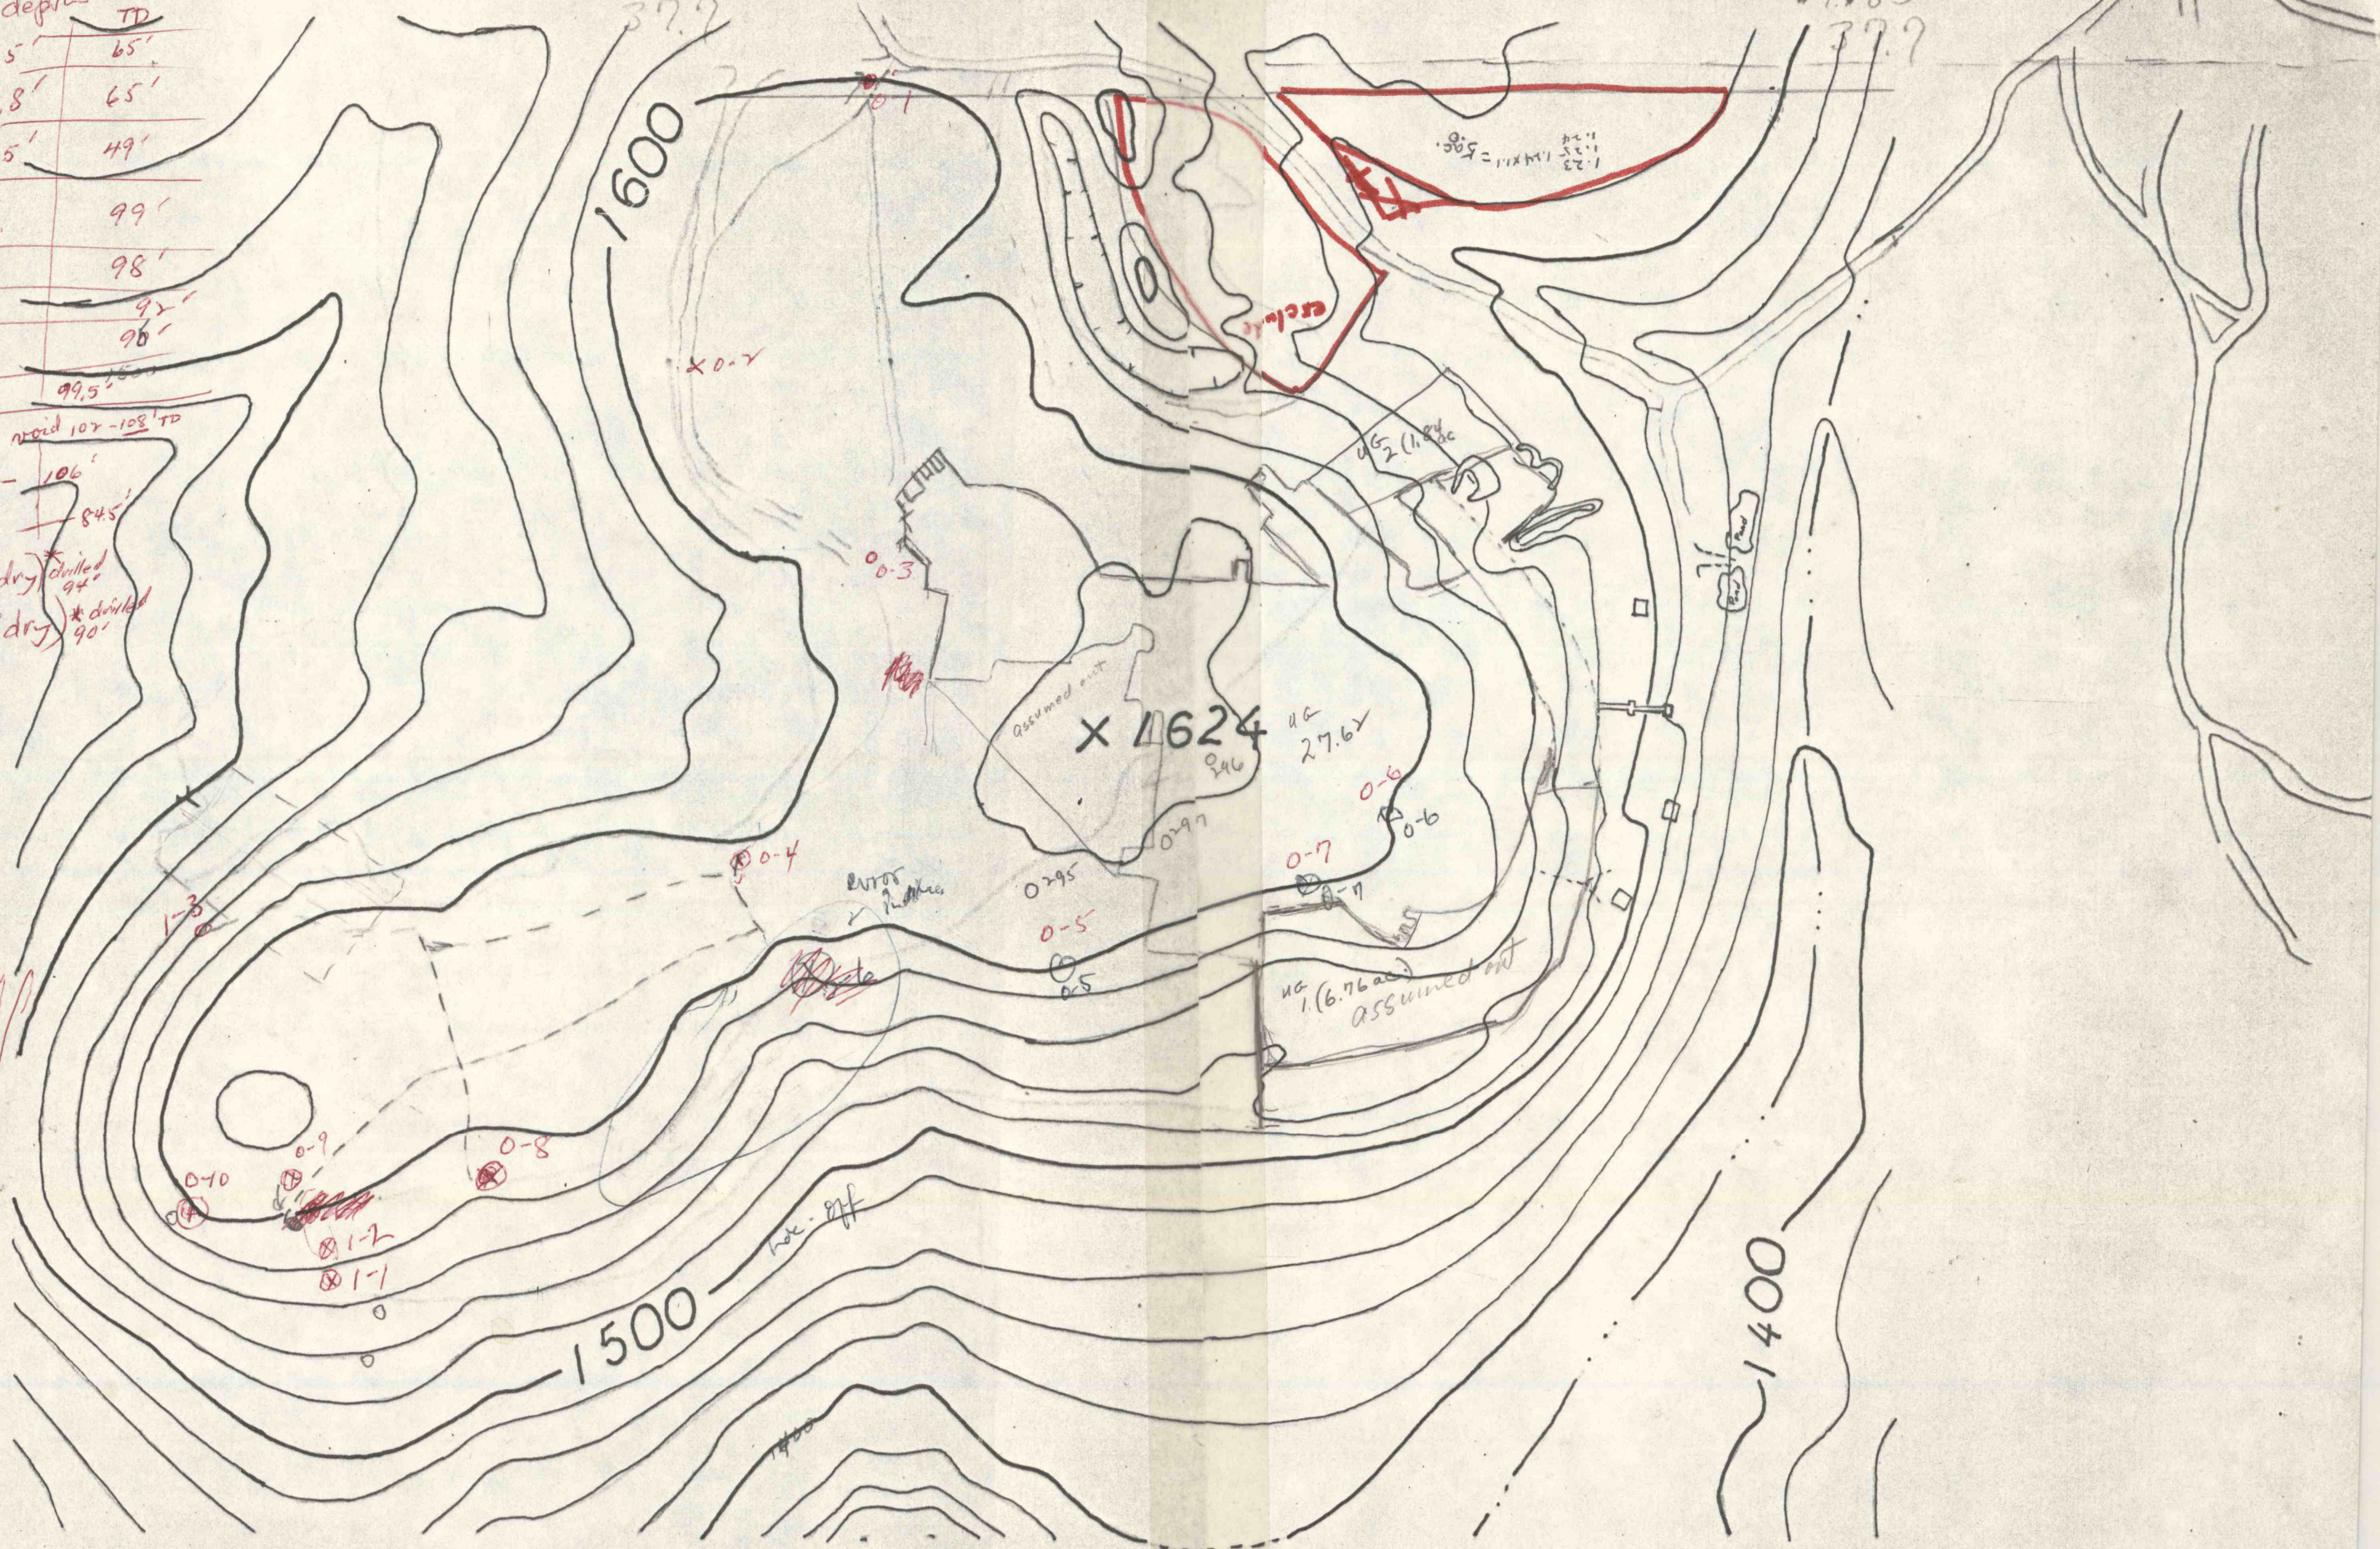

Water depths
11-27-85
9.18