


24,000

24,000

1800  
410  
AIR Camp Comm. Parking

AIR Camp Comm. Parking

A  
416-419

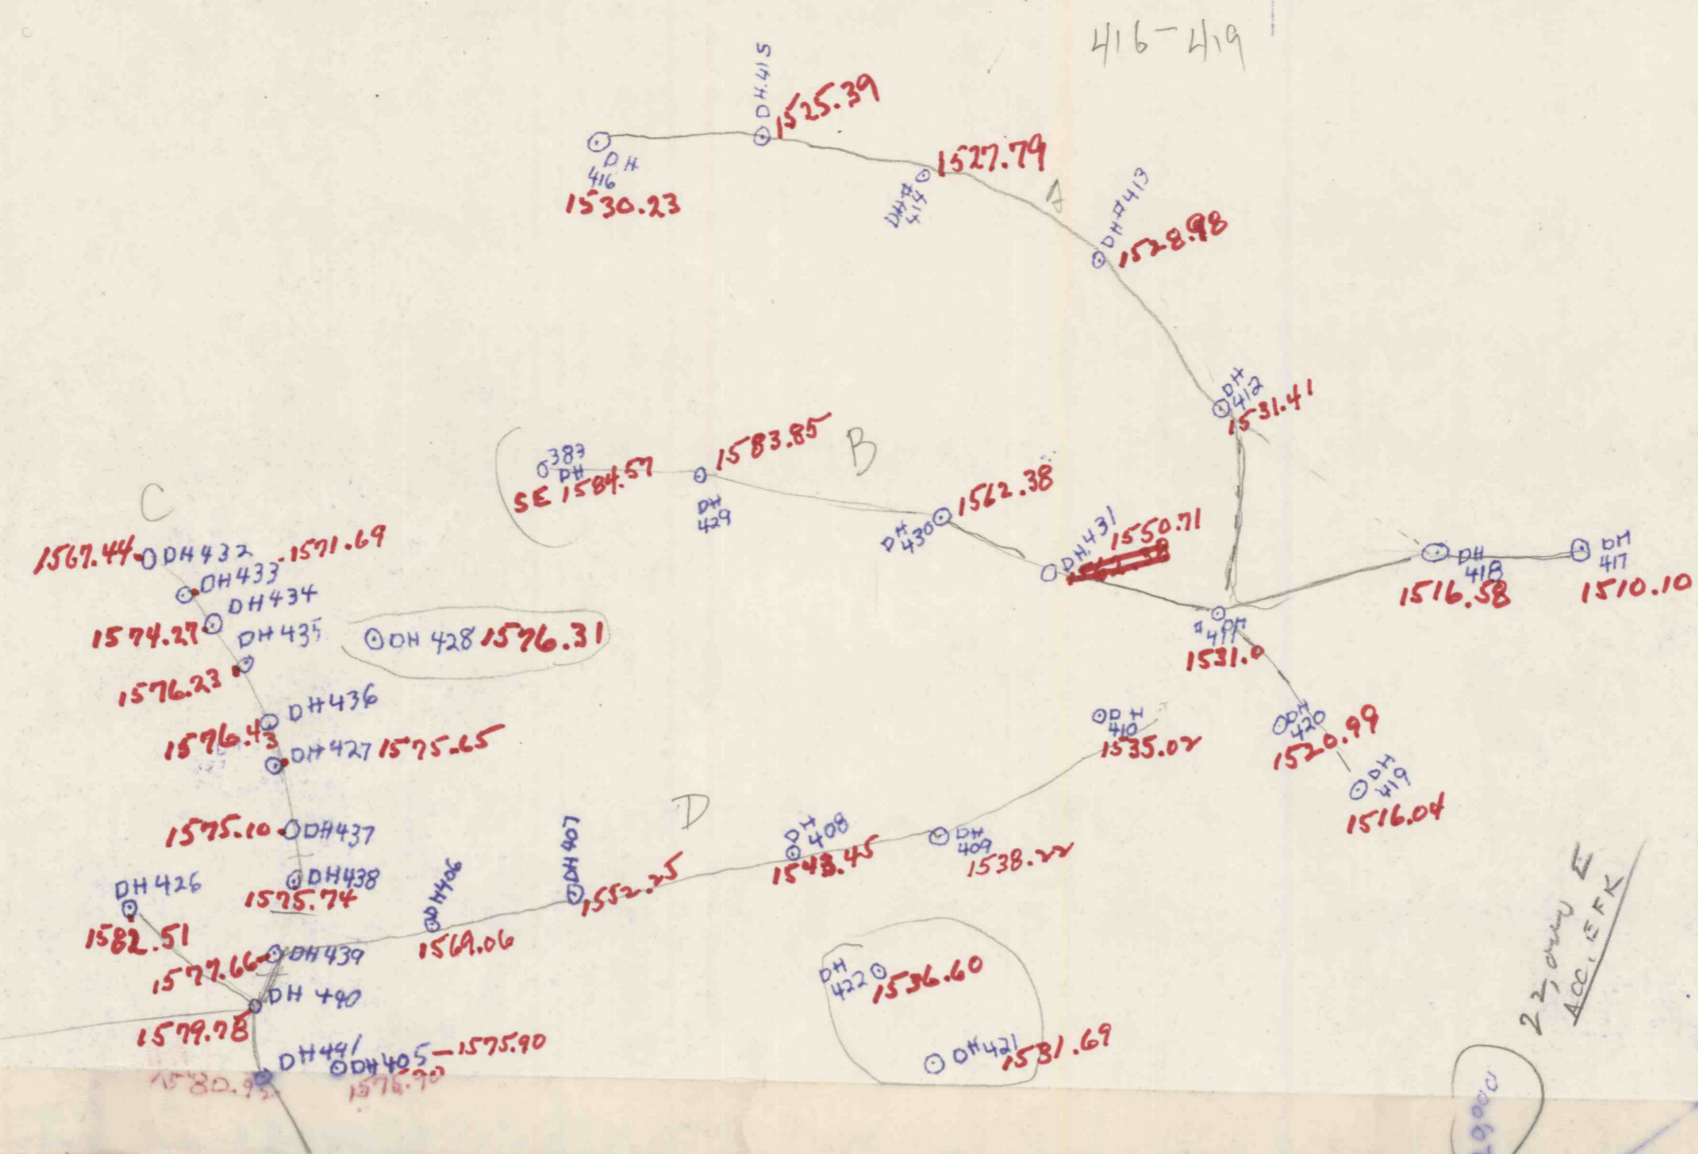

Paved Haul Road

Game Commission Road

N

22,000

IR 1882 A

IR 1883

SE 1640.5

SE 1638.73

383-1574.57

