

GREEN GLEN SUR.
J. S. REITZ EST. MIN.

GREEN GLEN SUR.
J. S. REITZ EST. MIN.


GREEN GLEN SUR.
J. E. DUBOIS EST. MIN.
LOWER FREEPORT COAL

GREEN GLEN SUR.
J. S. REITZ EST. MIN.

GREEN GLEN SUR.
J. S. REITZ EST. MIN.

Legend:

- Lower Freeport Coal Removed by Deep Mine.
- Lower Freeport Coal Removed by Strip Mine.
- Fault Area.
- Lower Freeport Coal in place.

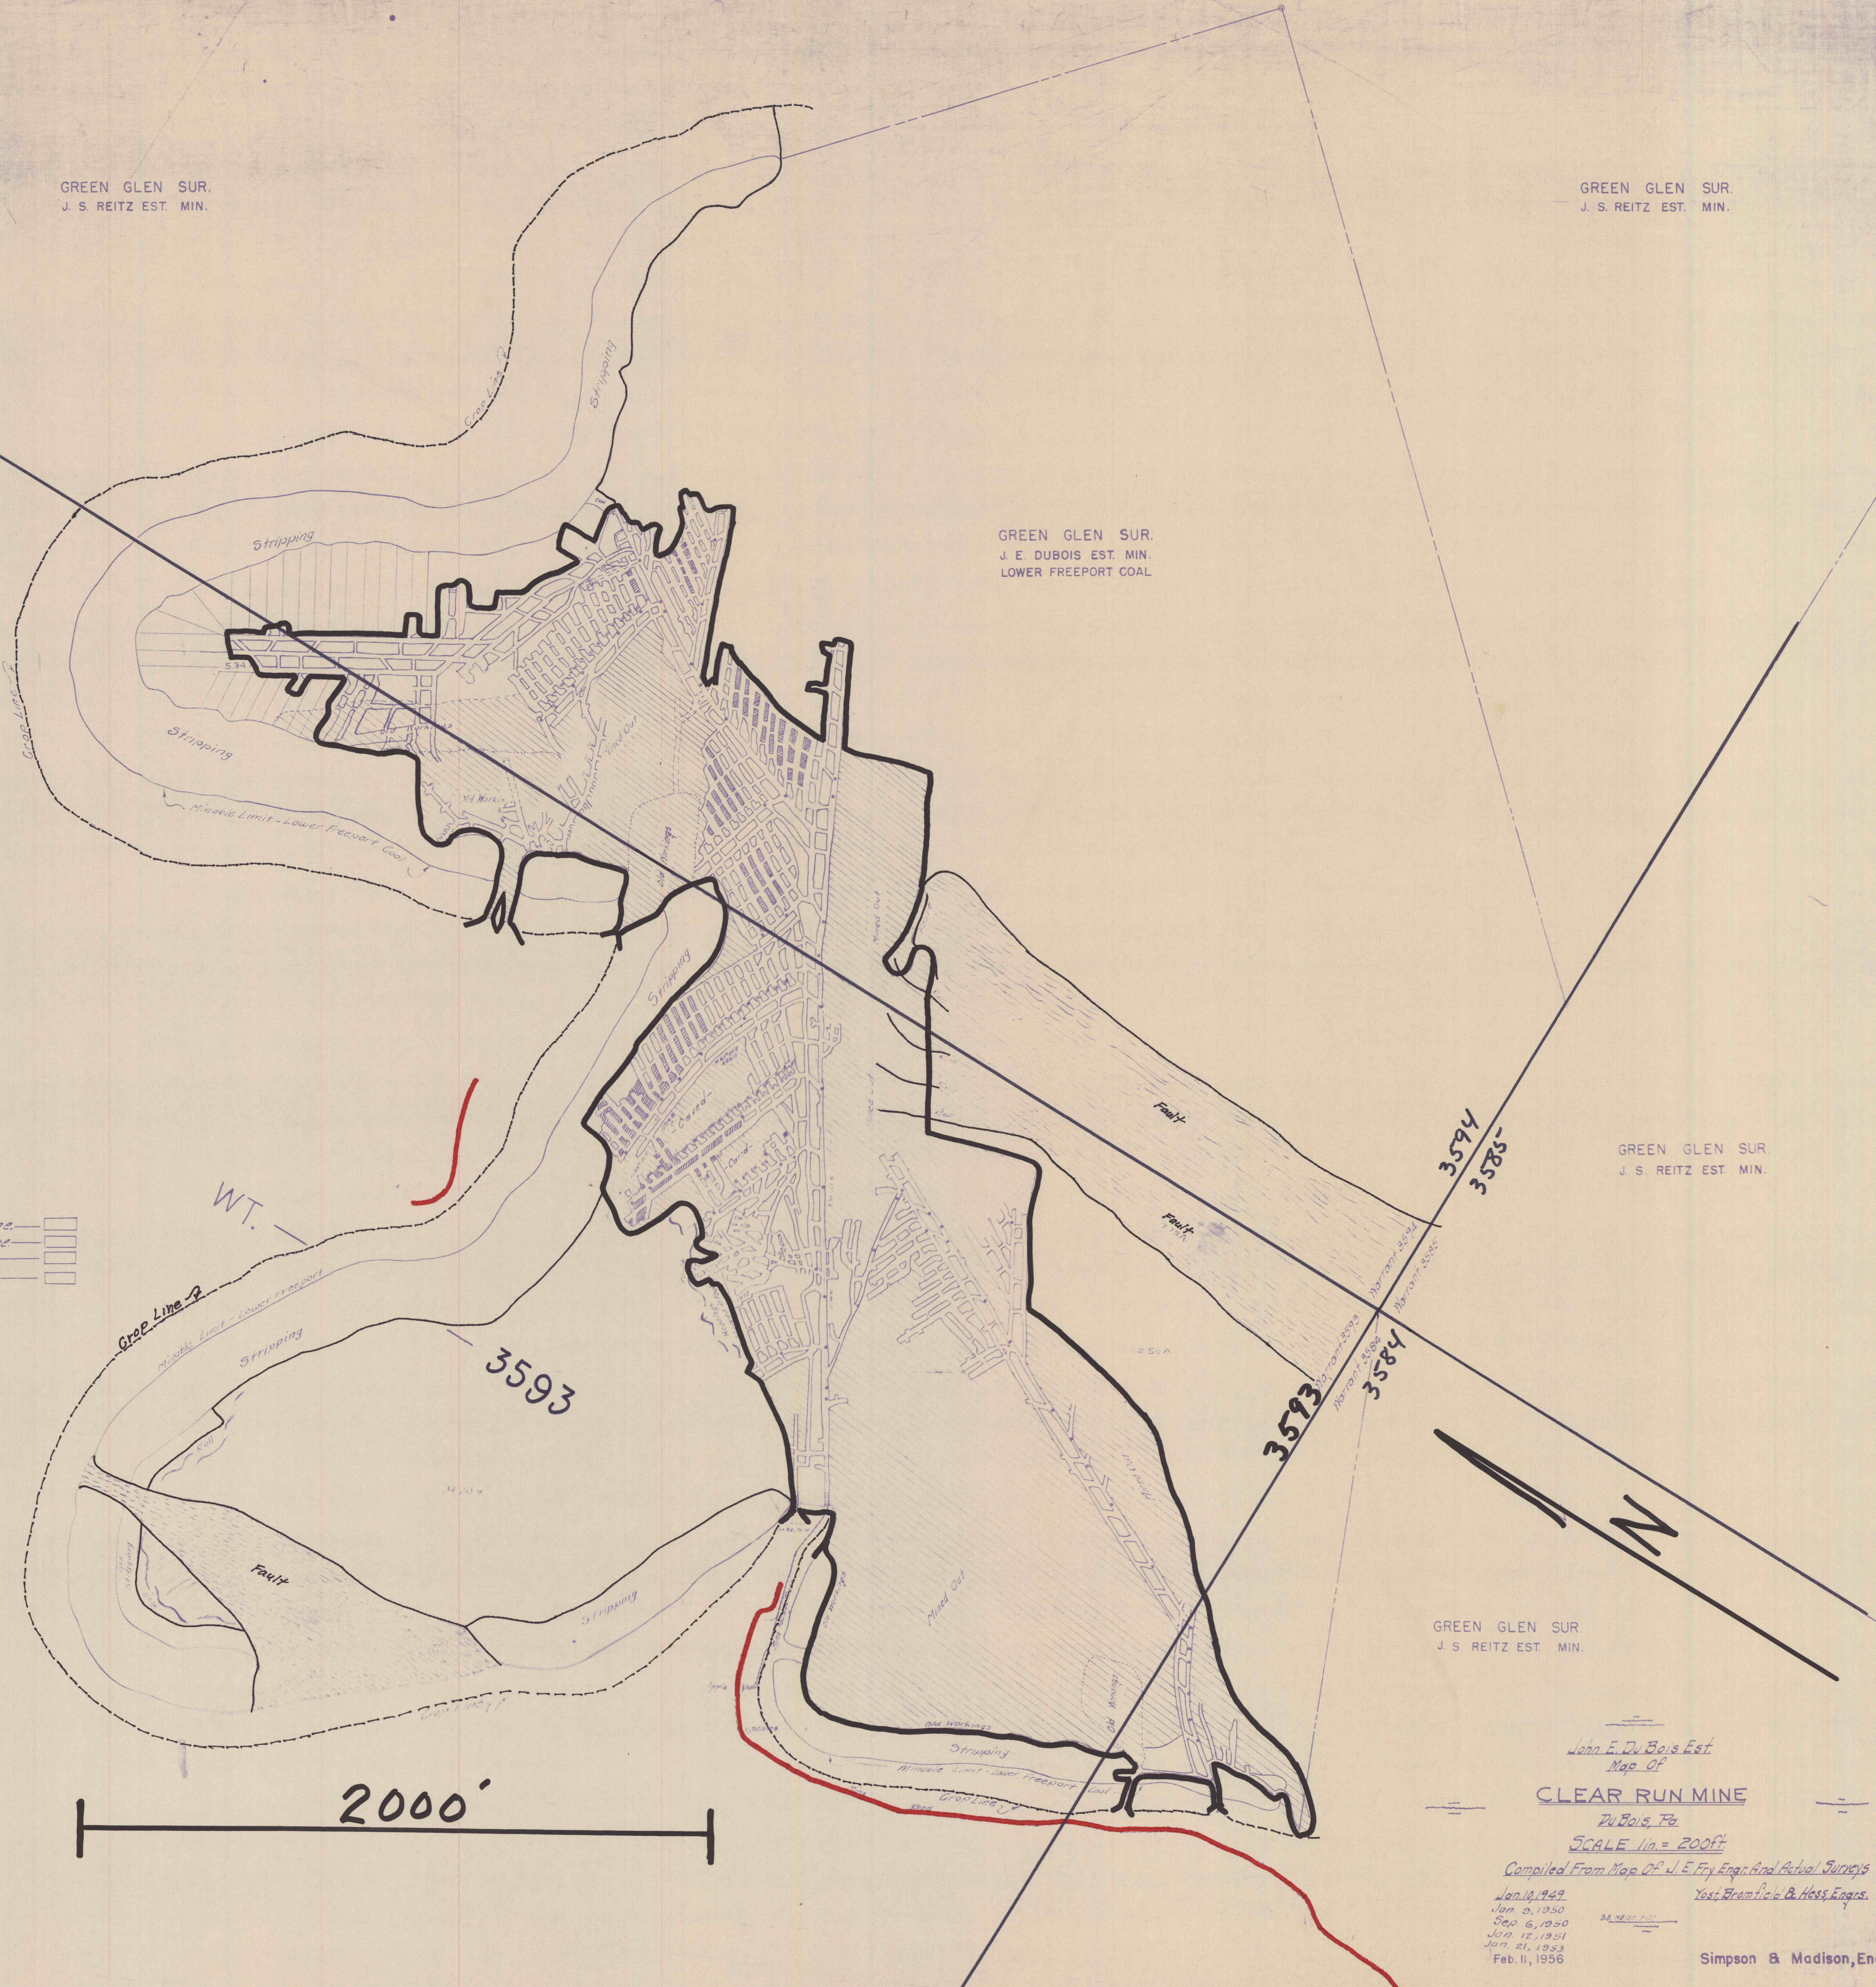

WT.

Cree Line #2

3593

3593

3594
3583-

3584

N

2000'

John E. Du Bois Est.
Map of

CLEAR RUN MINE

Du Bois, Pa.

SCALE 1 in. = 200 ft.

Compiled From Map of J. E. Fry, Engr. and Actual Surveys

Jan. 10, 1949
 Jan. 31, 1950
 Sep. 6, 1950
 Jan. 12, 1951
 Jan. 21, 1953
 Feb. 11, 1956

Simpson & Madison, Engrs.

To Du Bois

50
50
50